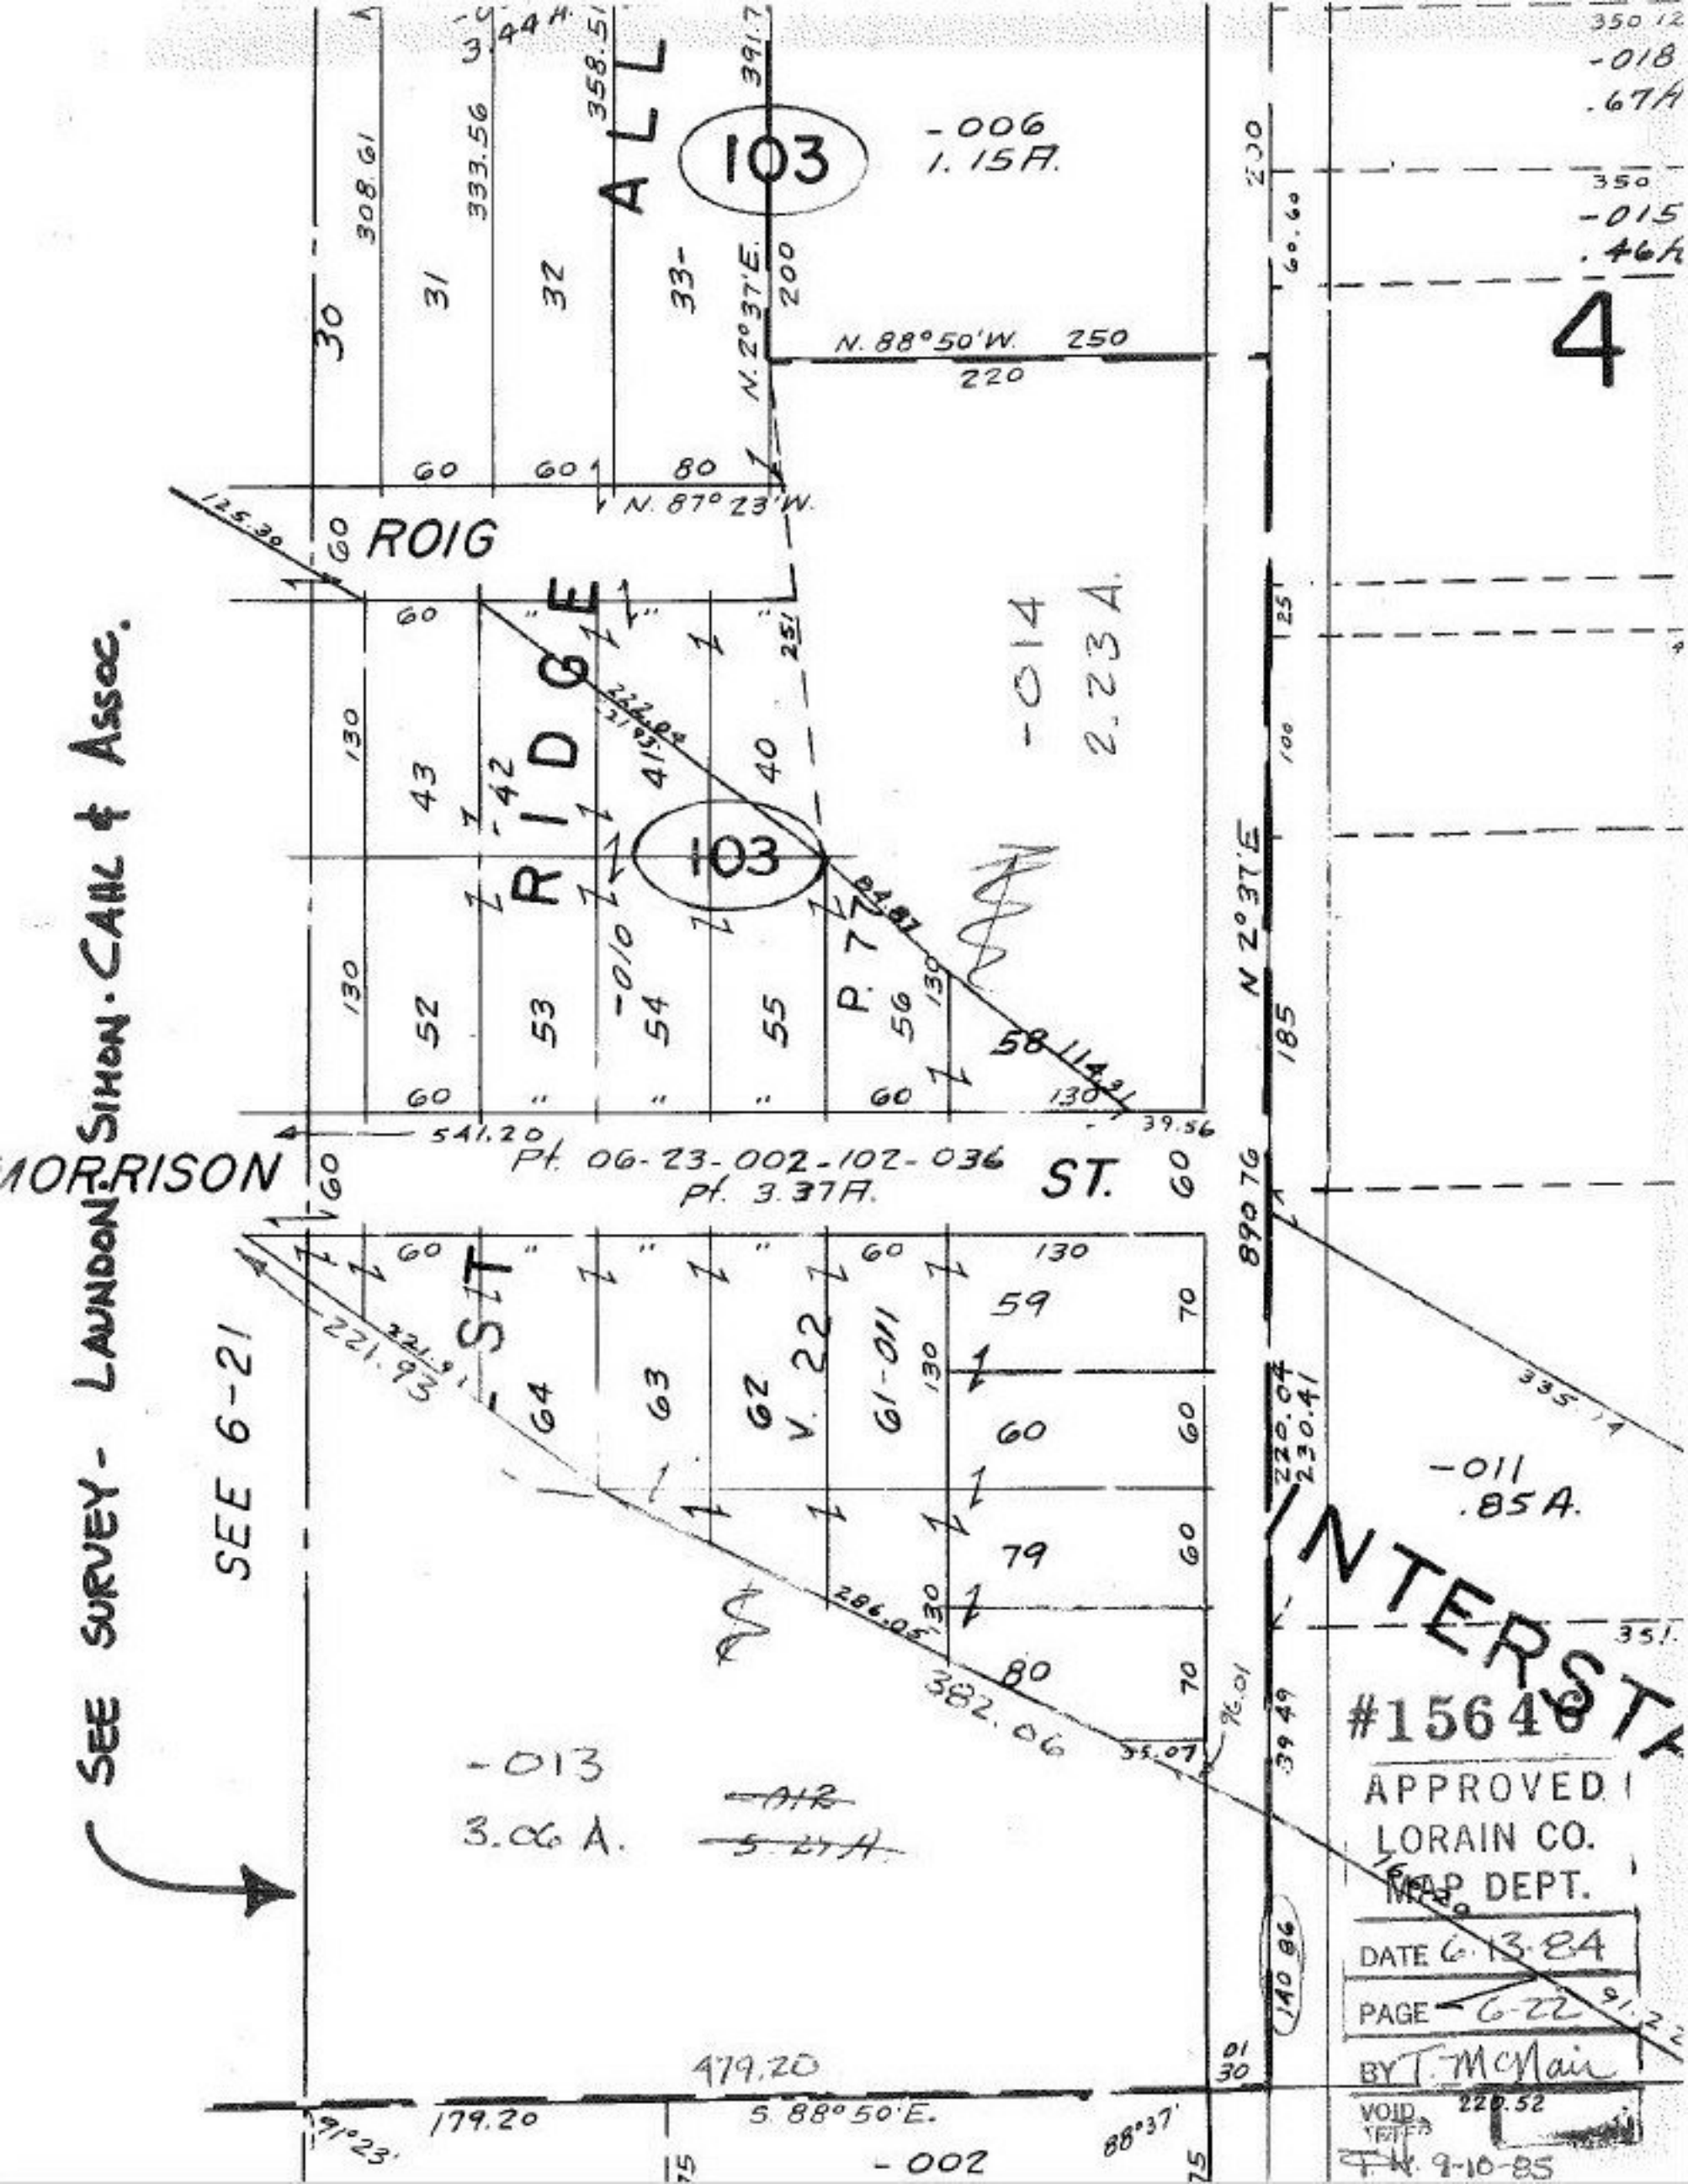
SEE SURVEY - LAUNDON, SIHON, CALL & ASSOC.
SEE 6-21
MORRISON
ROIG
RIDGE
ALL
ST.
ST.
AVE
INTERSTATE
#15640
APPROVED
LORAIN CO.
MAP DEPT.
DATE 6-13-84
PAGE 6-22
BY T. McNair
VOID
-006
1.15A.
-014
2.23A.
-011
.85A.
-013
3.06 A.
-010
-002
Pt. 06-23-002-102-036
pt. 3.37A.
541.20
479.20
179.20
S. 88°50'E.
N. 88°50'W.
N. 2°37'E.
N. 87°23'W.
N 2°37'E
103
103
V. 22
4
E.T. 9-10-85