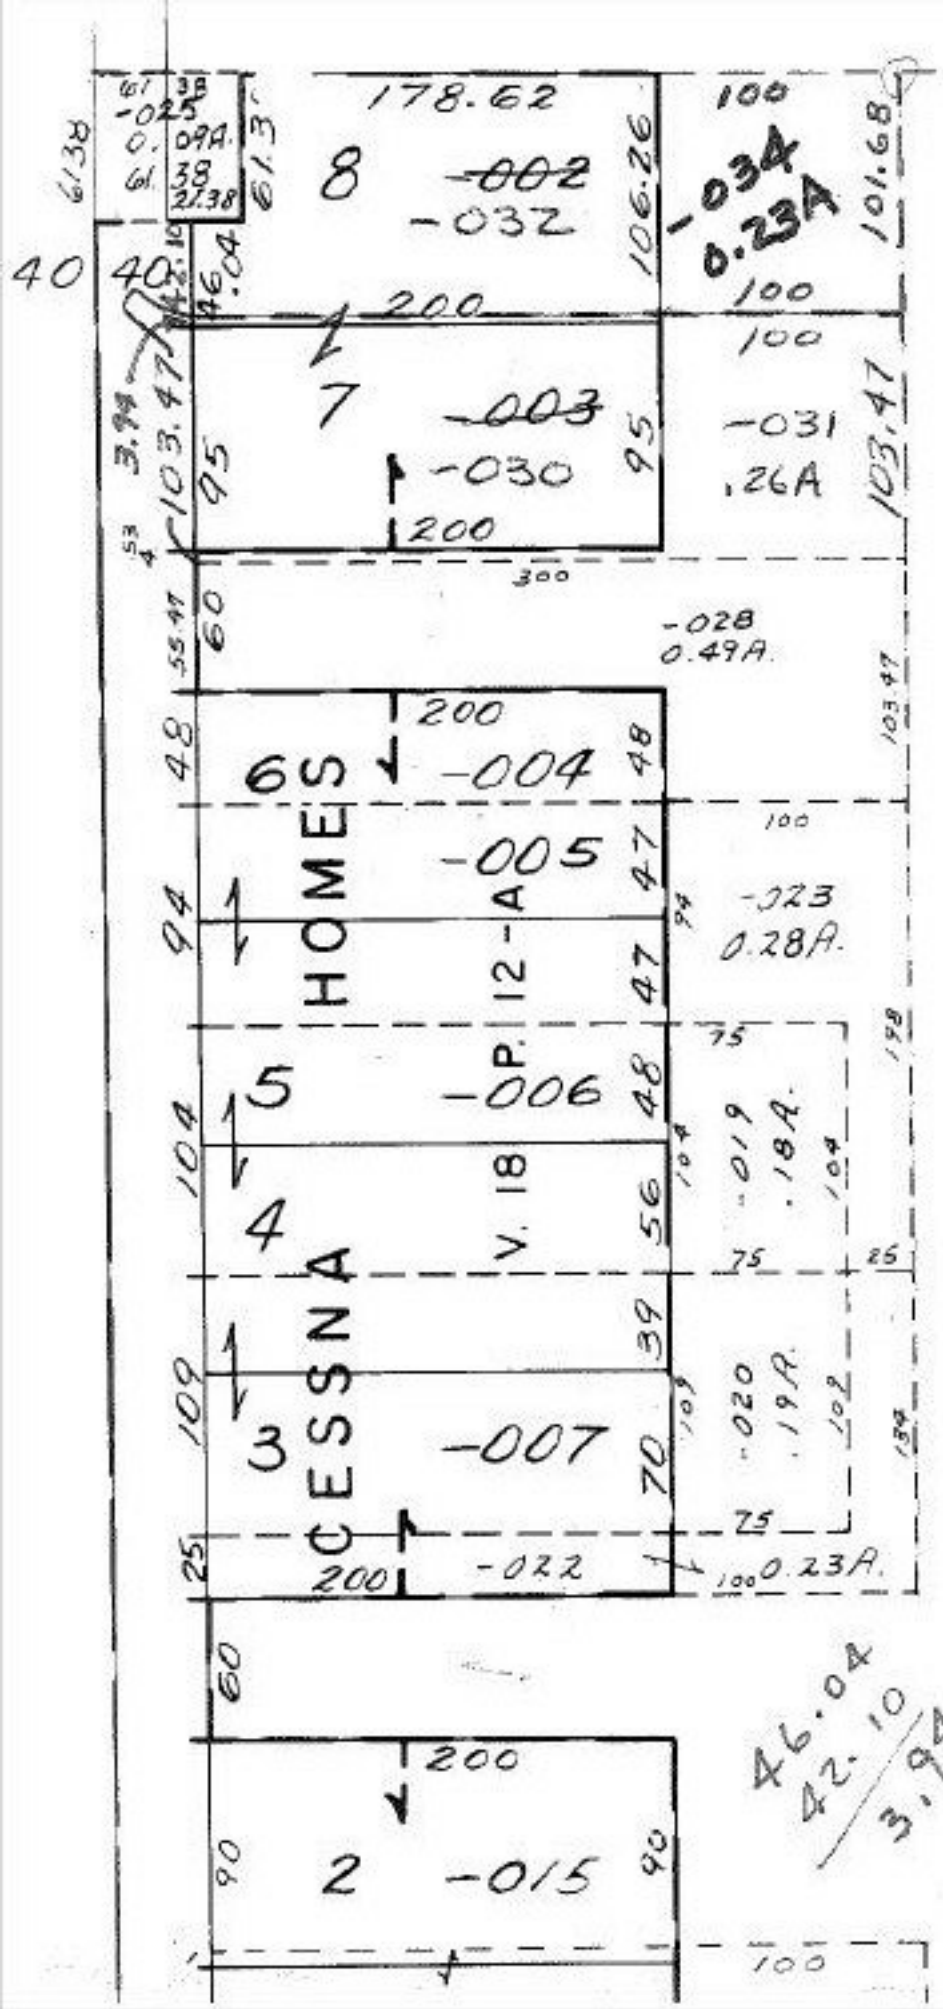

15568

#15654

APPROVED
LORAIN CO.
MAP DEPT.
DATE 6-22-84
PAGE 11-00-048 A
BY [signature]
VOID AFTER 15654

J.G. 8-8-84

-035
~~-029~~ ~~033~~
23.84 A. ~~28.58 A.~~
~~28.35~~ A.
23.35A.

[redacted] PARCEL #1 CLOSES

PARCEL #2
0.011080 805.16
-0.017854