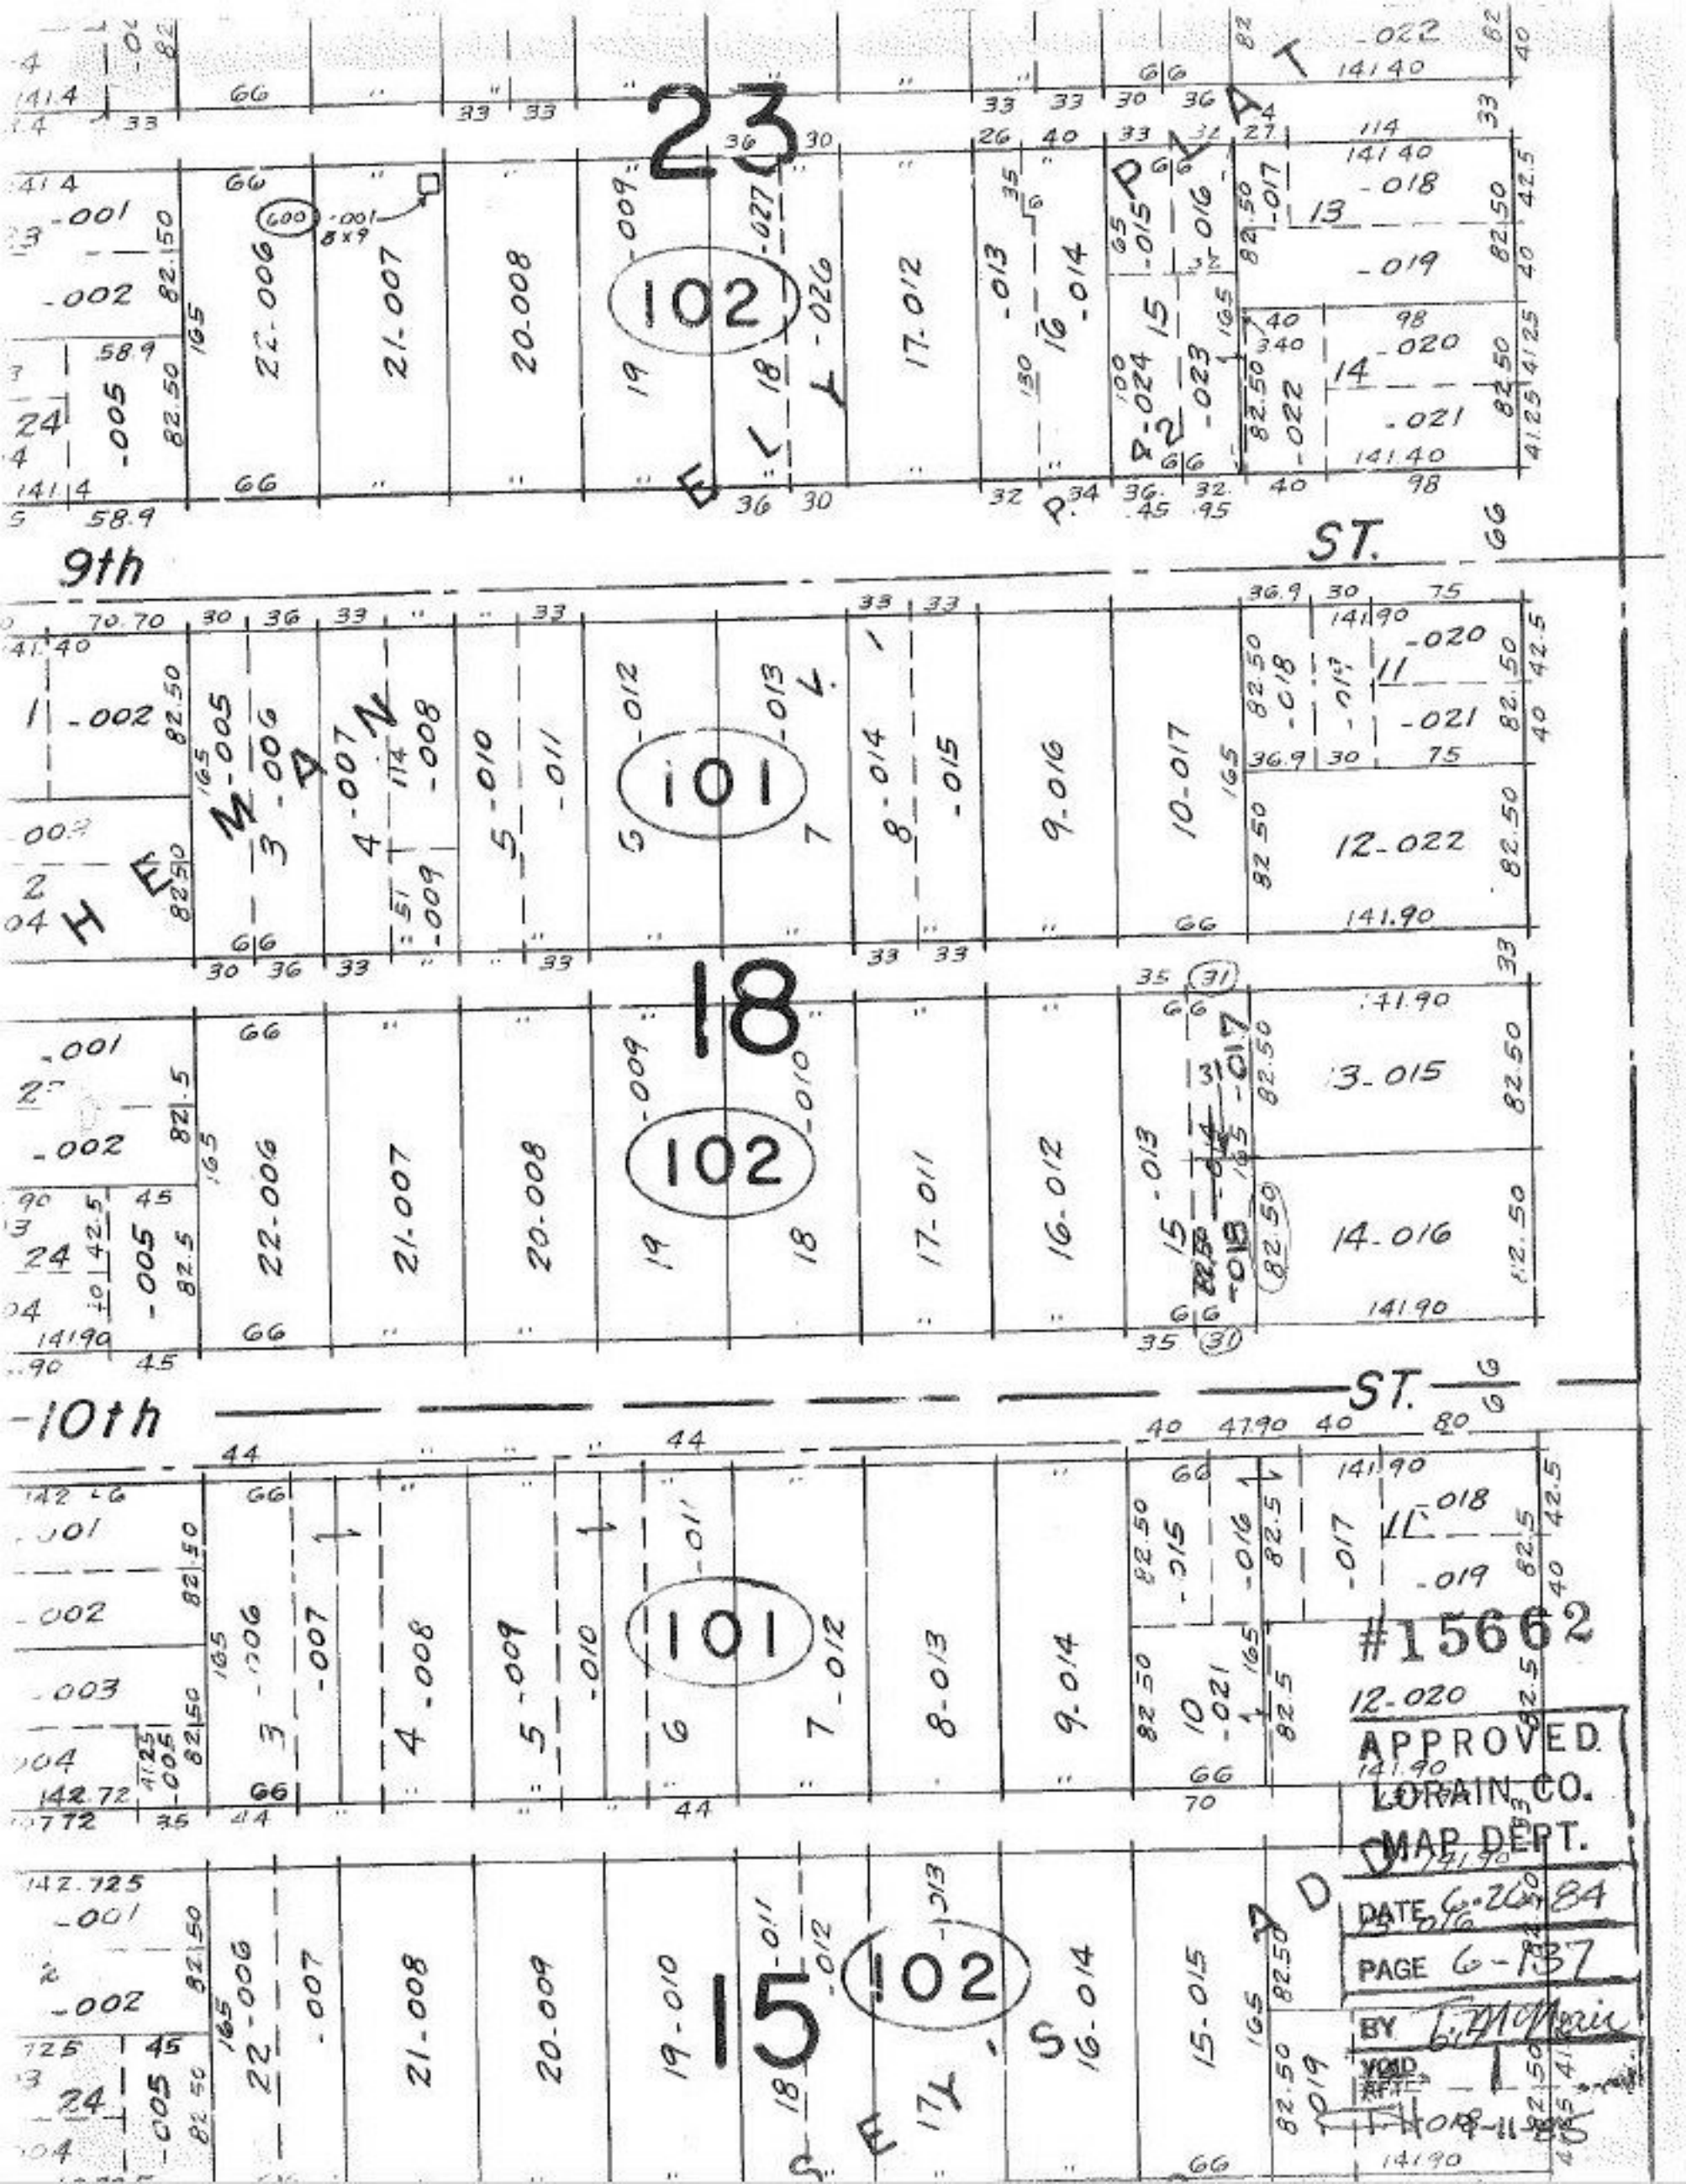
9th ST.
10th ST.
23
102
18
101
15
102
HEMAN AVE.
ADD
#15662
12-020
APPROVED
LORAIN CO.
MAP DEPT.
DATE 6-26-84
PAGE 6-137
BY L.H.McMorris
VOID AFTER
NOV-11-84