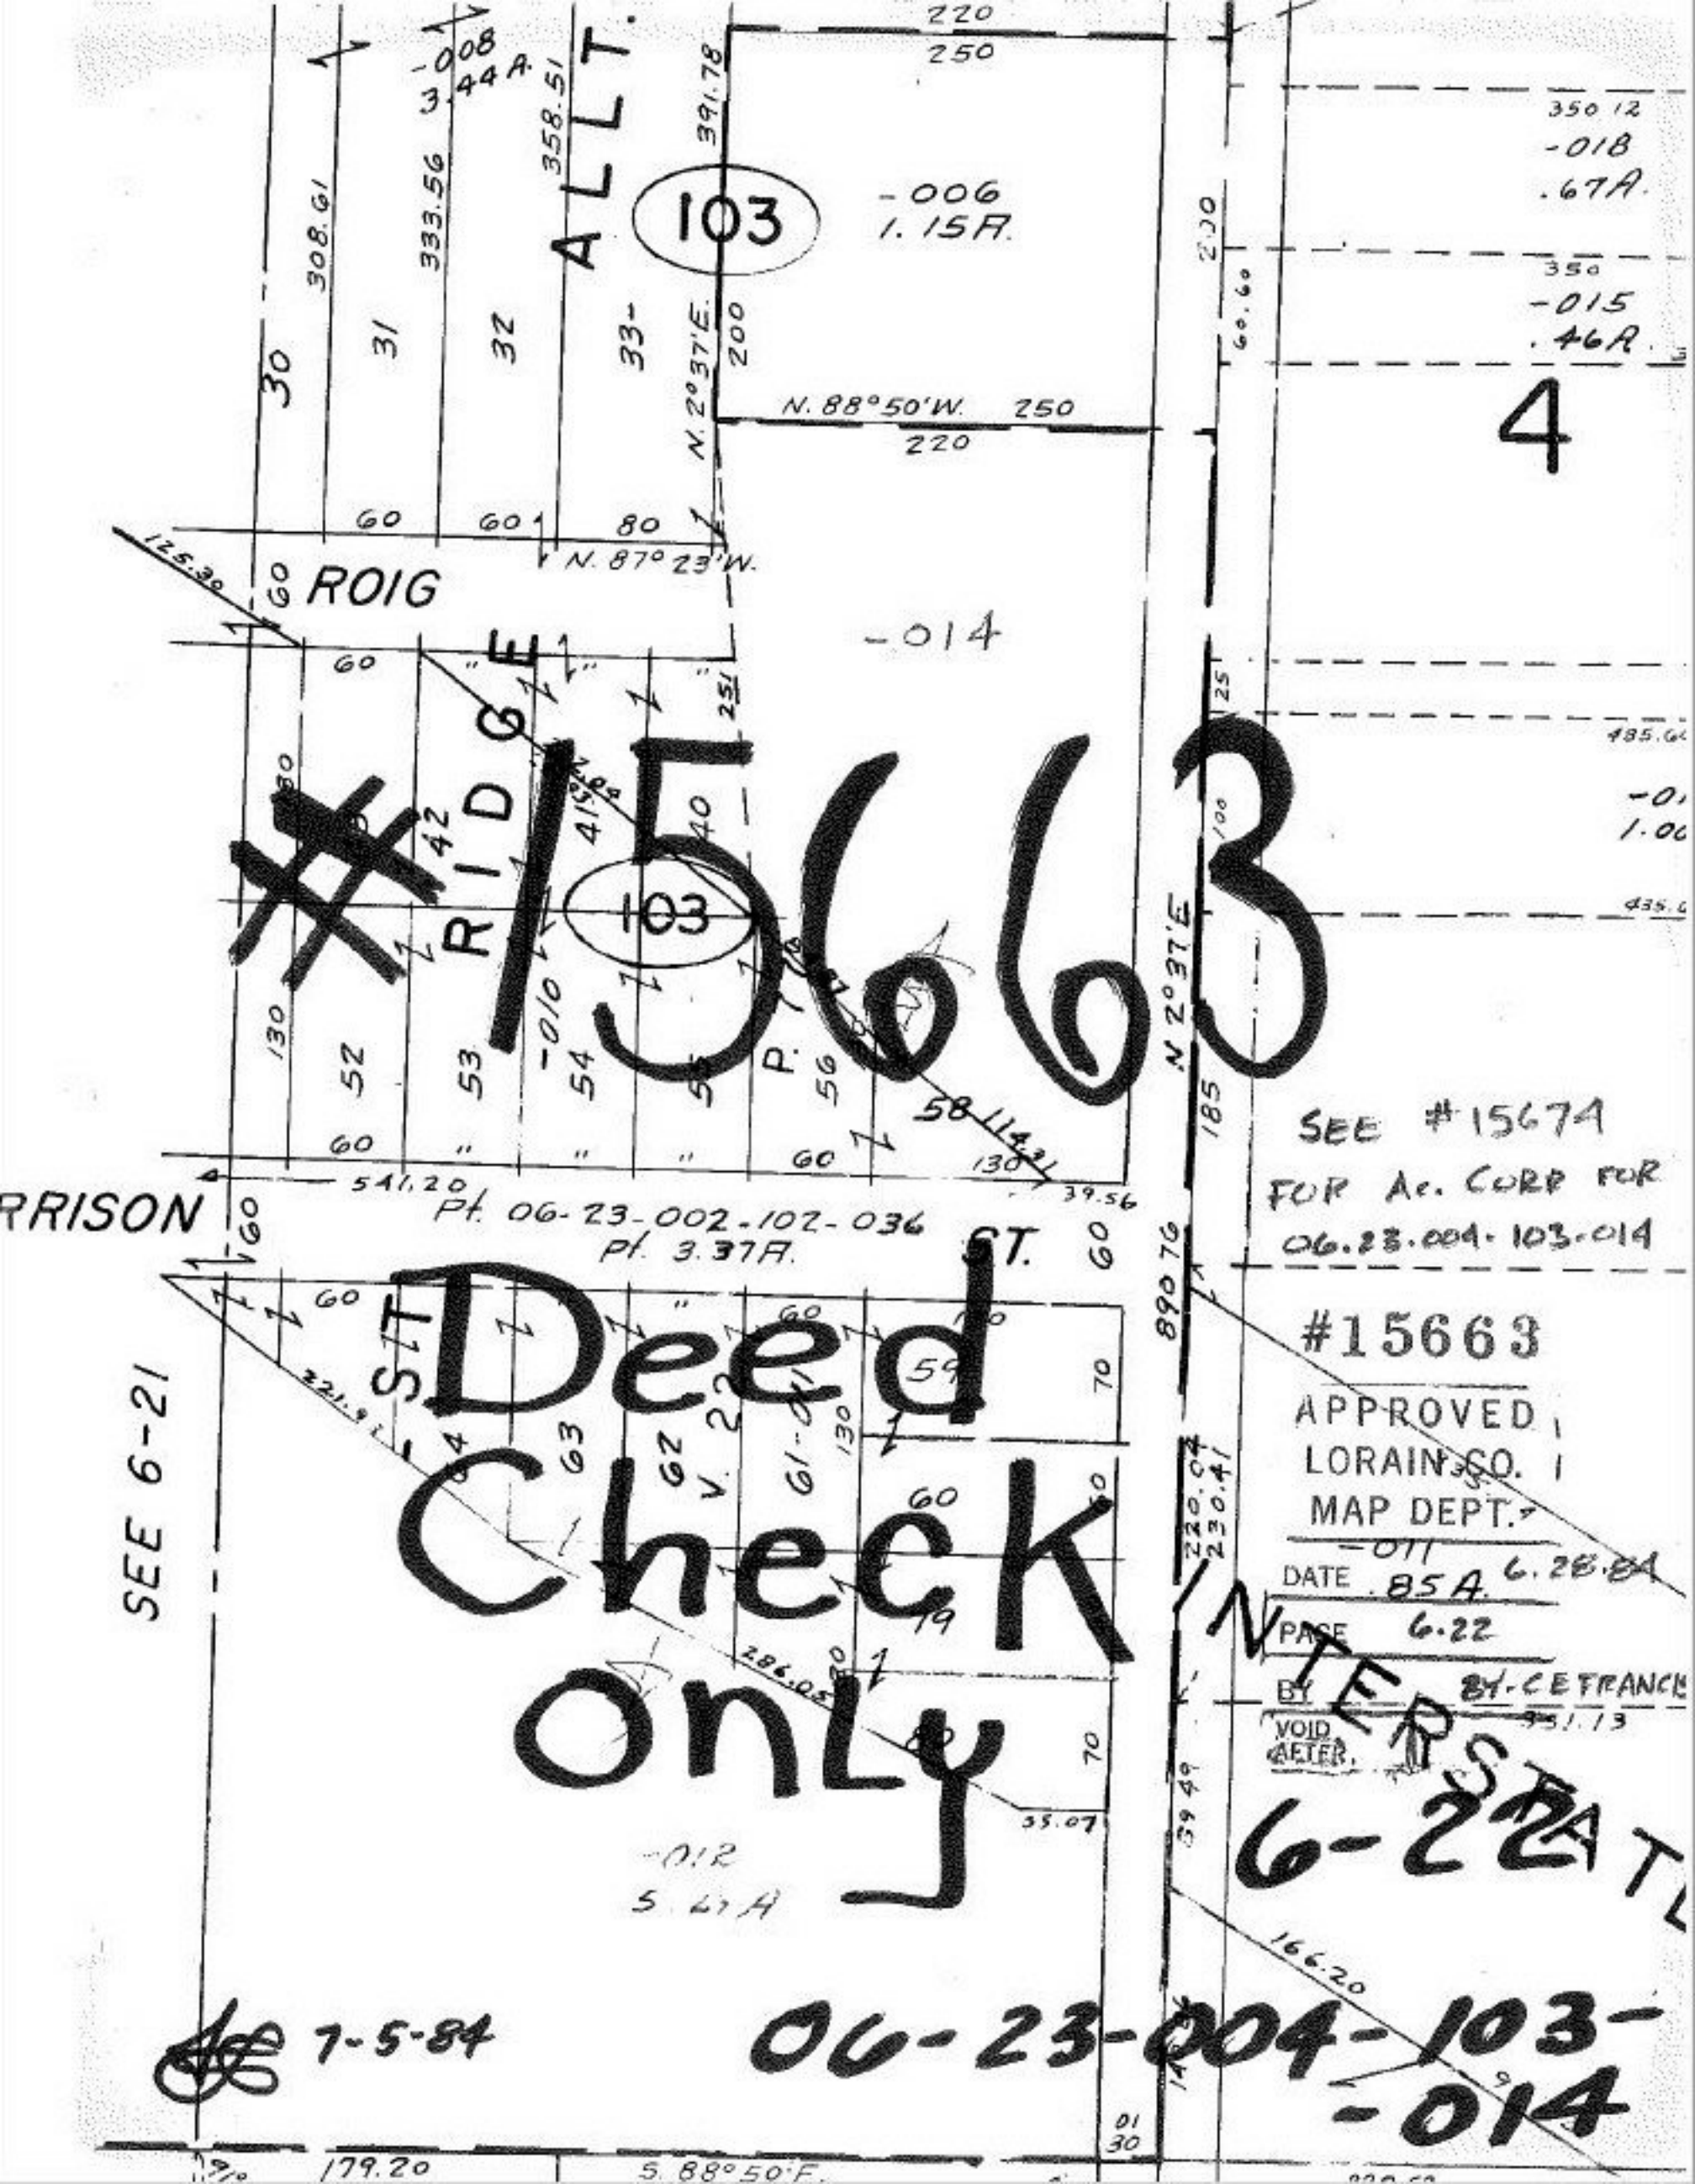

#15663
Deed Check Only
ALLT.
103
-006
1.15A.
-008
3.44A.
-018
.67A.
-015
.46A.
4
N. 88°50'W.
N. 87°23'W.
N. 2°37'E.
ROIG
-014
RIDGE
103
-010
SEE #15674
FOR Ac. CORR FOR
06.23.004-103-014
RRISON
Pt. 06-23-002-102-036
Pt. 3.37A.
ST.
SEE 6-21
#15663
APPROVED
LORAIN CO.
MAP DEPT.
DATE 85A. 6.28.84
PAGE 6.22
BY BY-CE FRANCIS
VOID AFTER
INTERSTATE
6-22
-012
5.67A
7-5-84
06-23-004-103-
-014