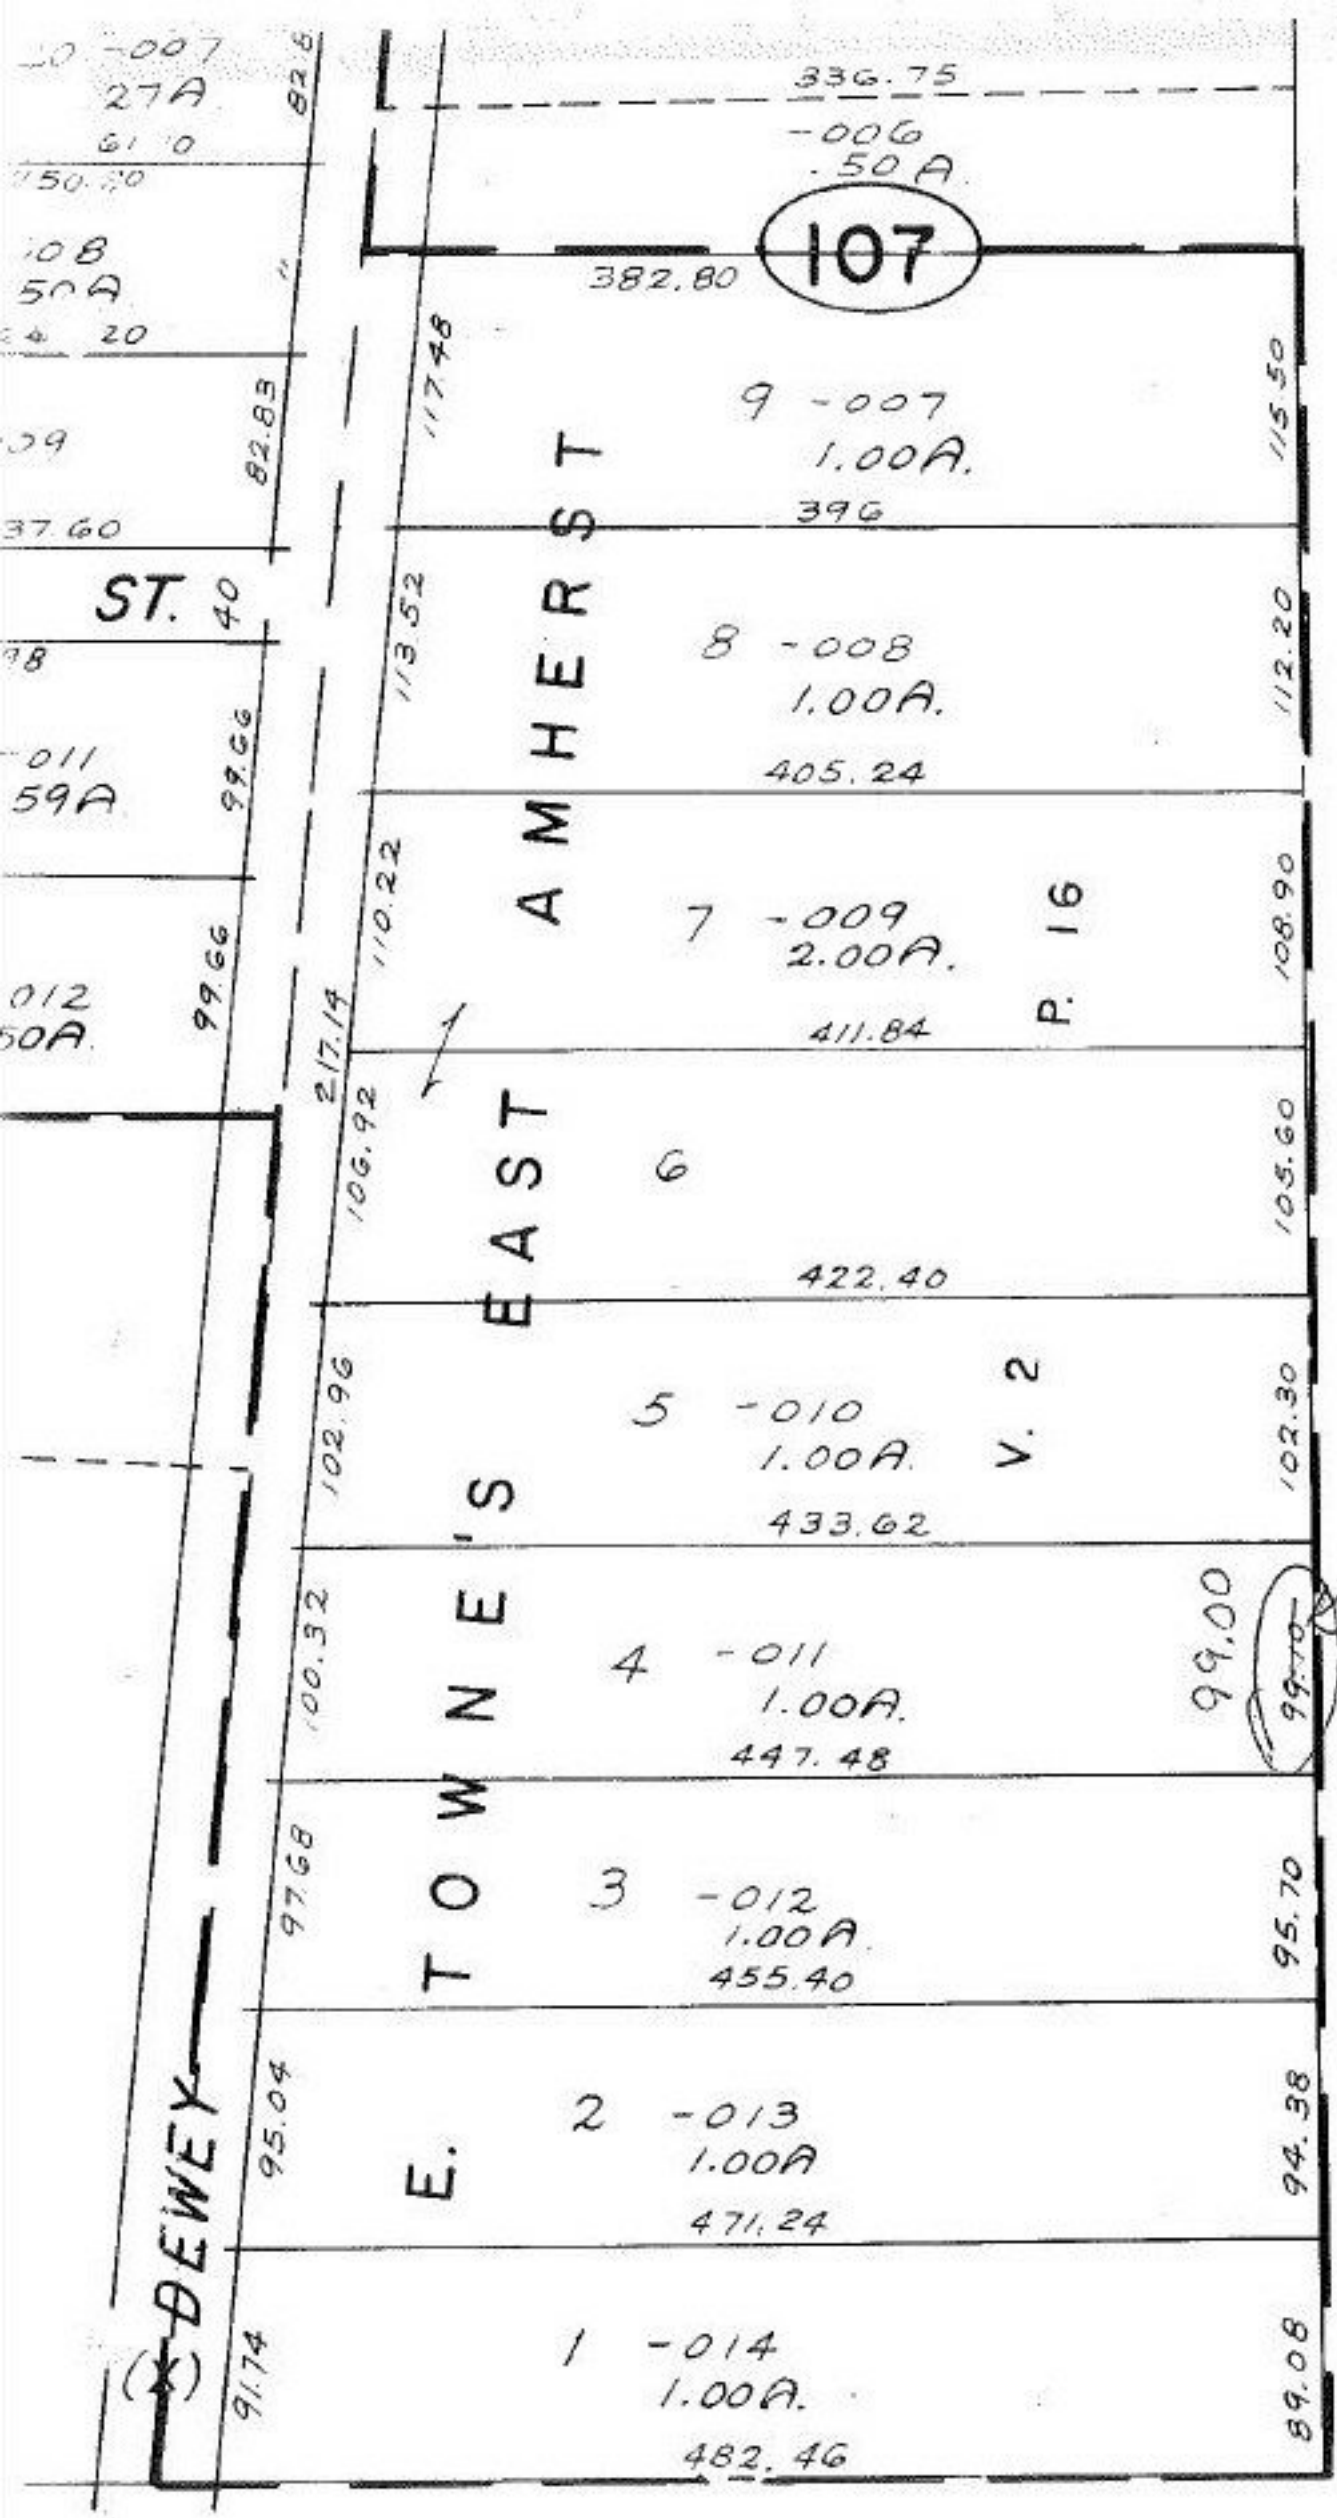

SIZE CORR. ONLY

Size Corr. by Lorain Co.

SEE PLAT V. 2 PG. 16 SL. 4

DEED V. 723 PG. 463

#15670

APPROVED
LORAIN CO.
MAP DEPT.
DATE 10-25-84
PAGE 5-00-042-B
BY C. Thomas
VOID AFTER

7.17.85
TH.