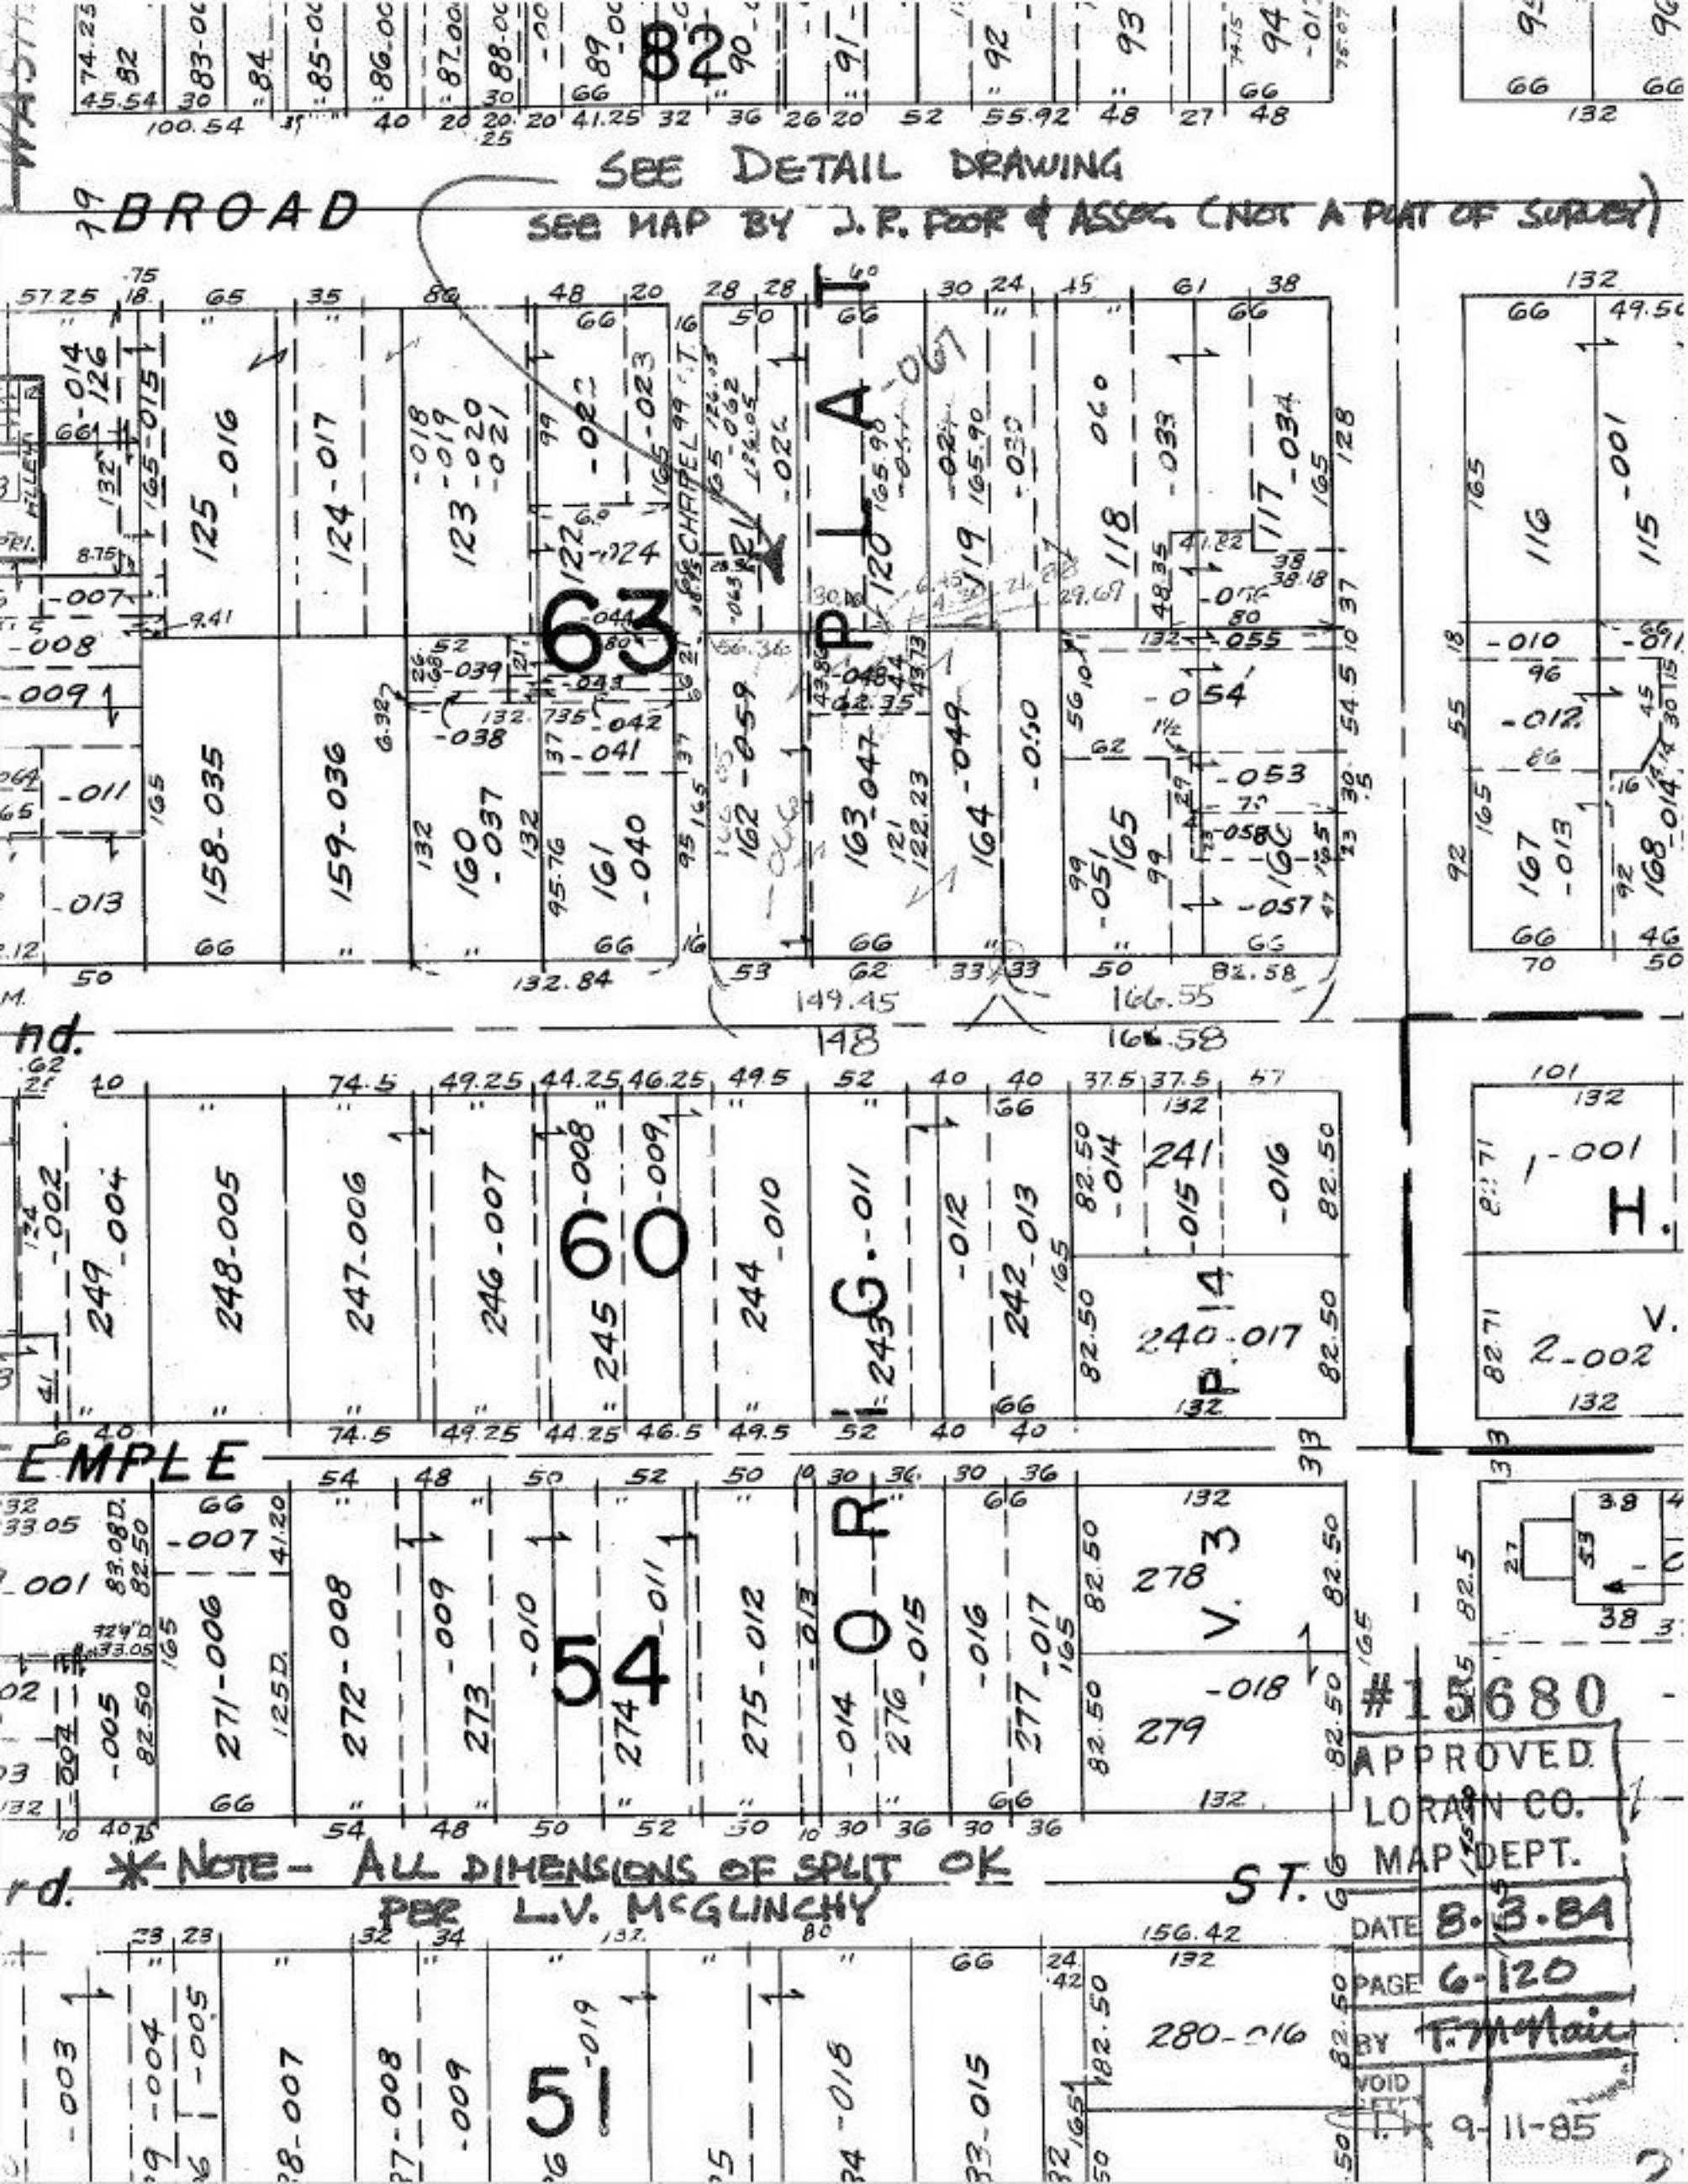

*NOTE - ALL DIMENSIONS OF SPLIT OK PER L.V. McGLINCHY