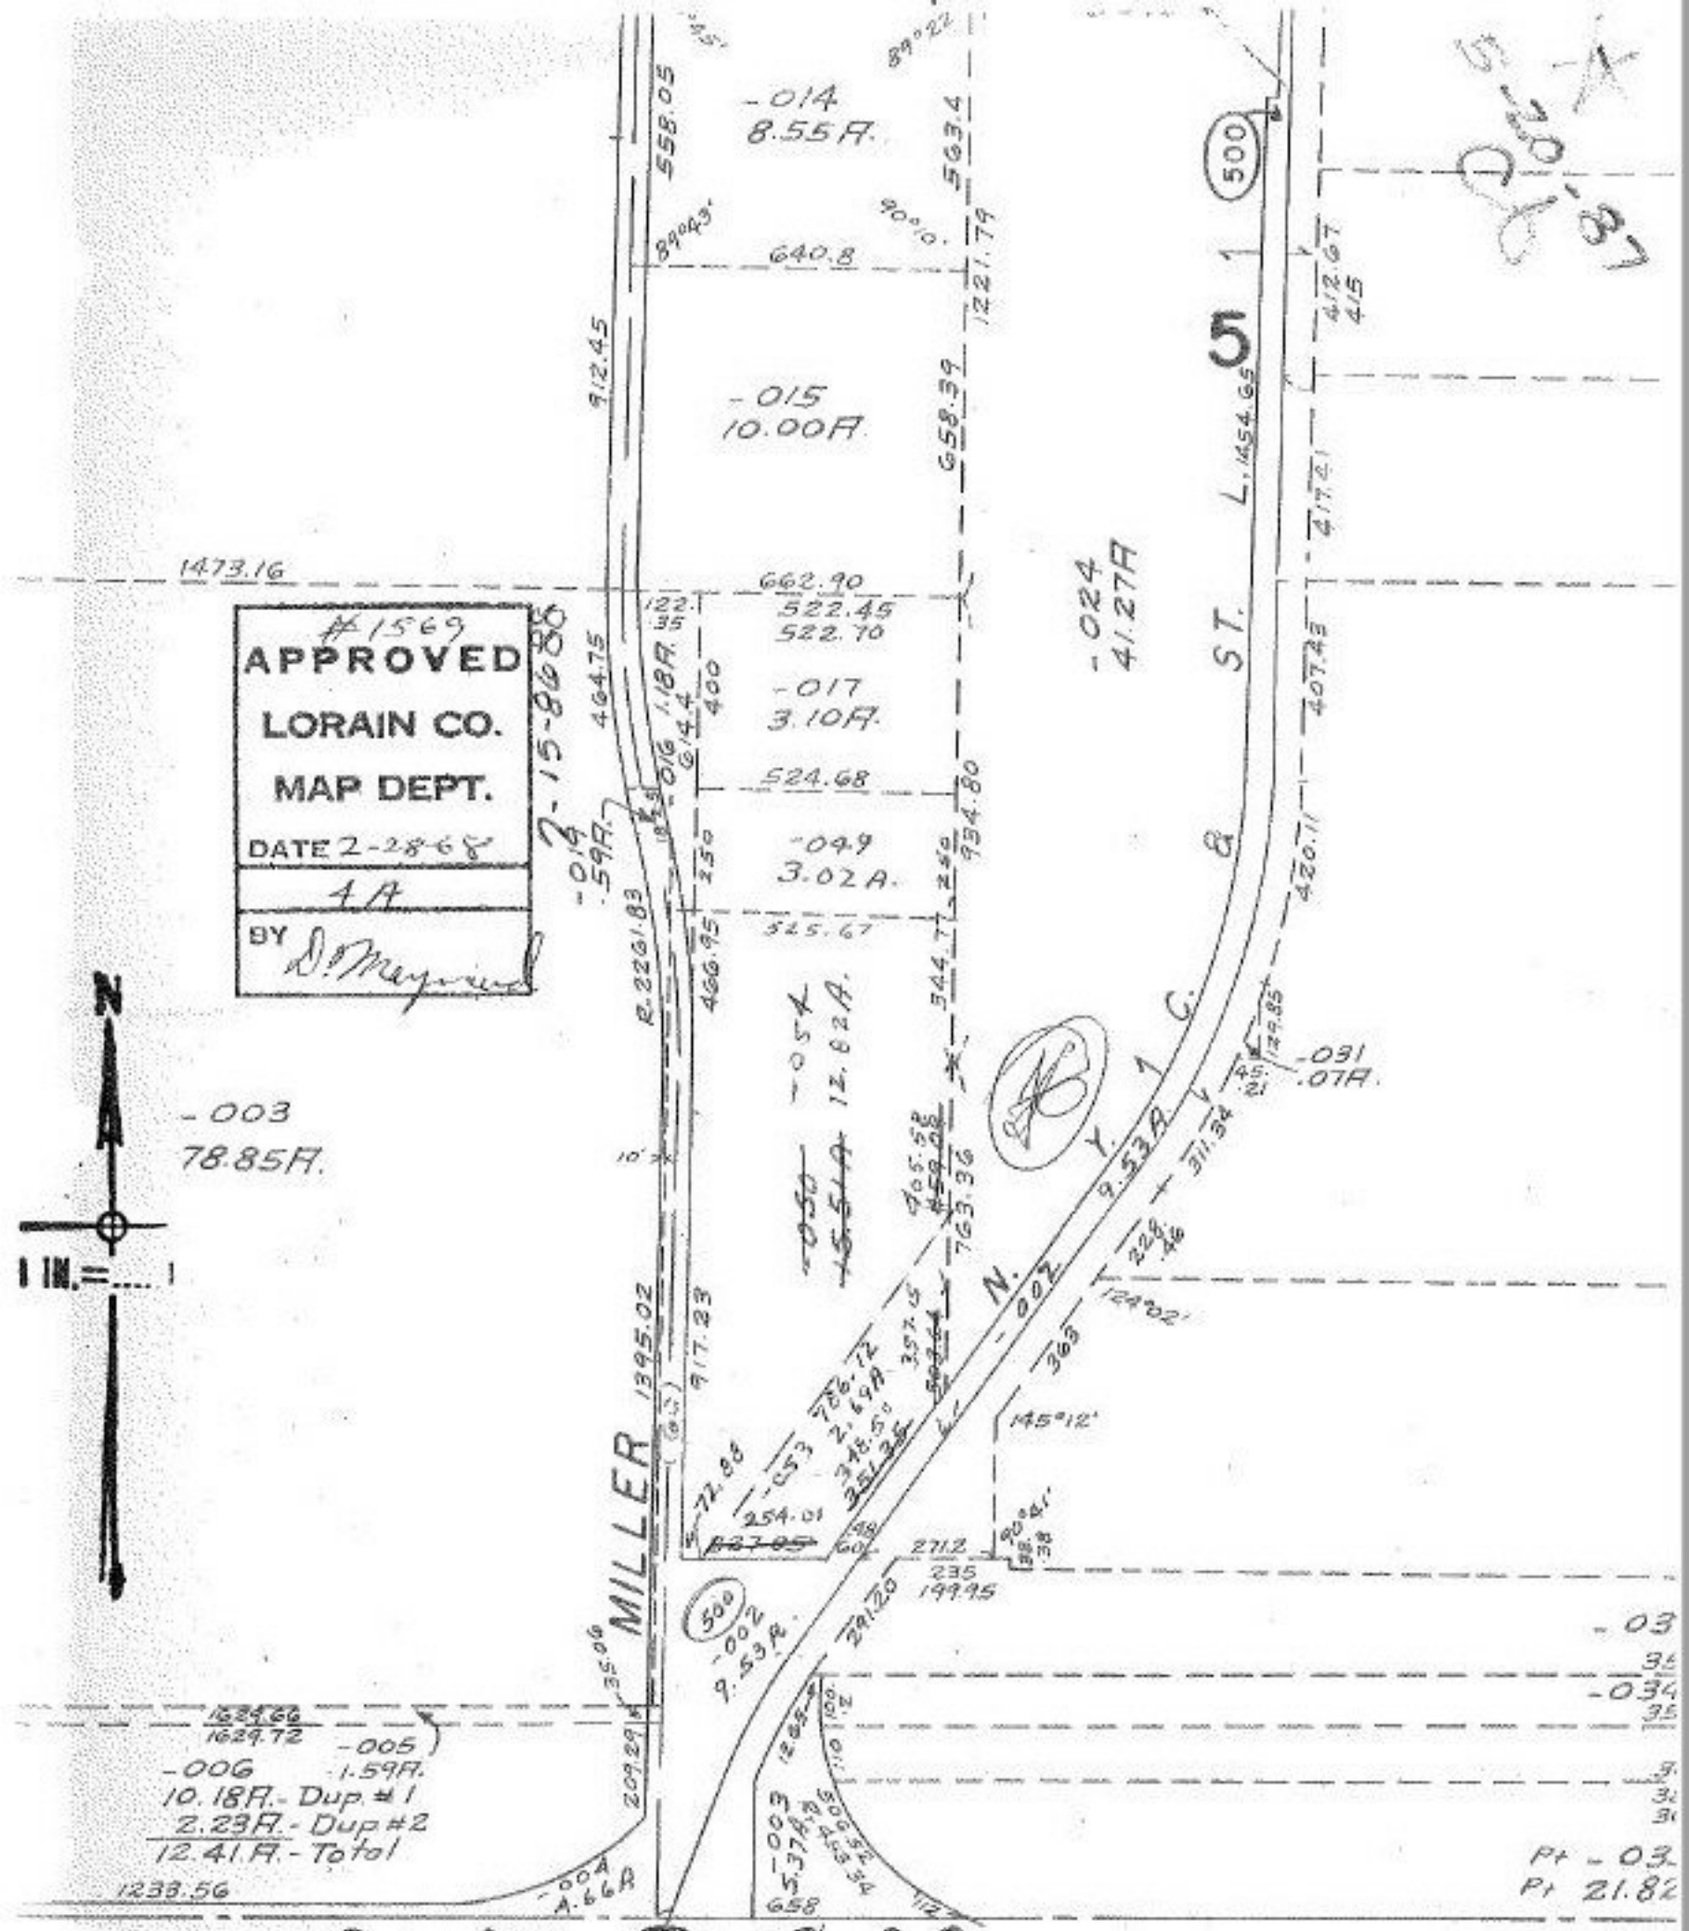

DONE 5-4-68
FRANK COLBERT.

SEE 4-E

4-A

1569