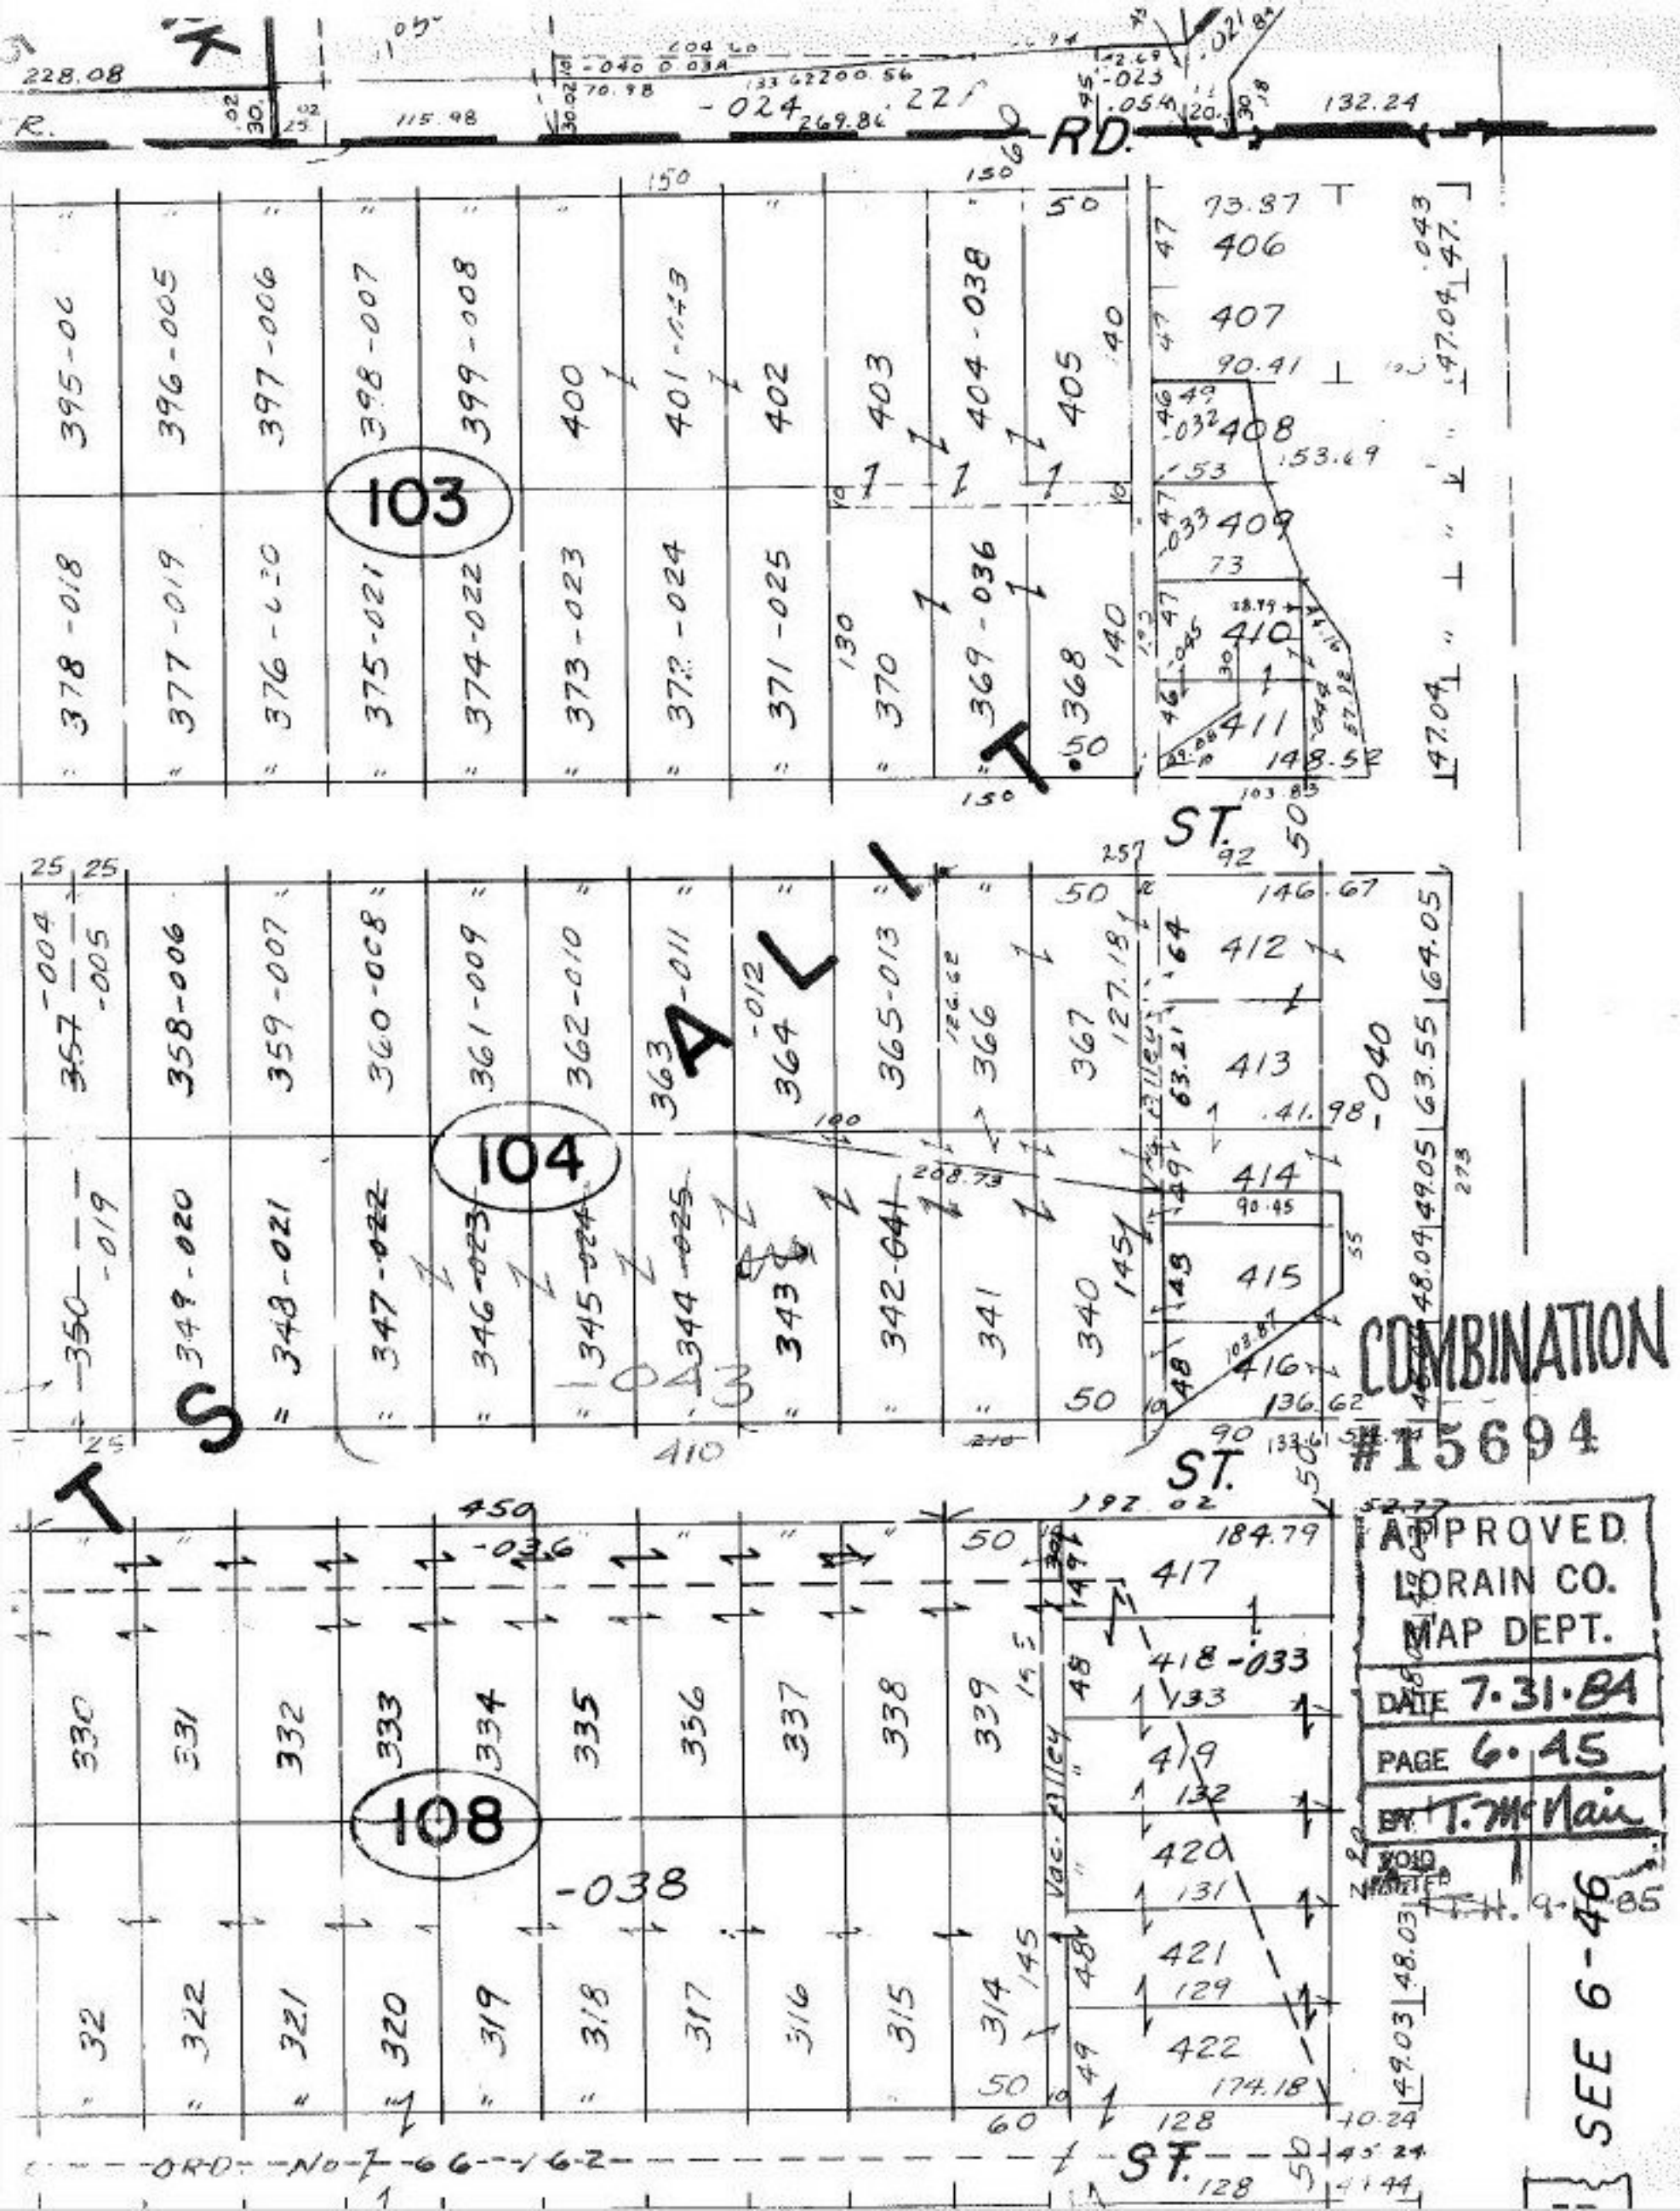

RD.
103
104
108
ST.
ALLIT
TS
COMBINATION
#15694
APPROVED
LORAIN CO.
MAP DEPT.
DATE 7.31.84
PAGE 6.45
BY T. McNair
SEE 6-46
ORD. No. 7-66-162