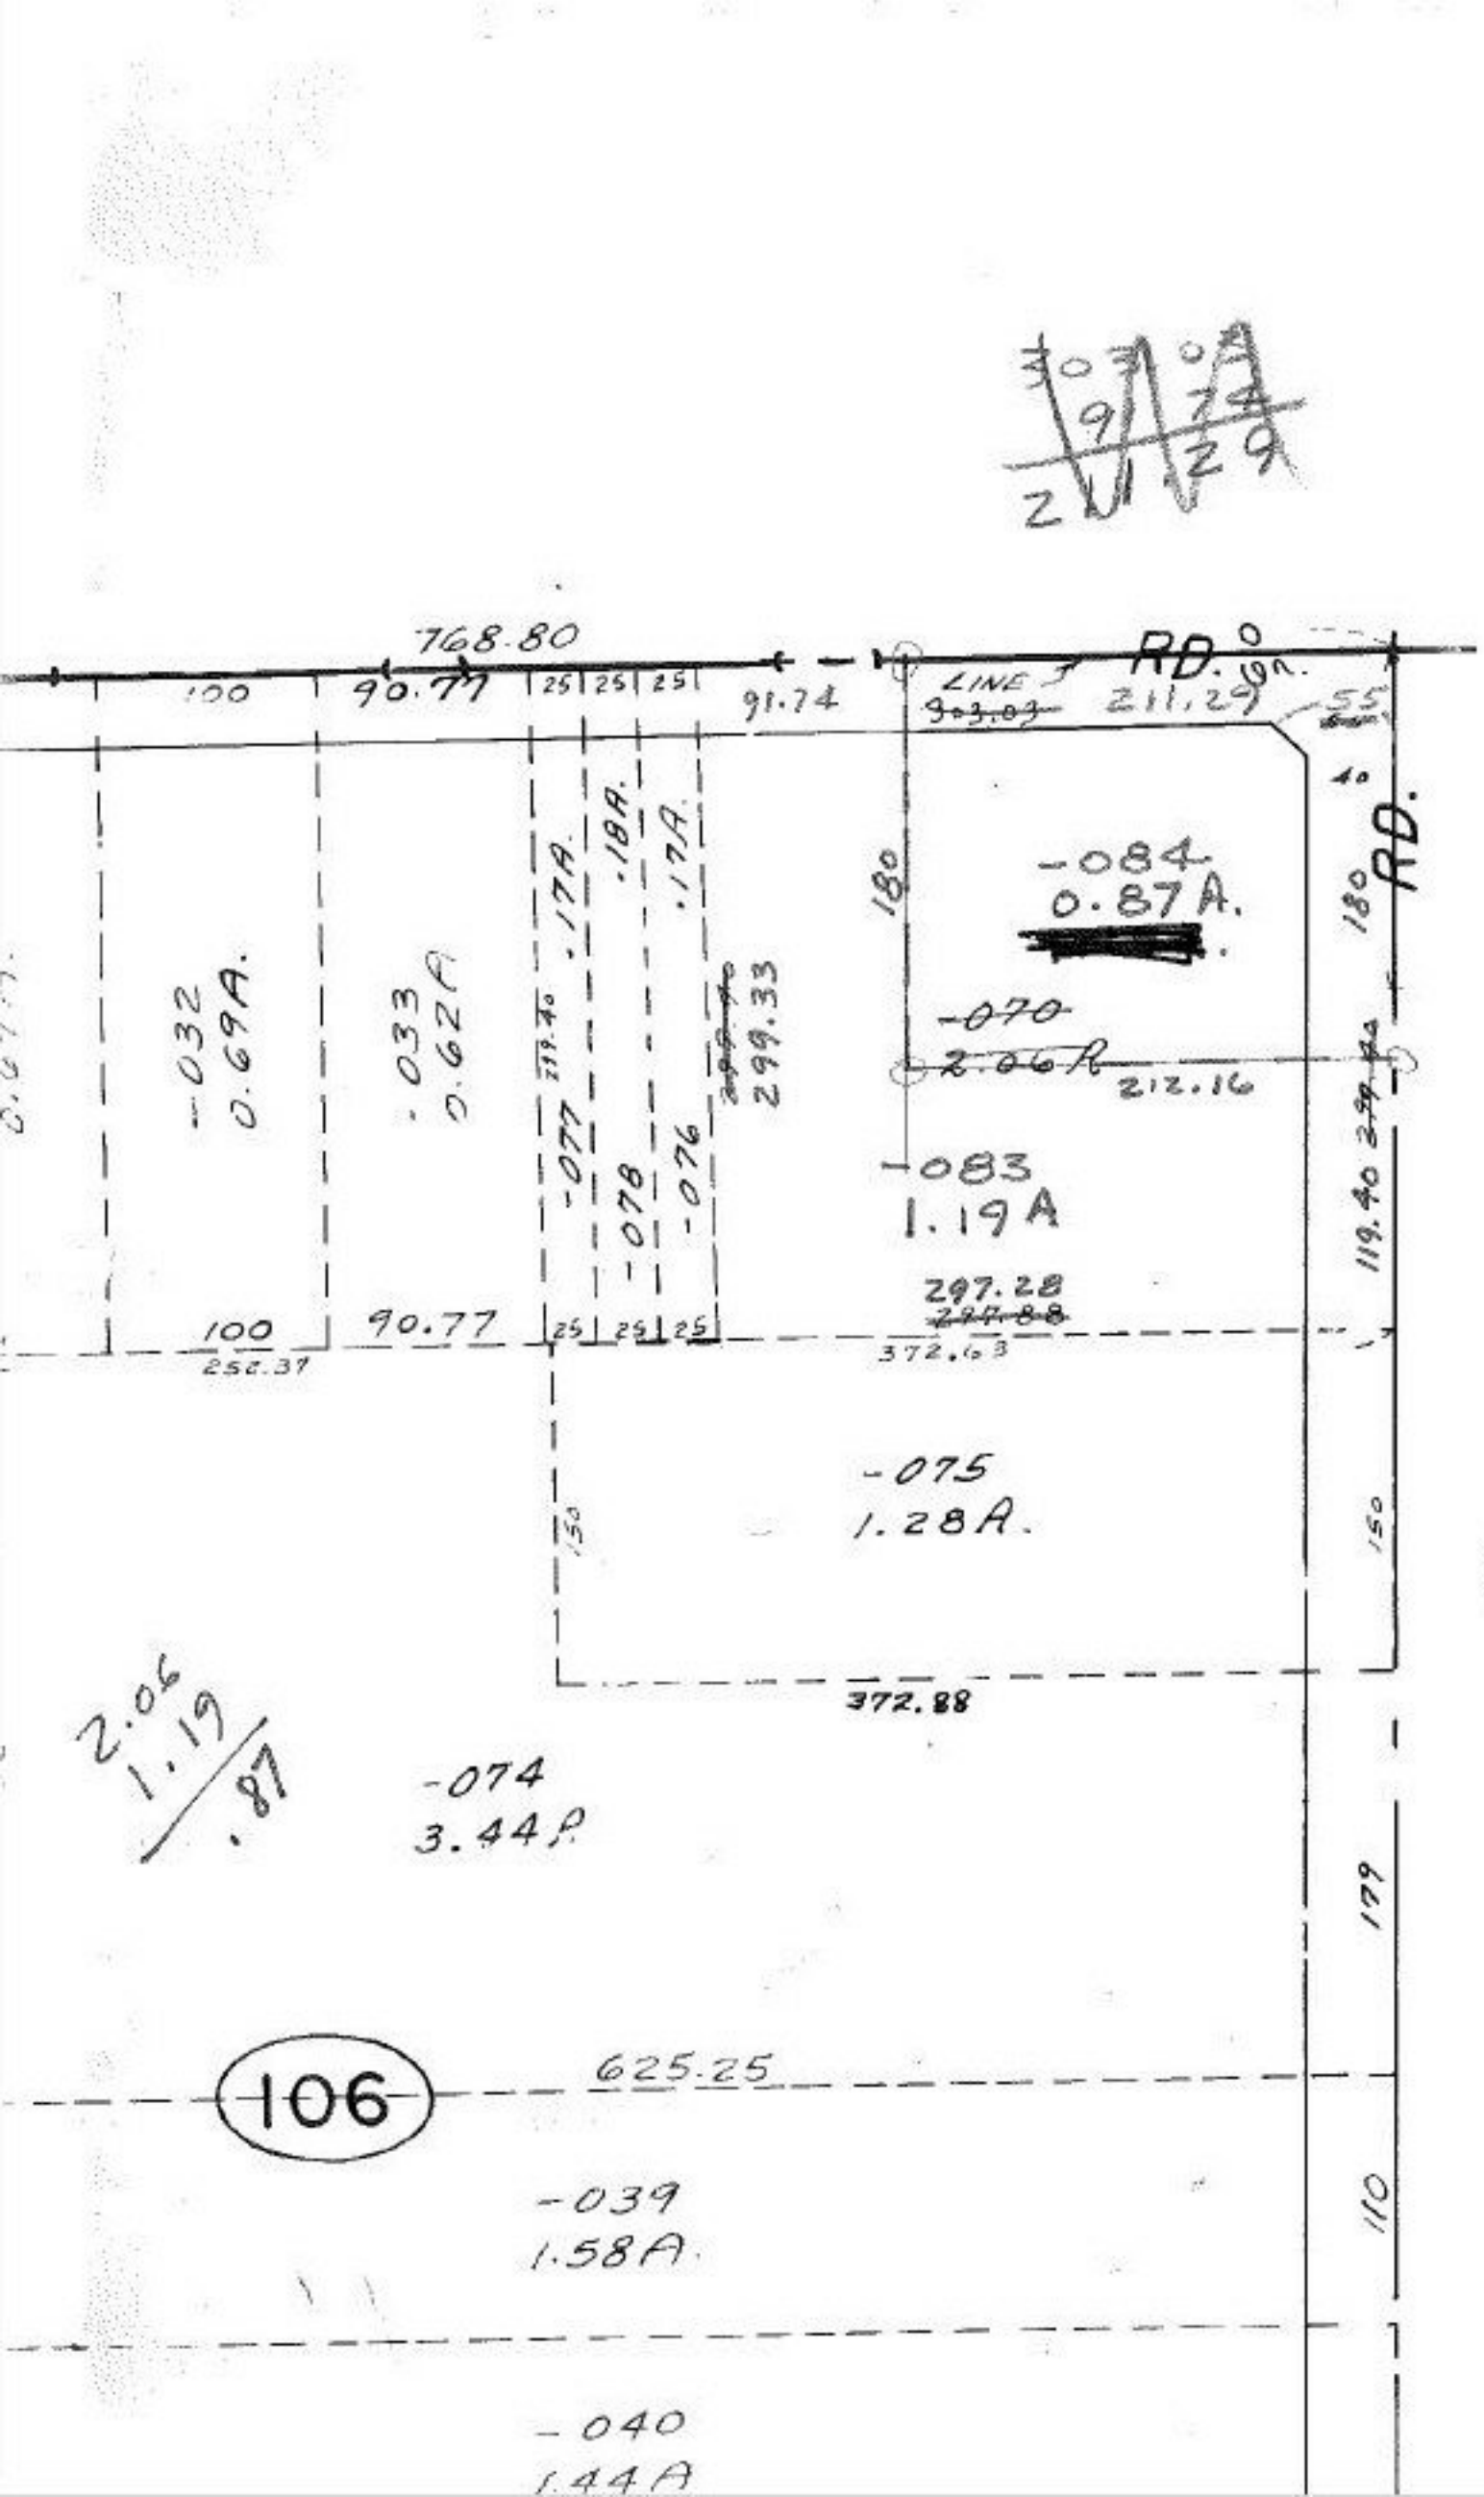

#15698

APPROVED
LORAIN CO.
MAP DEPT.
DATE 7-11-84
PAGE 5-00-040B
BY
VOID AFTER 15698

.63
.58
1.21

T.H.
7-17-85