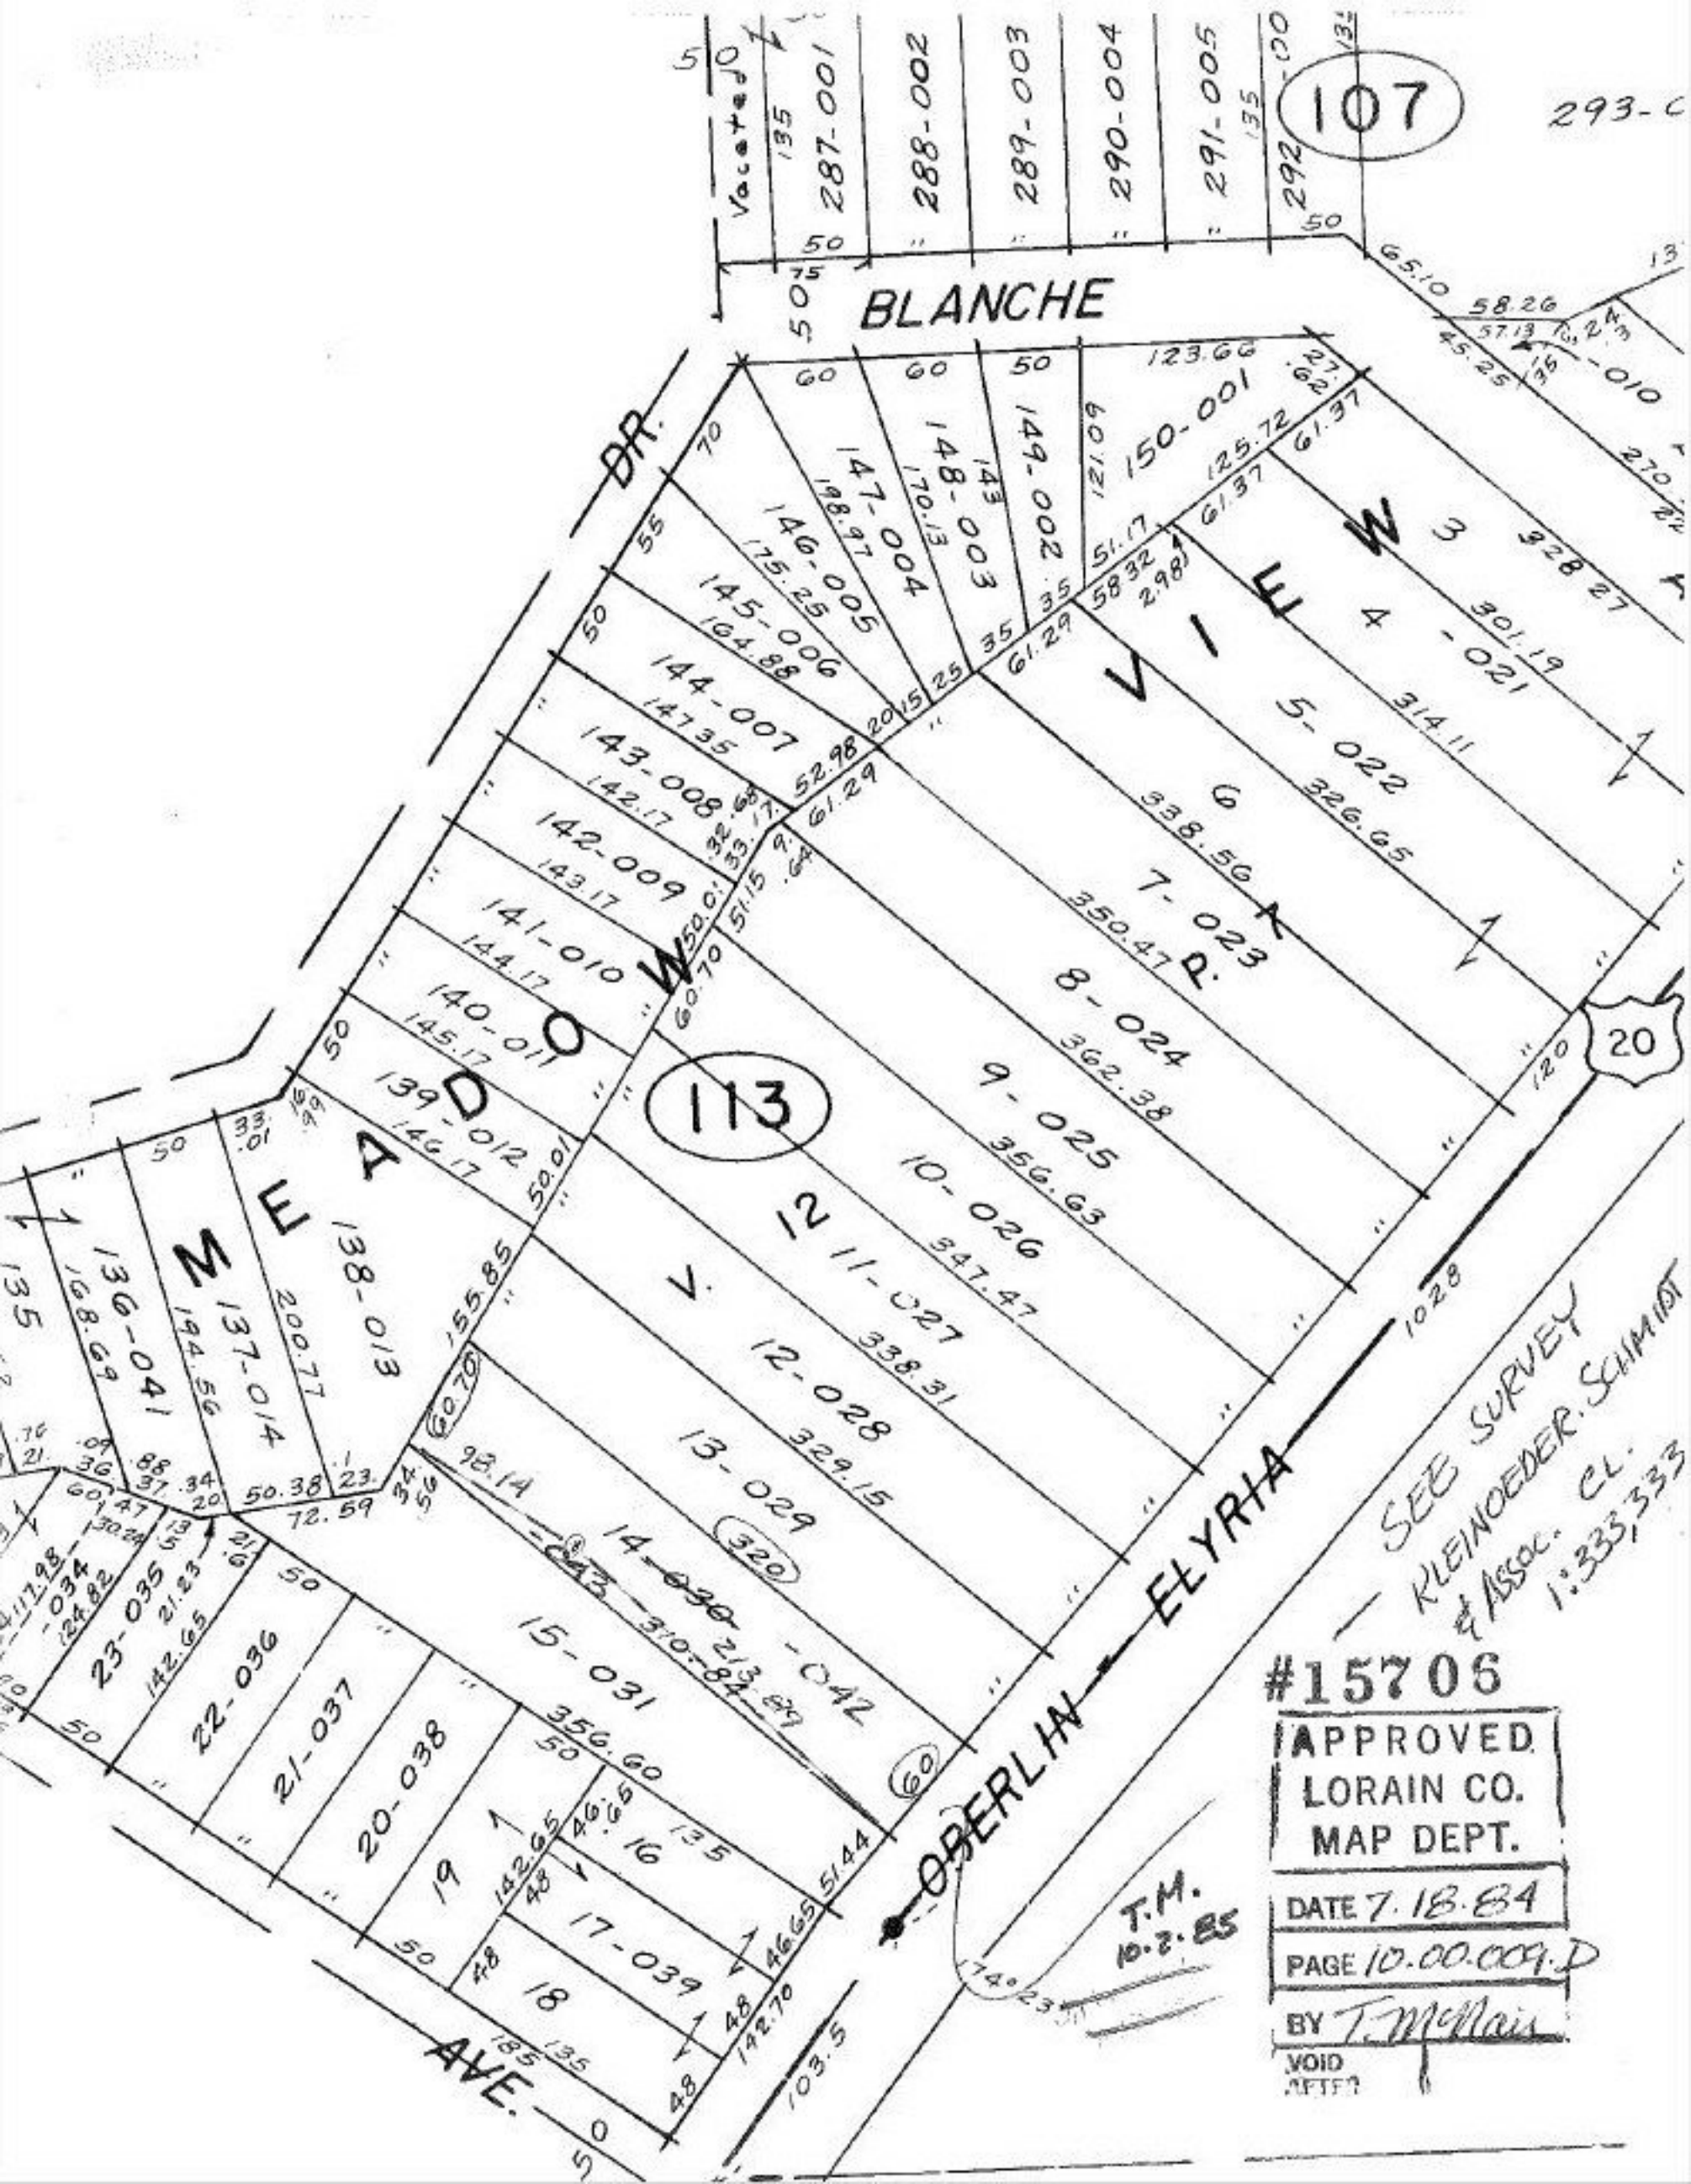

107
BLANCHE
DR.
MEADOW
VIEW
113
V. 12
OBERLIN — ELYRIA
AVE.
20
287-001
288-002
289-003
290-004
291-005
150-001
147-004
148-003
149-002
146-005
145-006
144-007
143-008
142-009
141-010
140-011
139-012
138-013
137-014
136-041
23-035
22-036
21-037
20-038
19
18
17-039
16
15-031
14-030
13-029
12-028
11-027
10-026
9-025
8-024
7-023
6
5-022
4-021
3
SEE SURVEY
KLEINOEDER. SCHMIDT
& ASSOC. CL.
1:333,333
T.M.
10.2.85
#15706
APPROVED
LORAIN CO.
MAP DEPT.
DATE 7.18.84
PAGE 10.00.009.D
BY T. McNair
VOID
AFTER