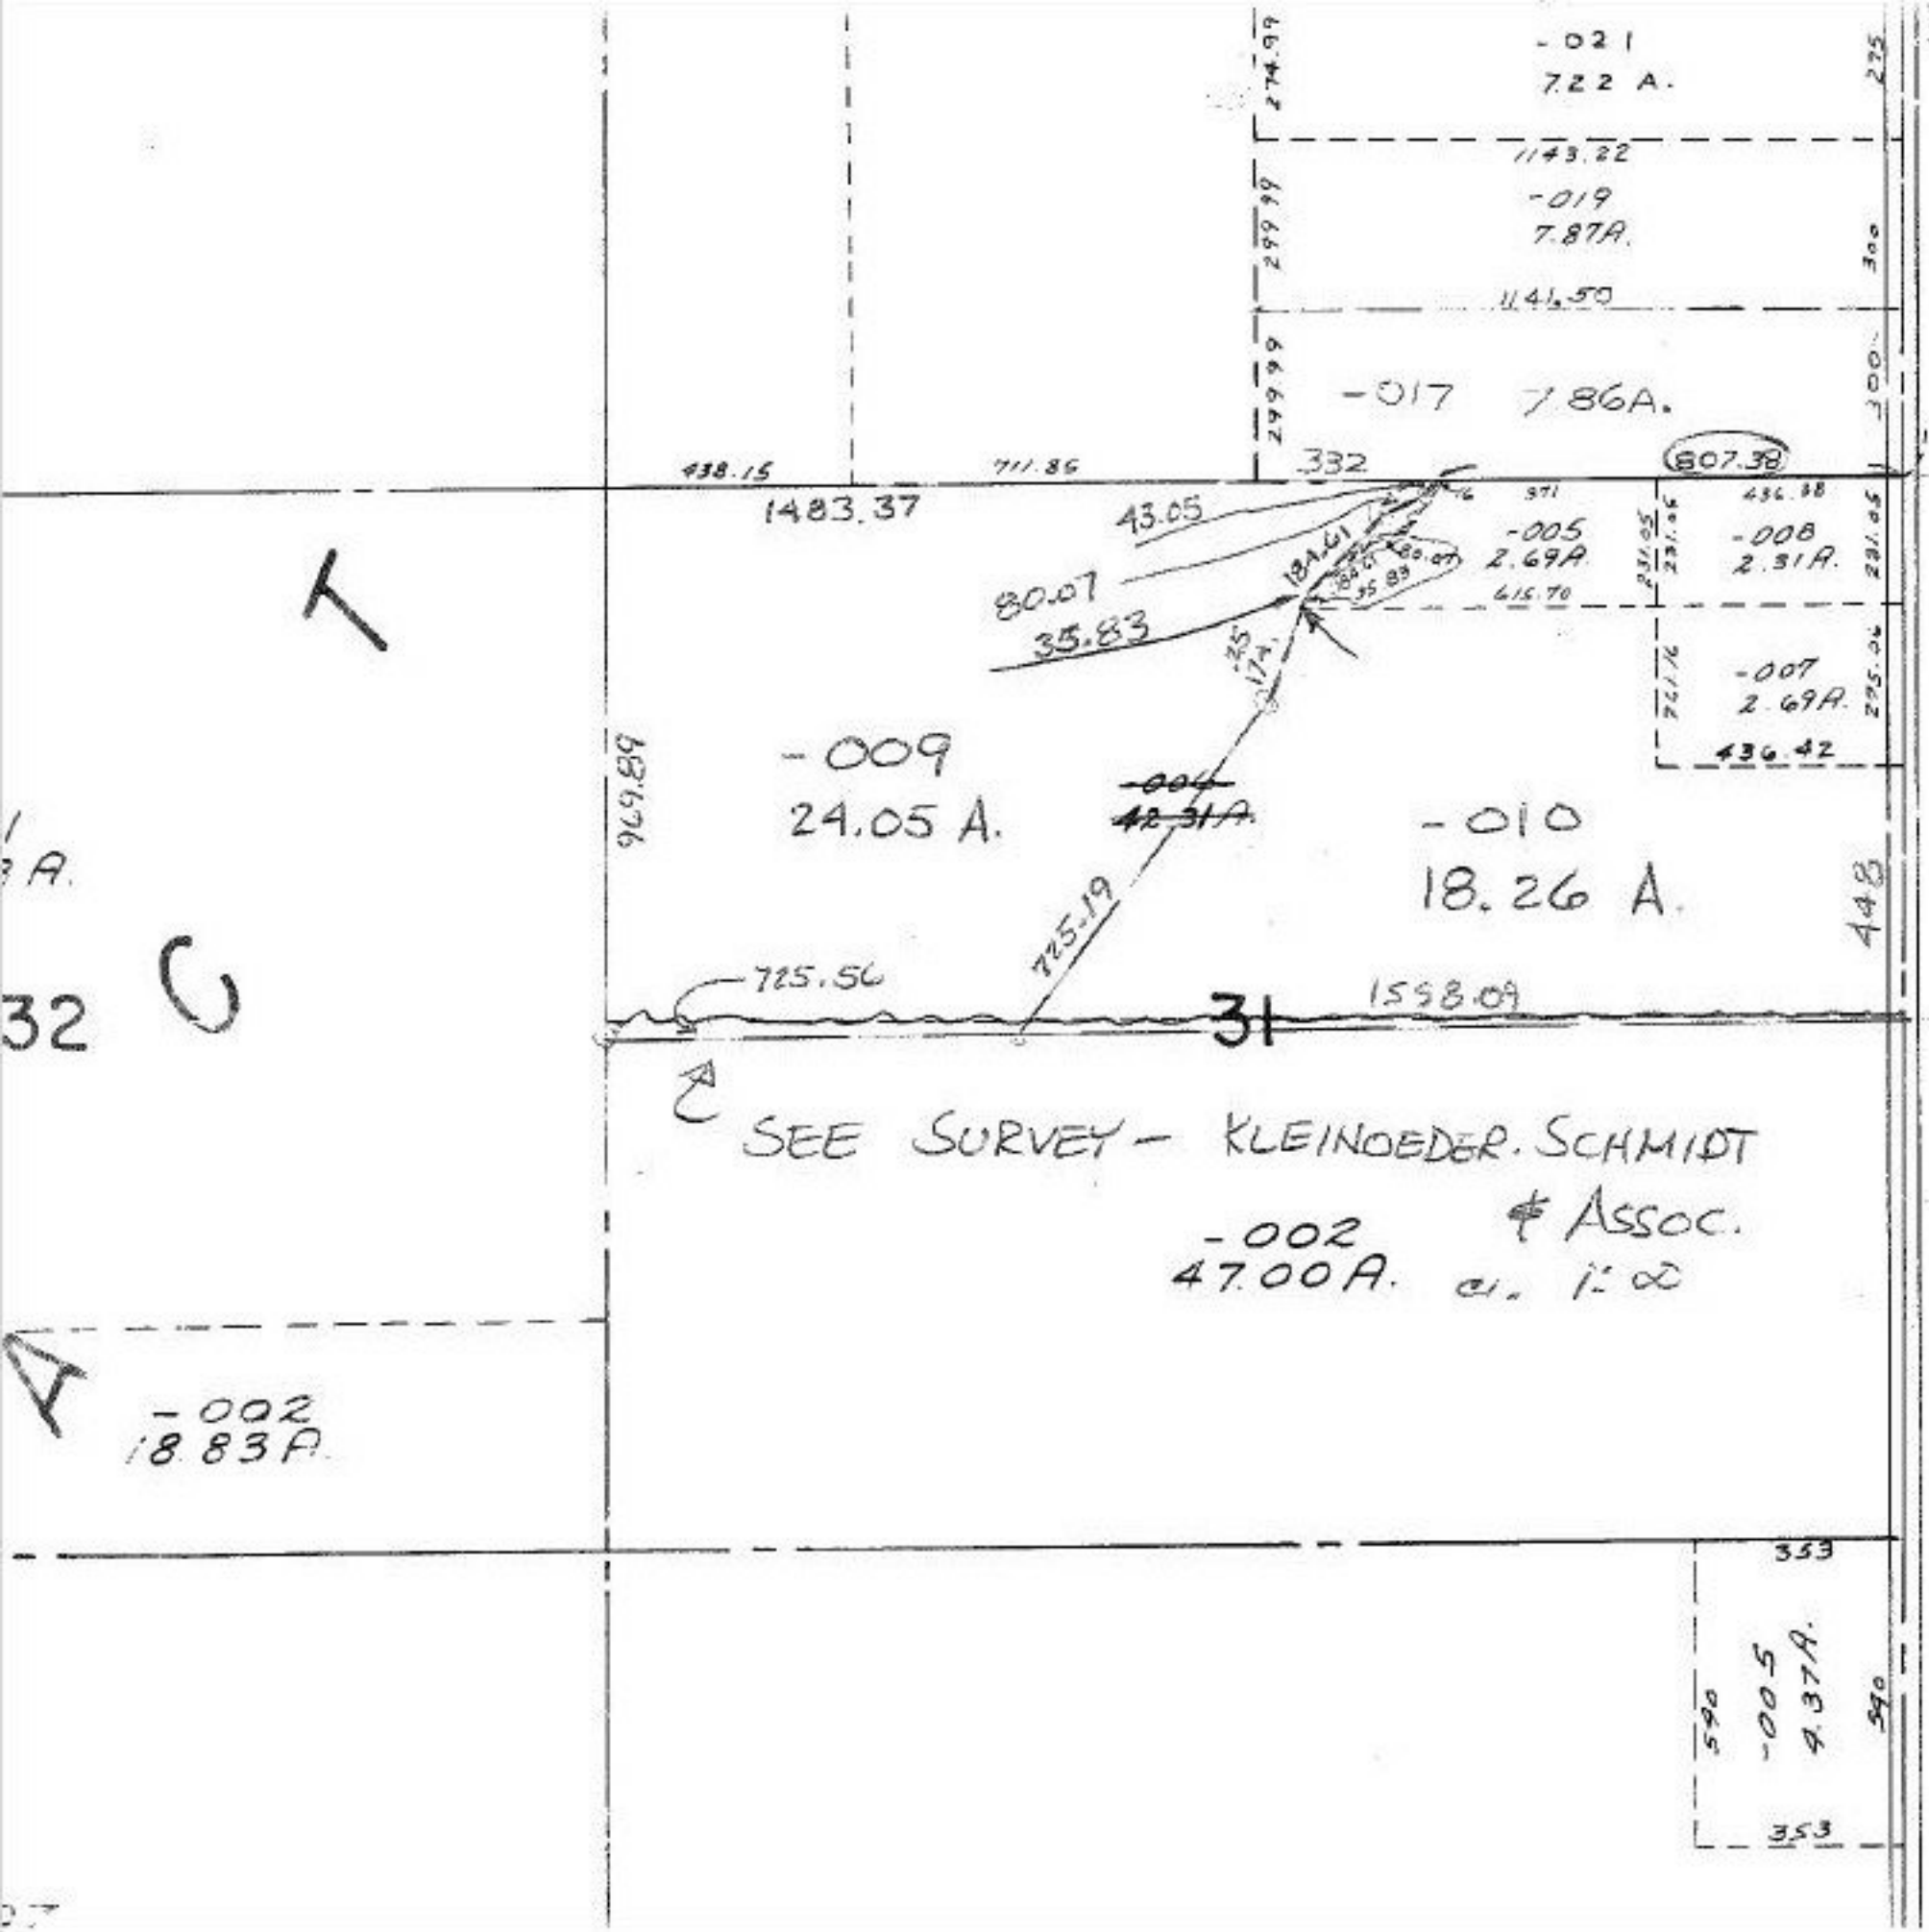

#15719

APPROVED
LORAIN CO.
MAP DEPT.

DATE 7.30.84

PAGE 13-G

BY T. McNair

VOID AFTER

T.H. ~~[illegible]~~ 5/1/85