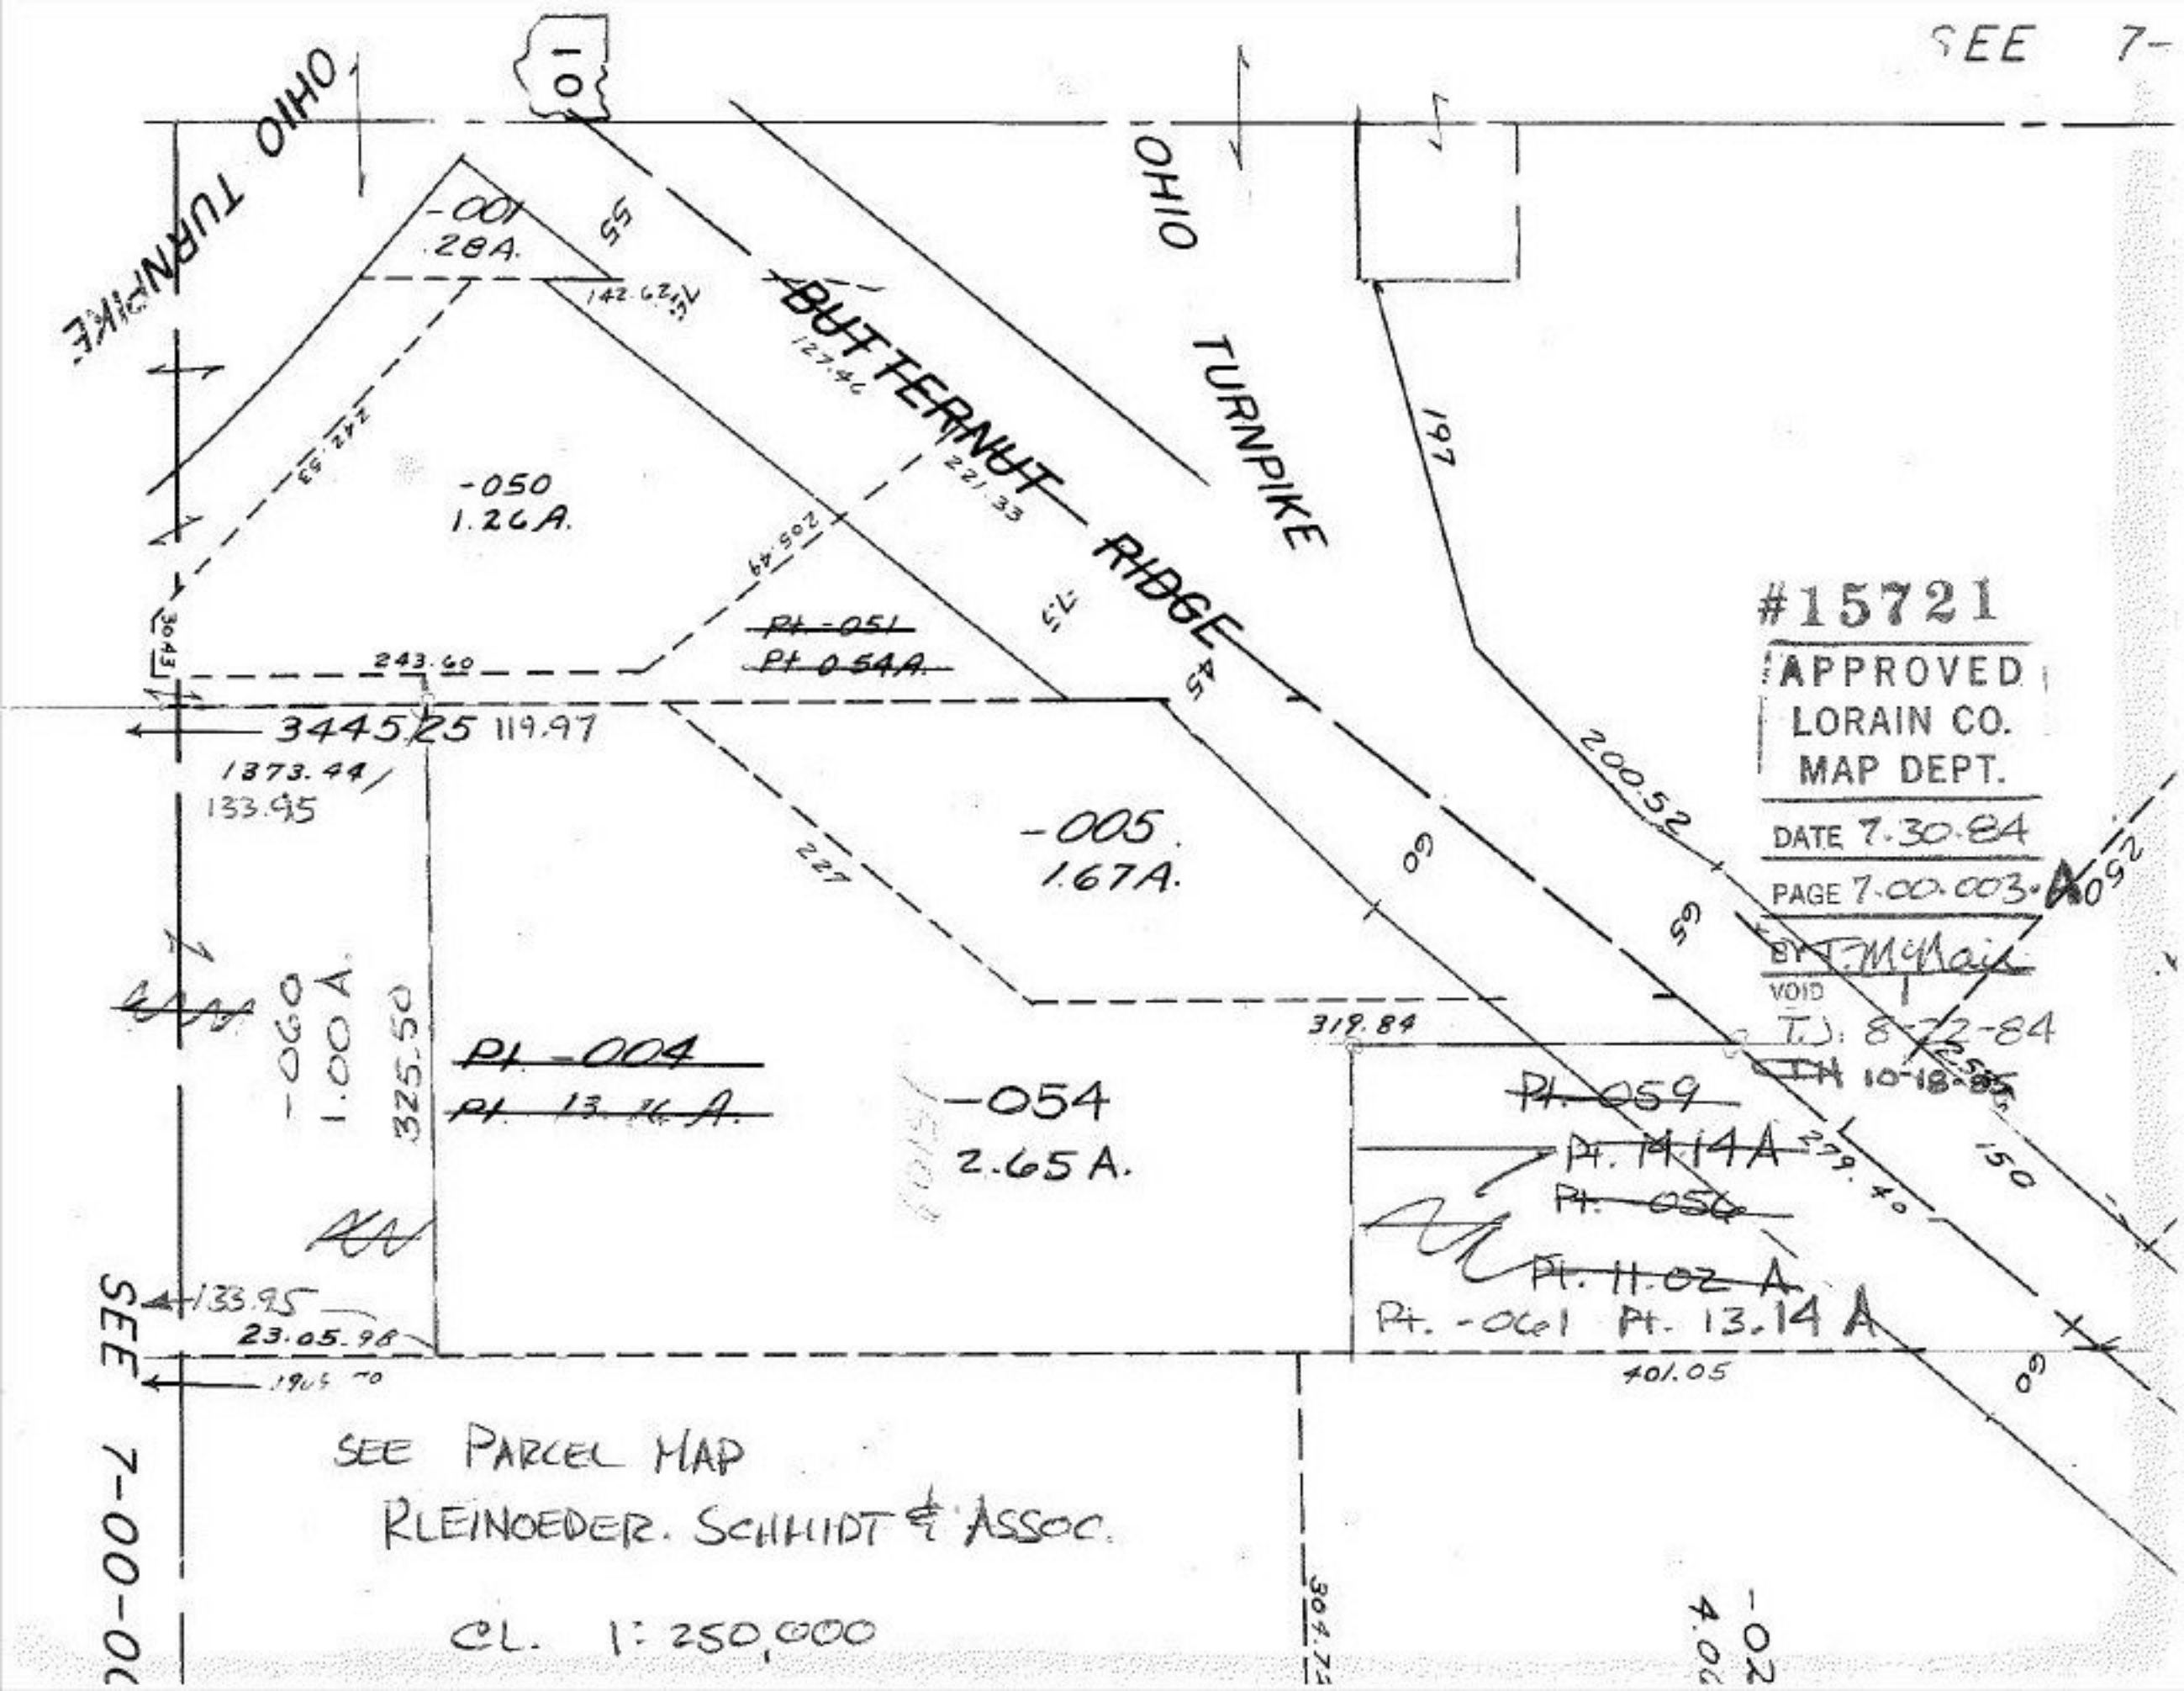
SEE 7-
OHIO TURNPIKE
OHIO TURNPIKE
BUTTERNUT RIDGE
-001
.28A.
-050
1.26A.
Pt. -051
Pt. 0.54A.
-005
1.67A.
-054
2.65A.
Pt. -004
Pt. 13.16 A.
-060
1.00 A.
Pt. -059
Pt. 14.14A
Pt. -056
Pt. 11.02 A.
Pt. -061 Pt. 13.14 A
3445.25 119.97
1373.44
133.95
243.60
325.50
319.84
401.05
200.52
279.40
SEE 7-00-00
SEE PARCEL MAP
RLEINOEDER. SCHMIDT & ASSOC.
CL. 1:250,000
#15721
APPROVED
LORAIN CO.
MAP DEPT.
DATE 7.30.84
PAGE 7.00.003.A
BY T. McNair
VOID
T.J. 8-22-84
TH 10-18-85