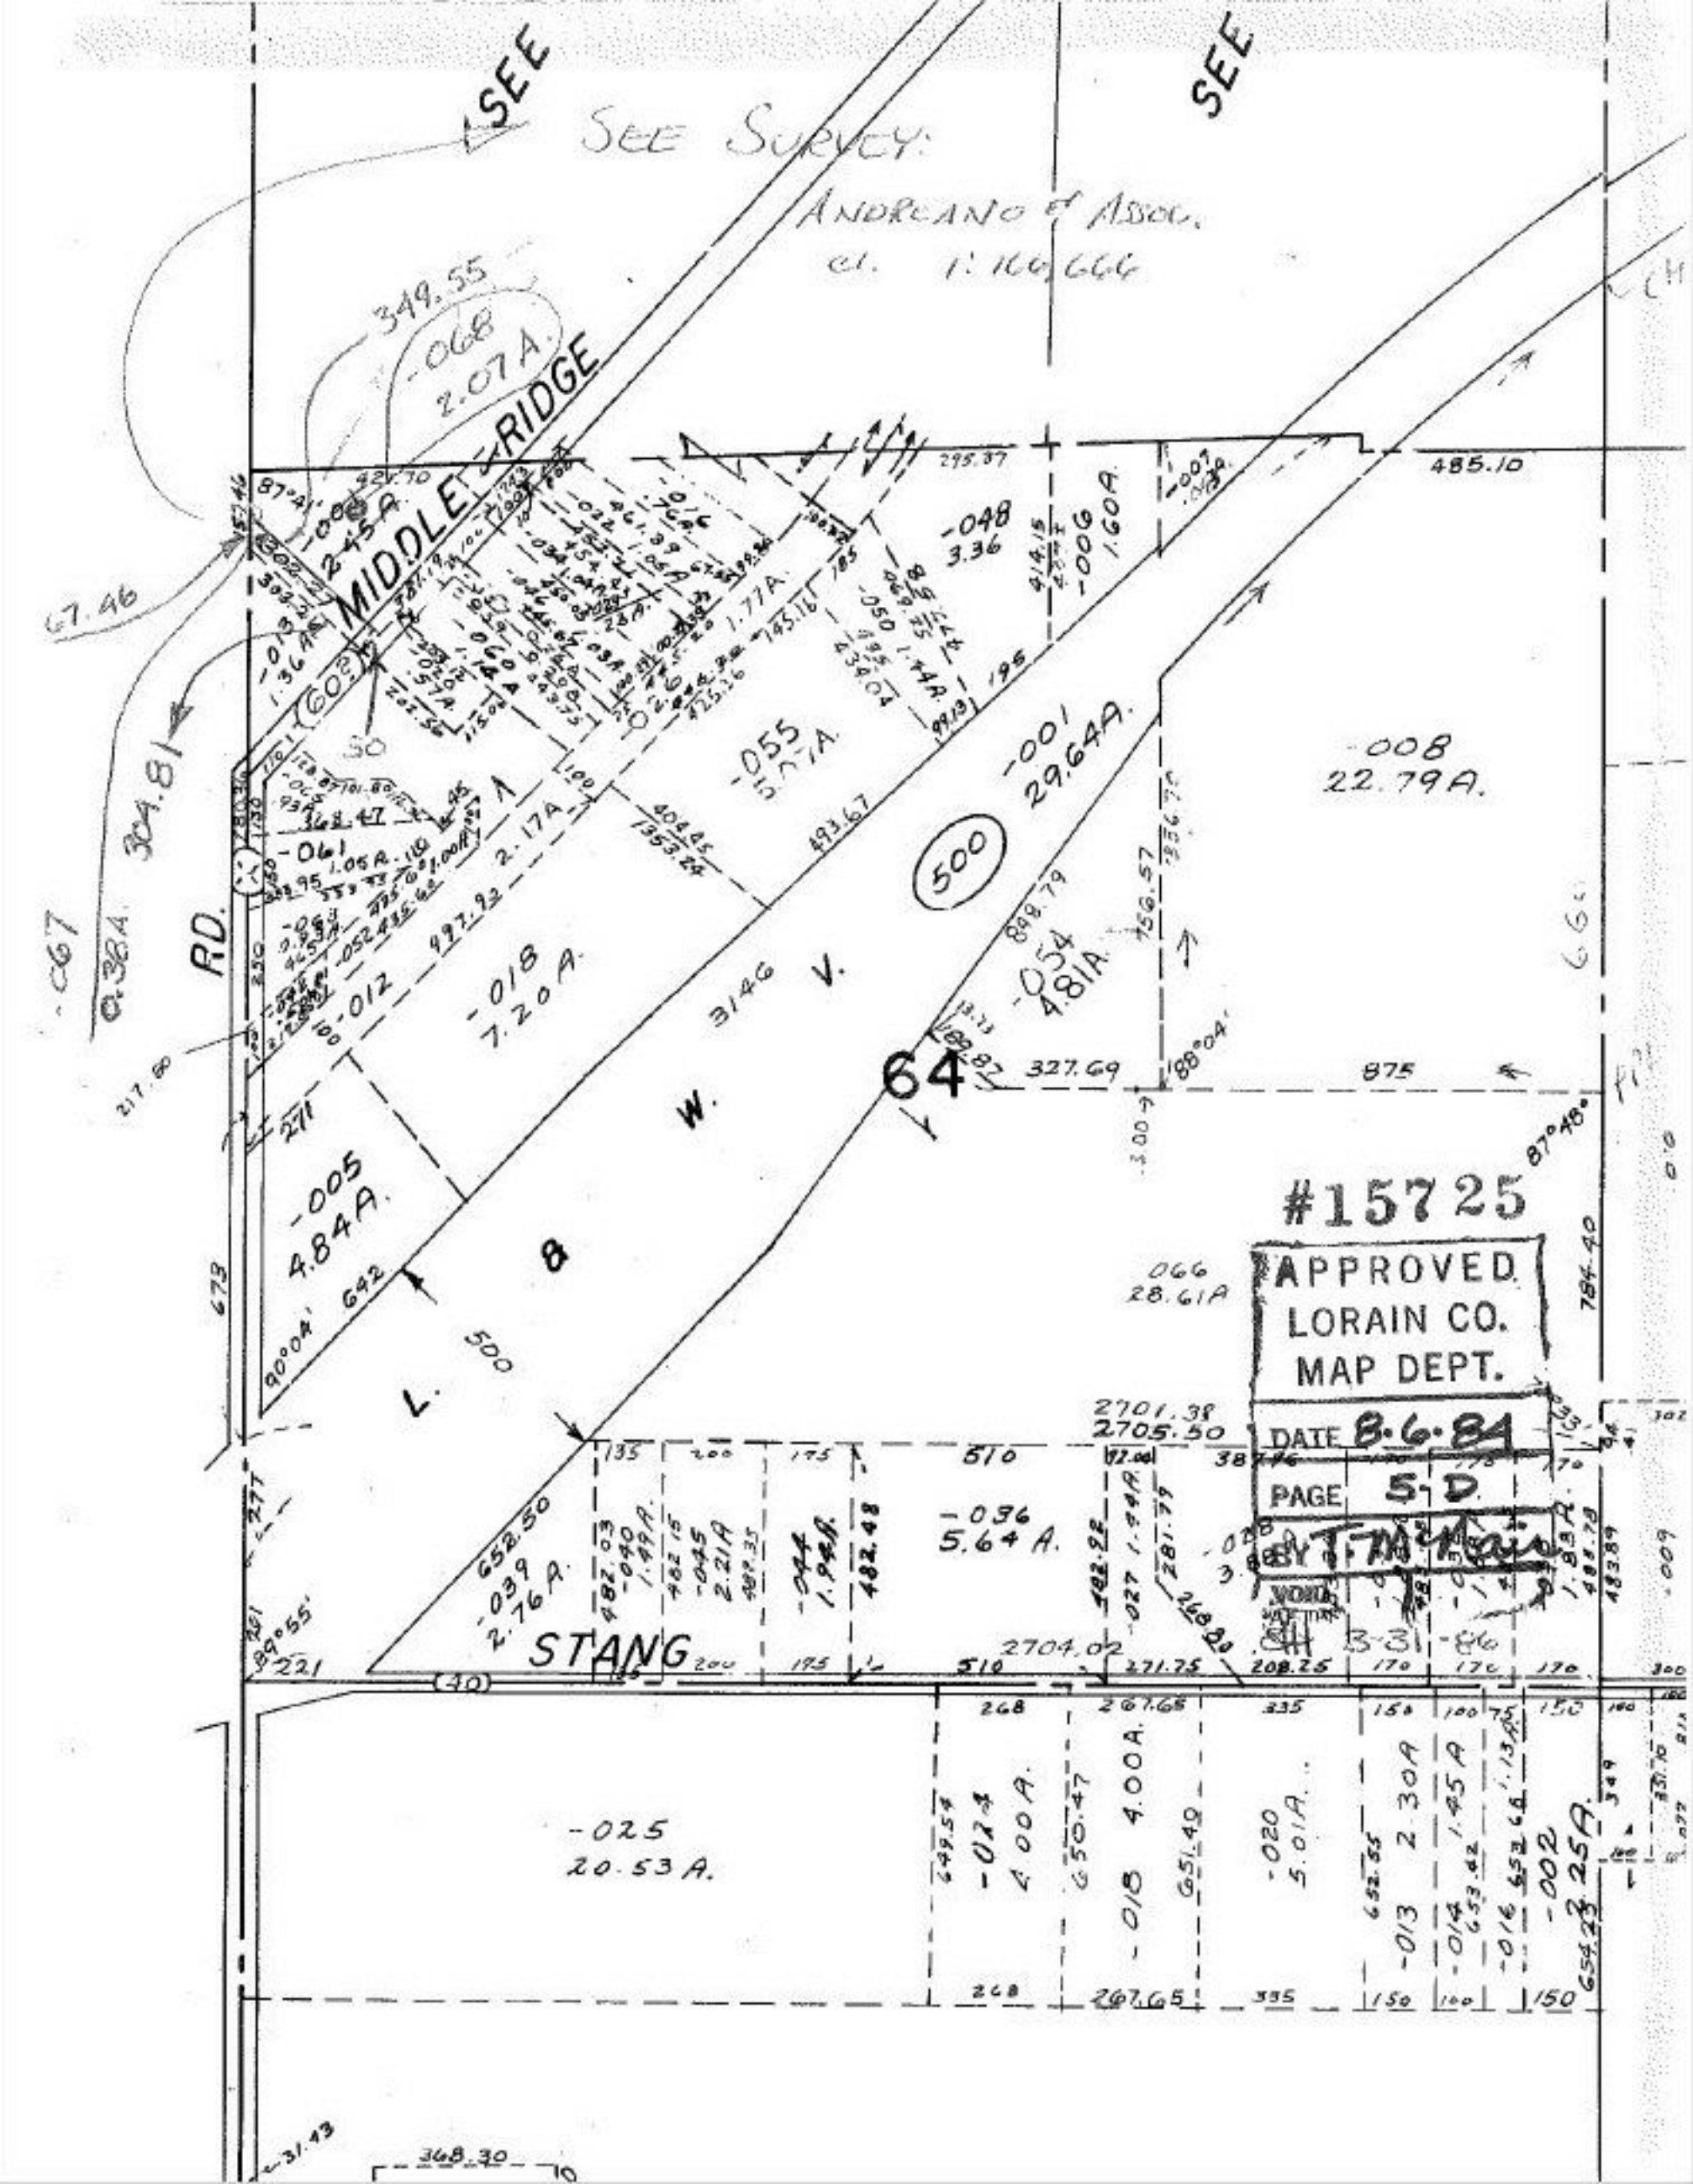
SEE
SEE
SEE SURVEY:
ANDREANO & ASSOC.
cl. 1:166,666
MIDDLE RIDGE
RD.
STANG
64
V.
W.
L.
500
-008
22.79A.
-001
29.64A.
-055
5.07A.
-018
7.20A.
-005
4.84A.
-054
4.81A.
-036
5.64A.
-039
2.76A.
-025
20.53A.
-024
4.00A.
-018
4.00A.
-020
5.01A.
-013
2.30A.
-014
1.45A.
-002
2.25A.
-048
3.36
-006
1.60A.
-068
2.07A.
-067
0.38A.
349.55
67.46
304.81
485.10
327.69
875
2701.38
2705.50
2704.02
368.30
#15725
APPROVED
LORAIN CO.
MAP DEPT.
DATE 8-6-84
PAGE 5-D
BY T. McKain
3-31-86