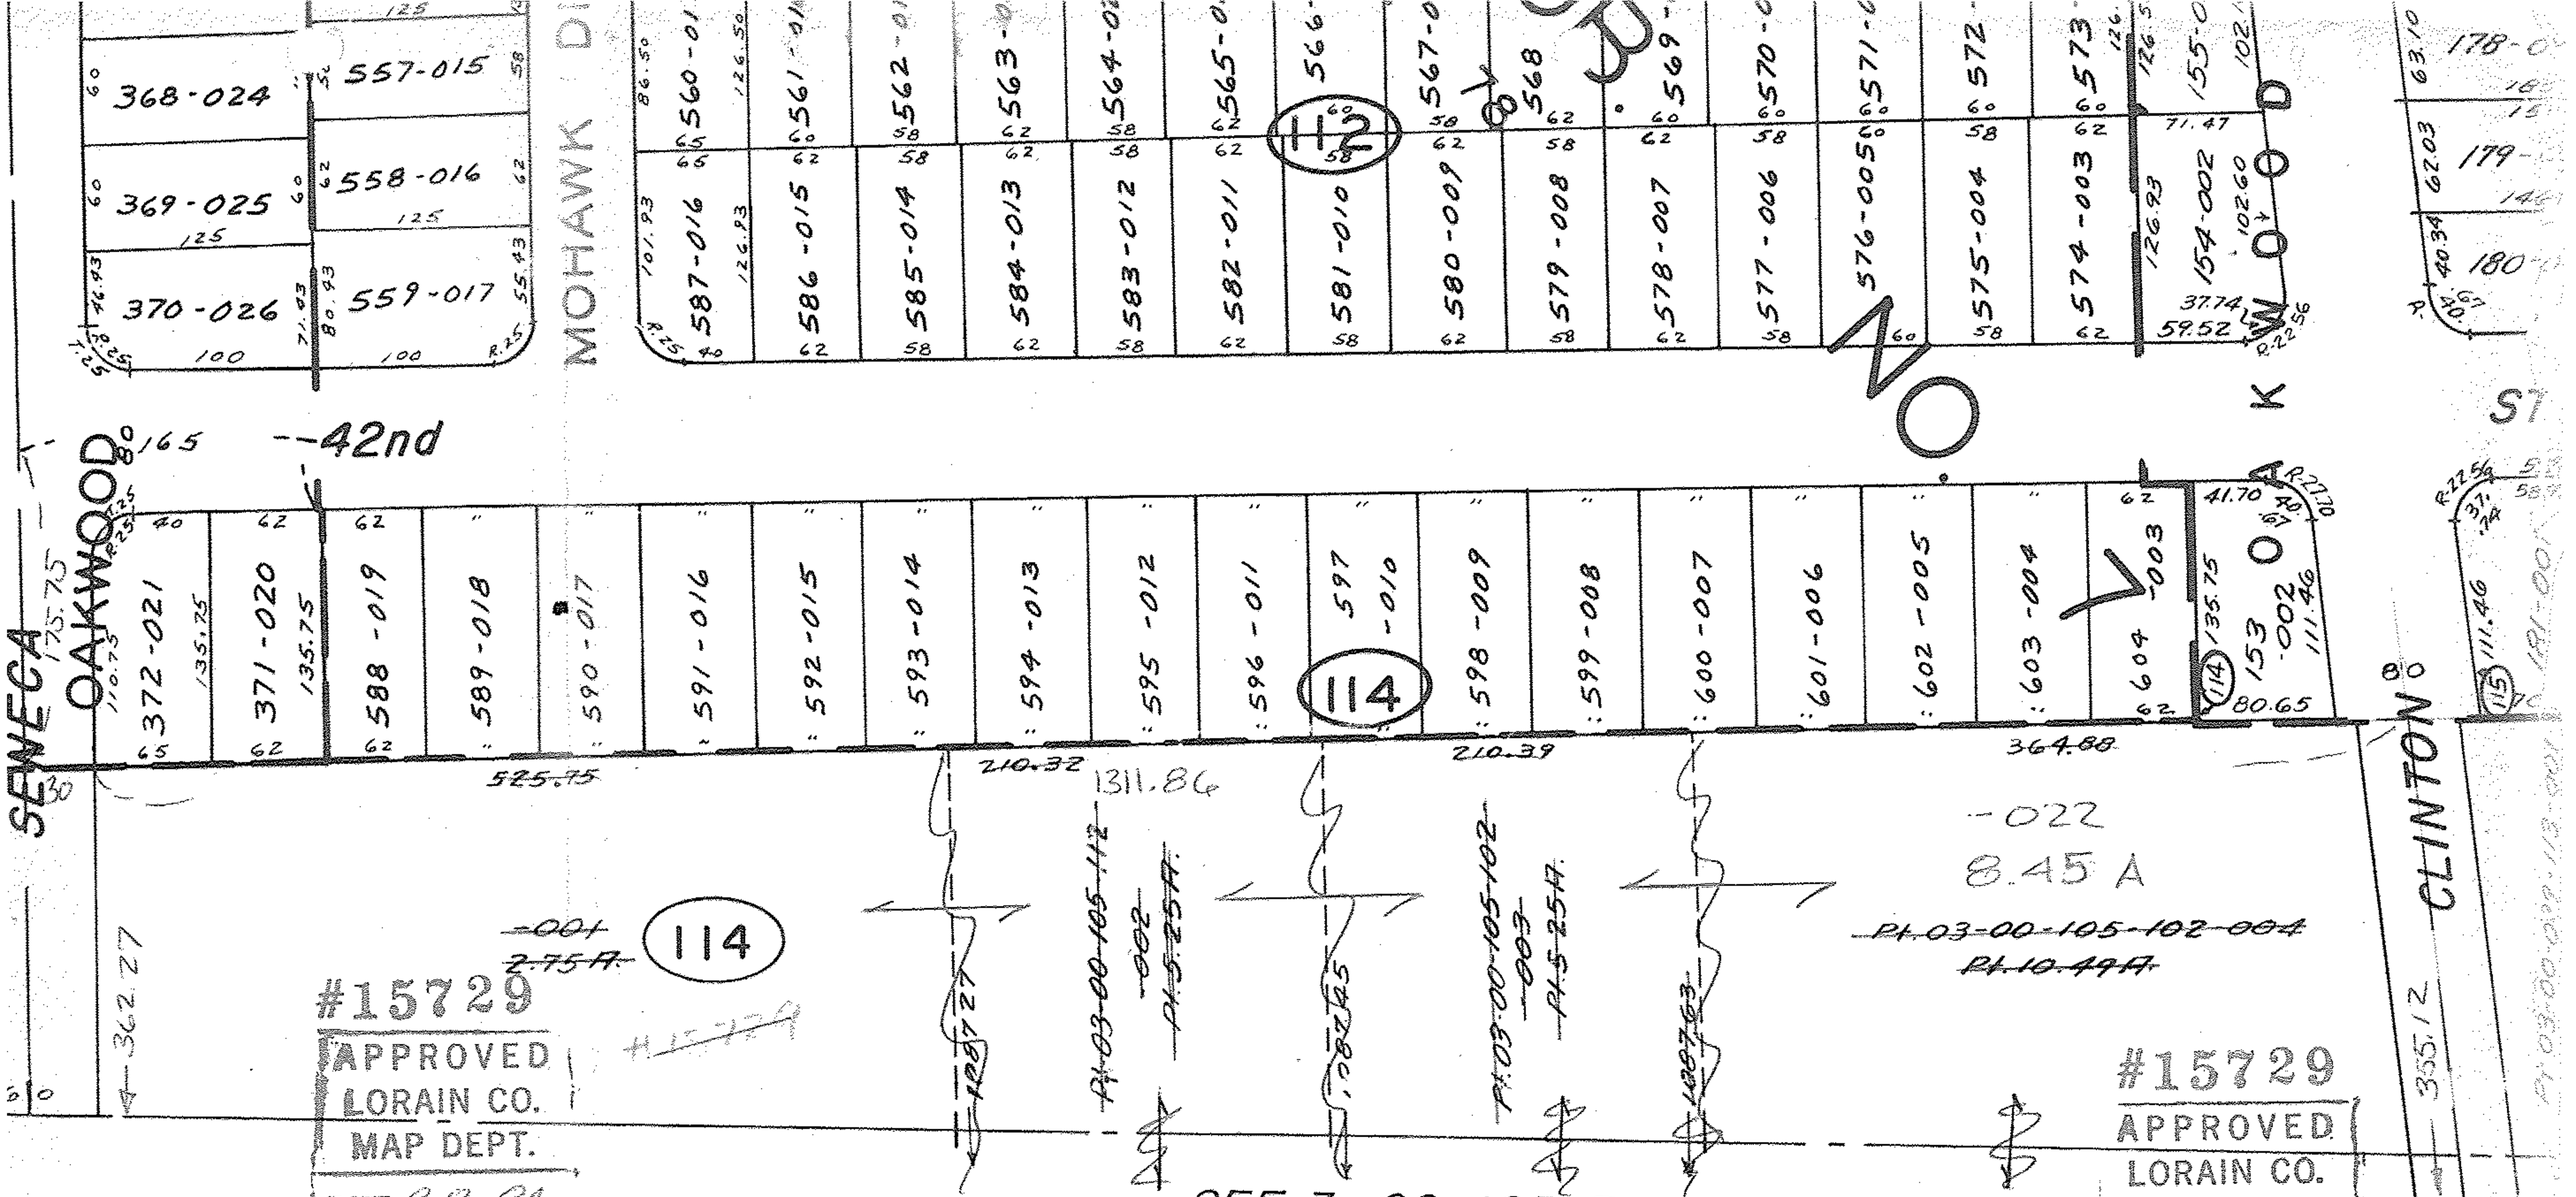

SEE SURVEY: KLEINGEDER · SCHMIDT & ASSOC.
CL. 1: 1,000,000

T.M.
8.1.85

#15729
APPROVED
LORAIN CO.
MAP DEPT.
DATE 8.8.84
PAGE 3.00.100.B
BY T. McNair
VOID

SHEFFIELD TWP