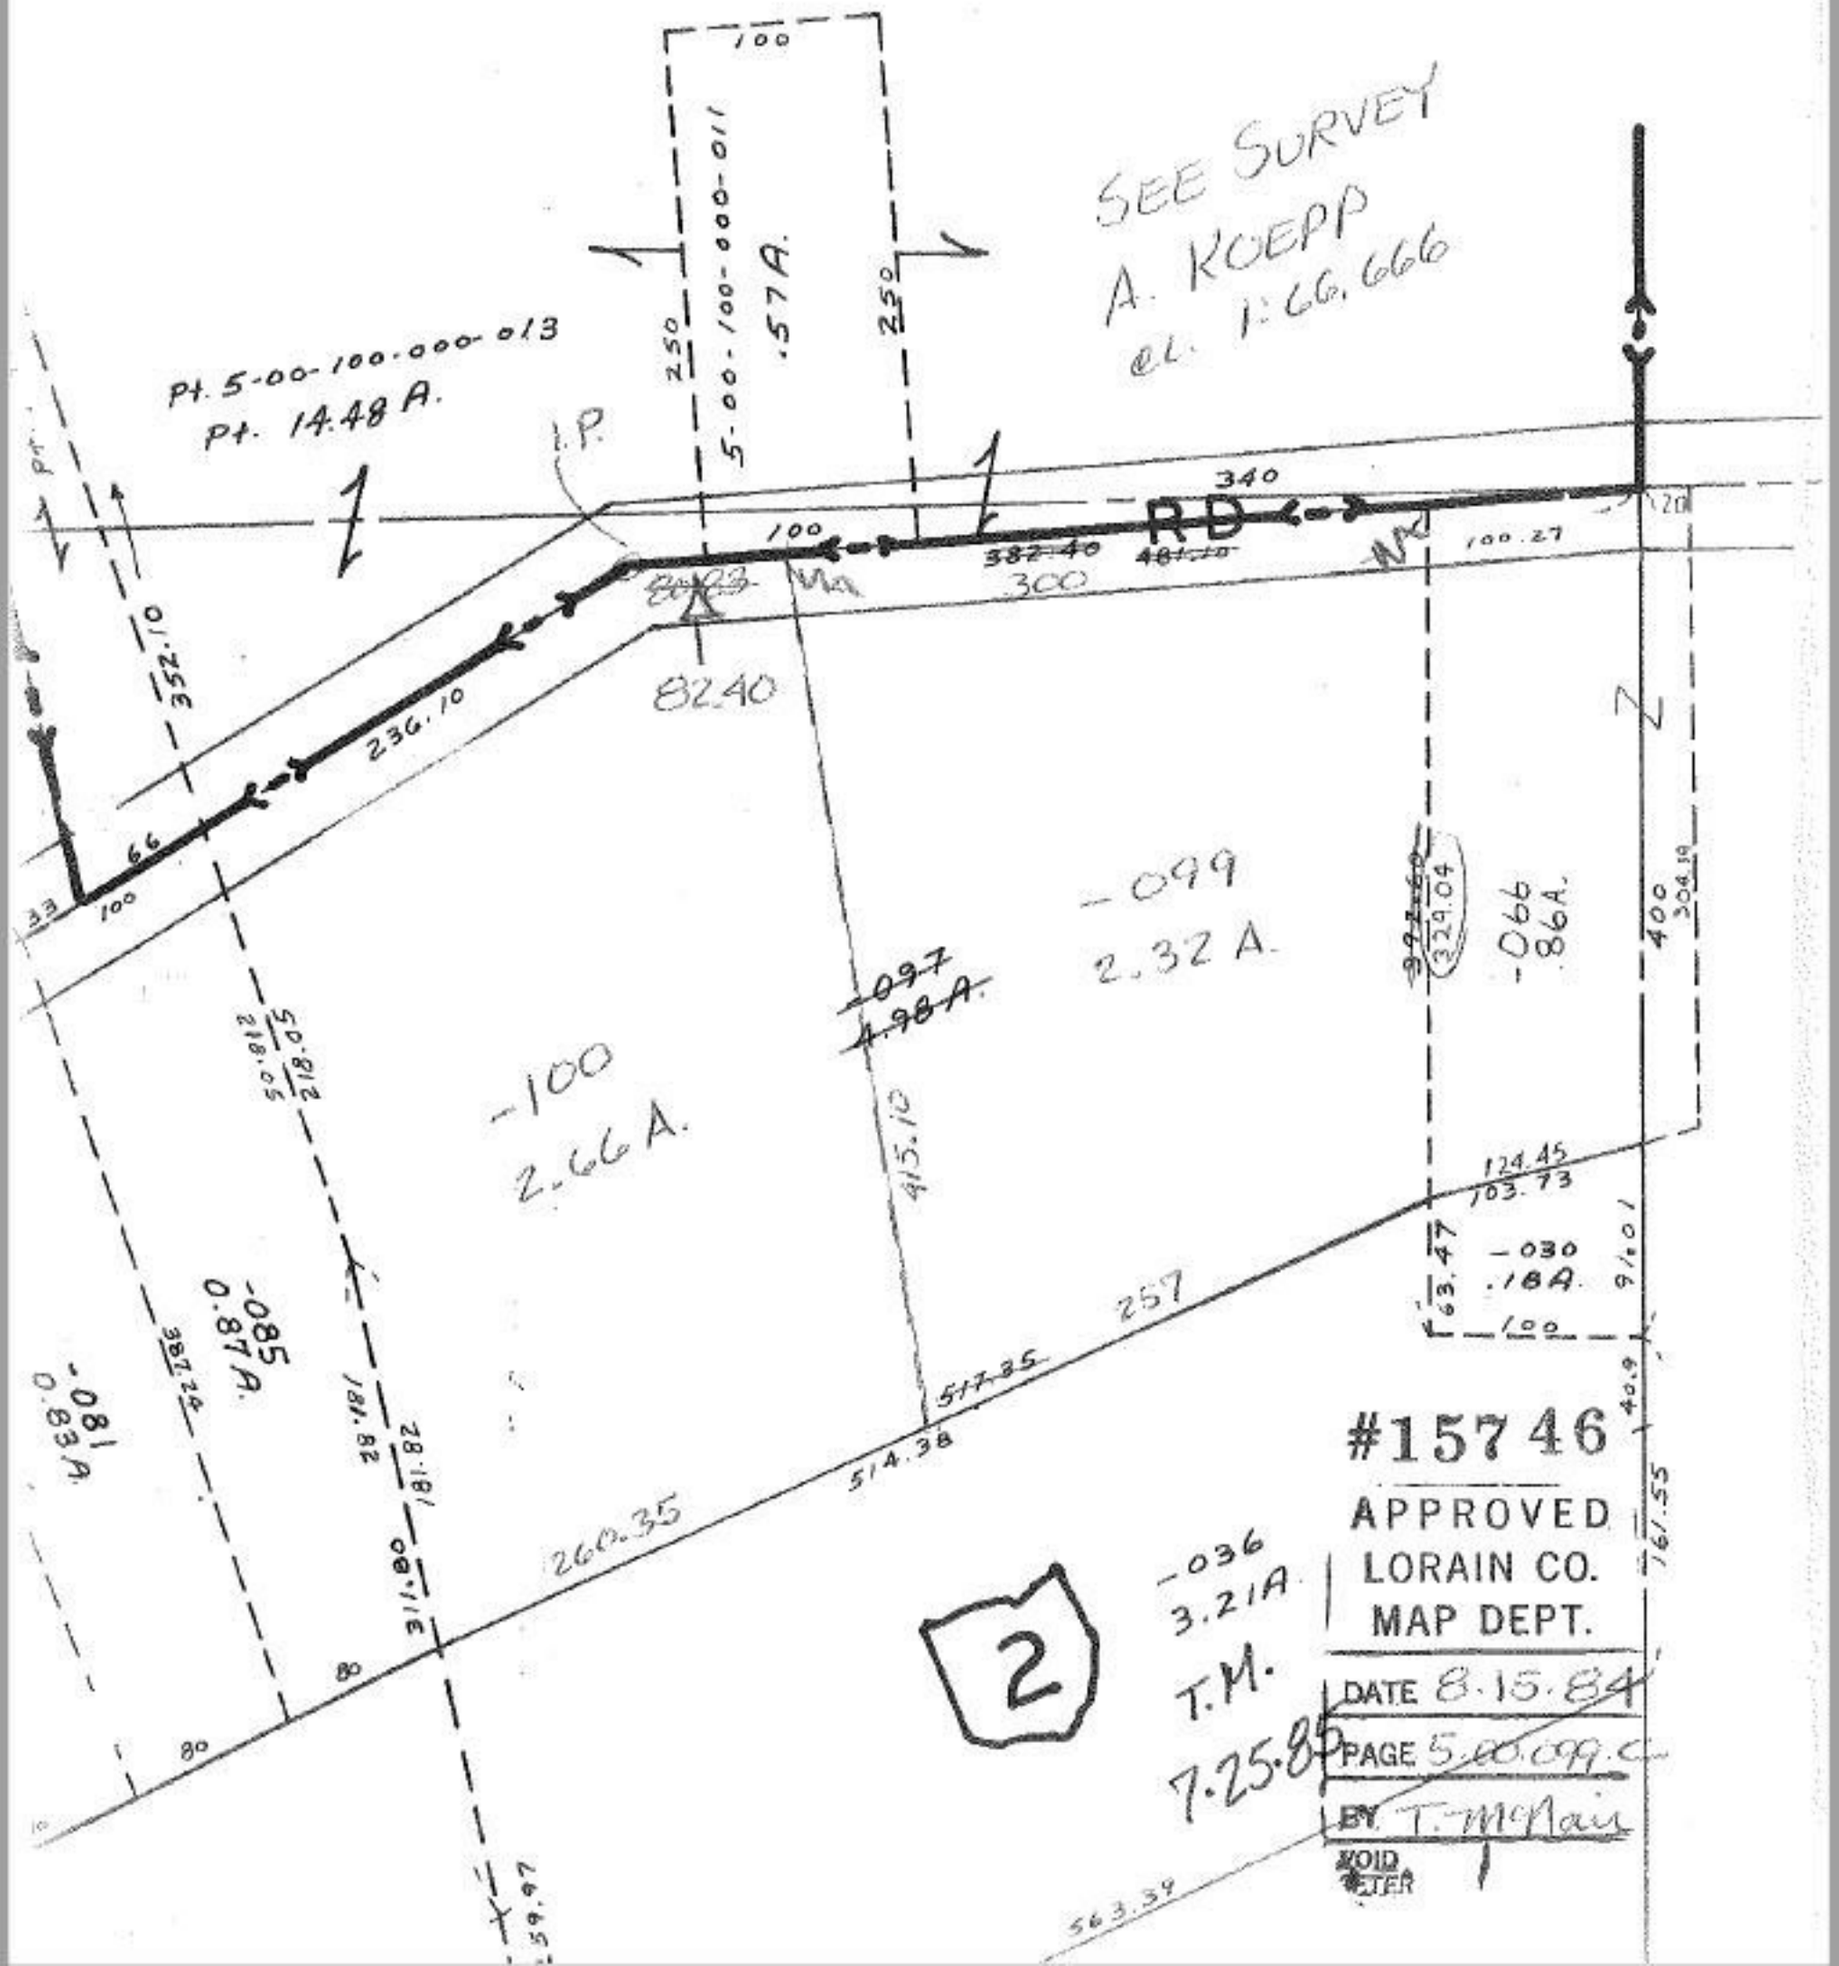
SEE SURVEY
A. KOEPP
@ 1:66.666
Pt. 5-00-100-000-013
Pt. 14.48 A.
5-00-100-000-011
.57 A.
100
250
250
340
RD
382.40
300
100.27
352.10
236.10
82.40
-099
2.32 A.
-097
4.98 A.
-100
2.66 A.
-085
0.87 A.
-081
0.83 A.
-036
3.21 A.
T.M.
7.25.85
415.10
517.35
514.38
260.35
257
124.45
103.73
329.04
-066
8.6 A.
400
304.19
-030
.18 A.
100
91.01
40.9
161.55
563.39
#15746
APPROVED
LORAIN CO.
MAP DEPT.
DATE 8.15.84
PAGE 5.00.09.C
BY T. McNair
VOID AFTER
2