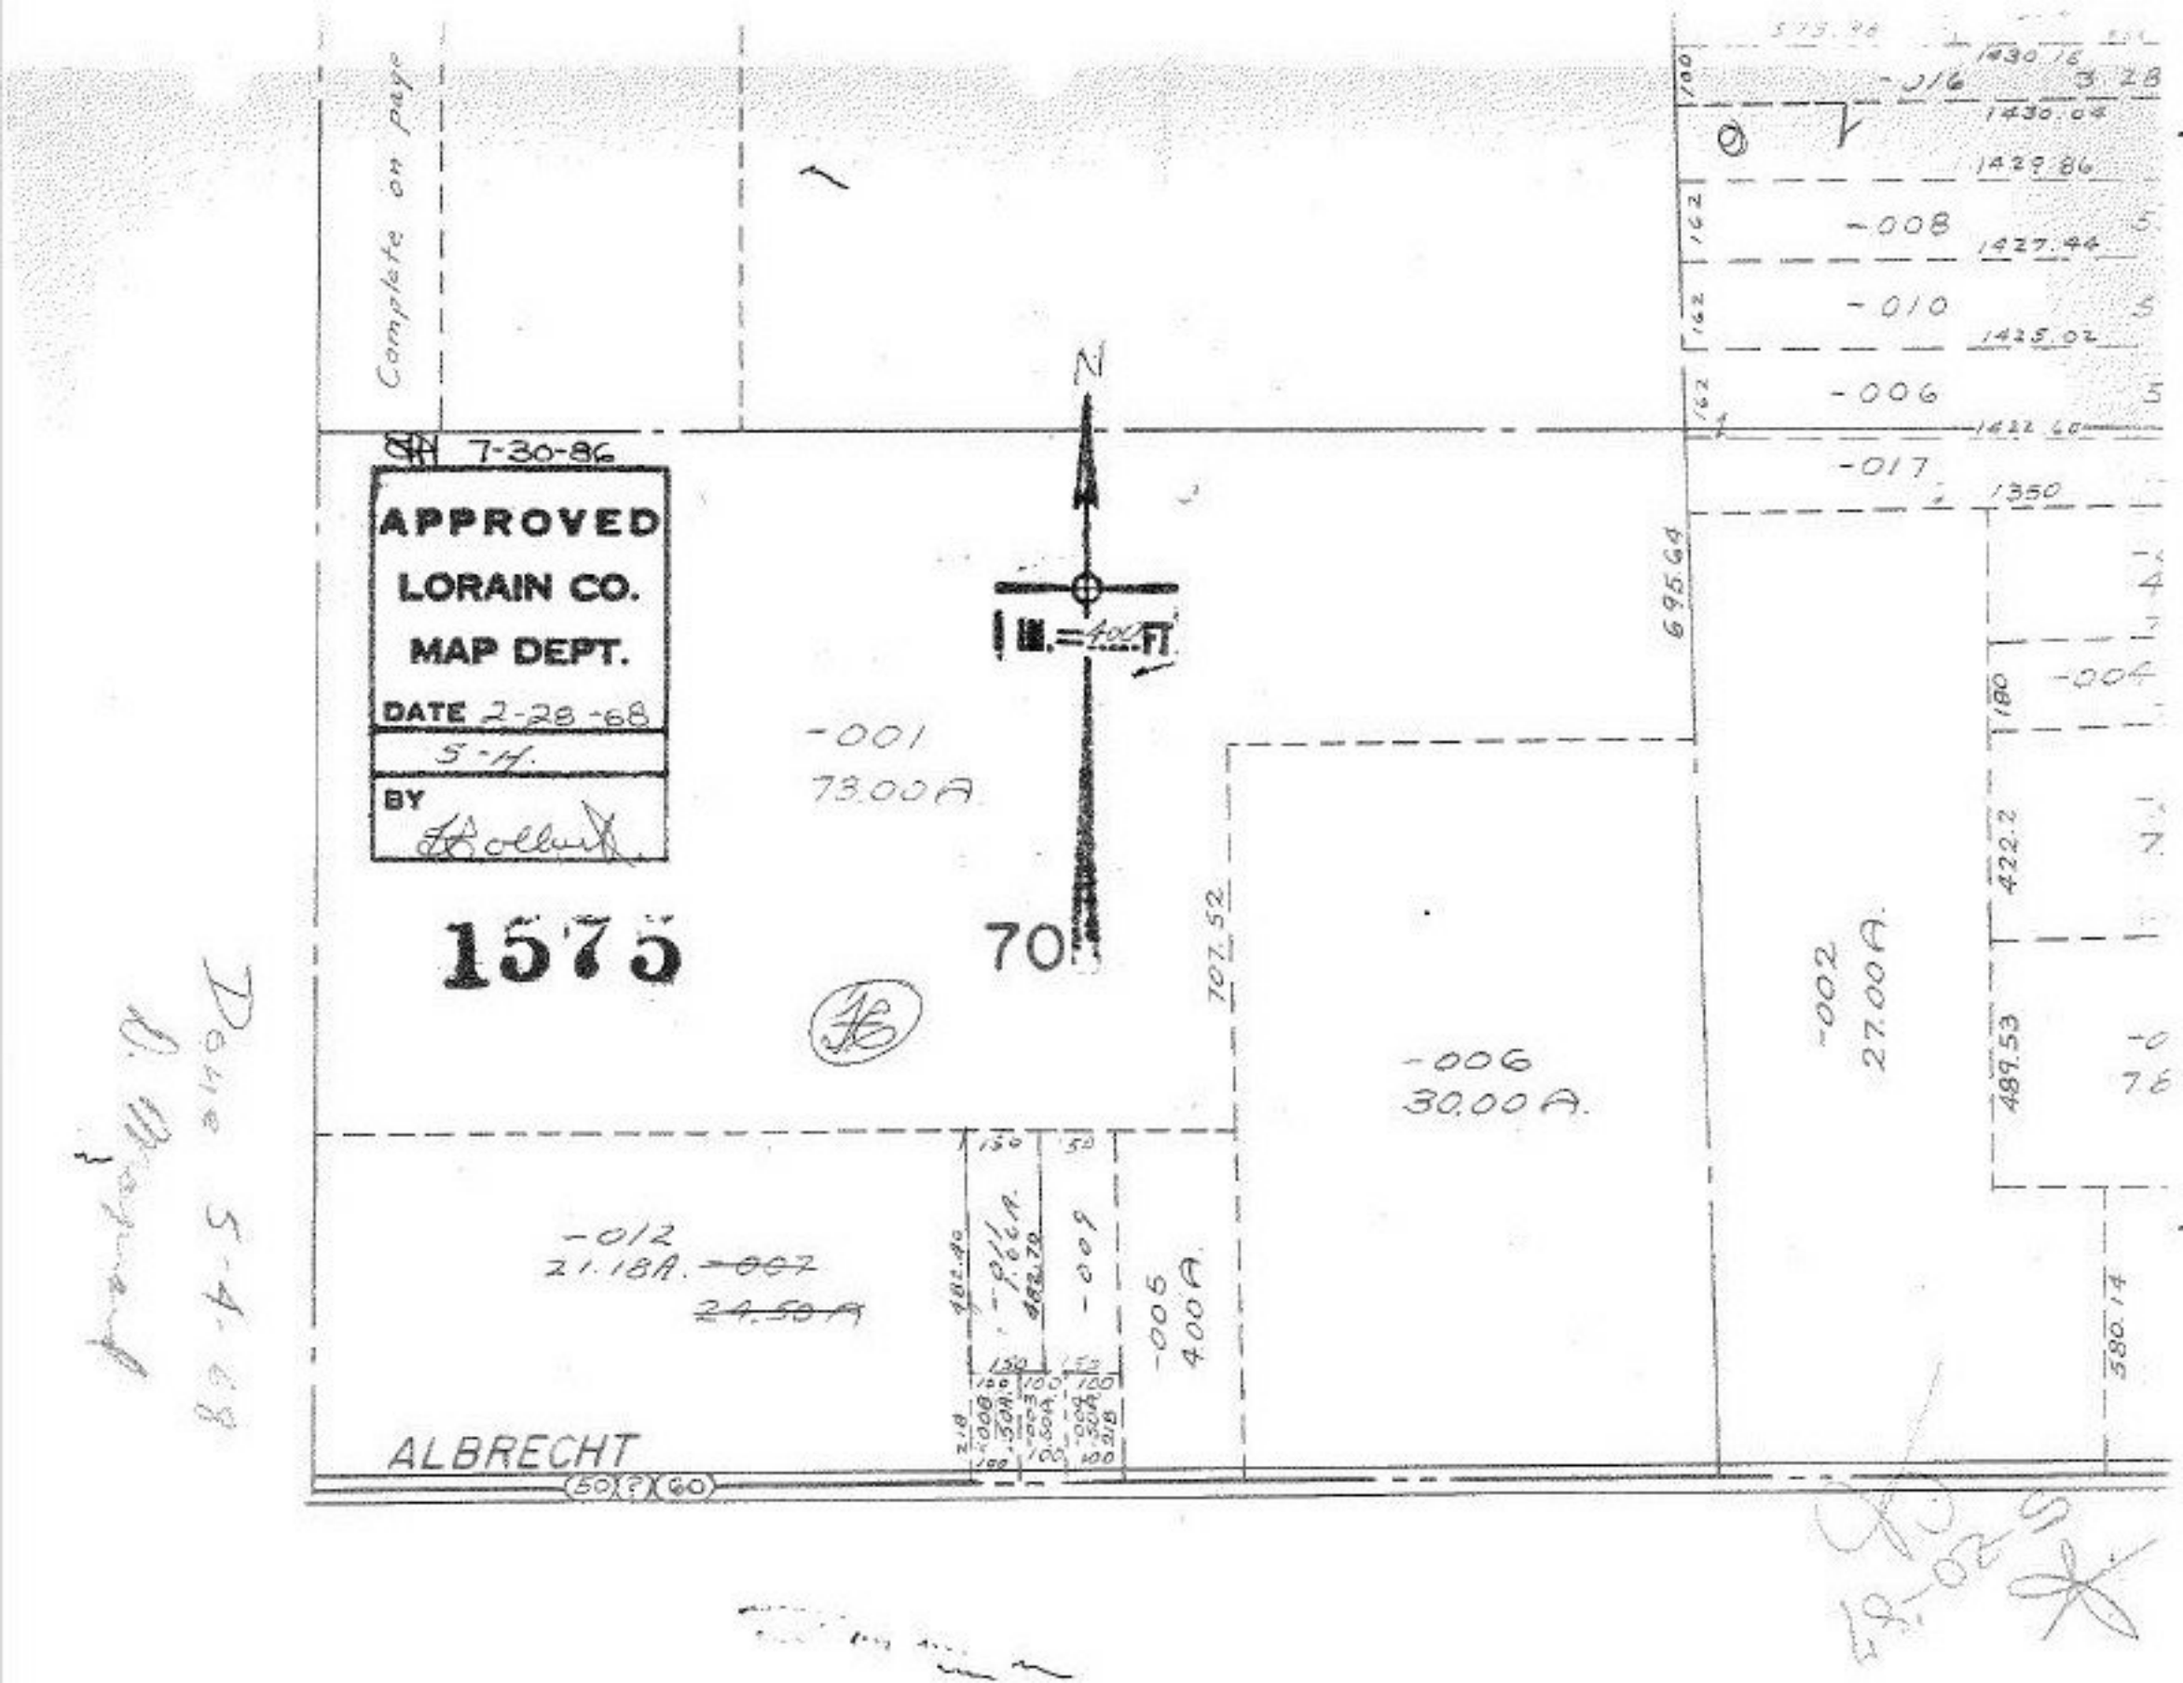
Complete on page
SH 7-30-86
APPROVED
LORAIN CO.
MAP DEPT.
DATE 2-28-68
S-H.
BY
1575
1 IN. = 100 FT.
N
-001
73.00A.
-006
30.00A.
-002
27.00A.
-012
21.18A.
-005
400A.
-009
-016
-008
-010
-006
-017
-004
695.64
707.52
422.2
489.53
380.14
1430.16
1430.04
1429.86
1427.44
1425.02
1422.60
1350
ALBRECHT
(50 ? X 60)