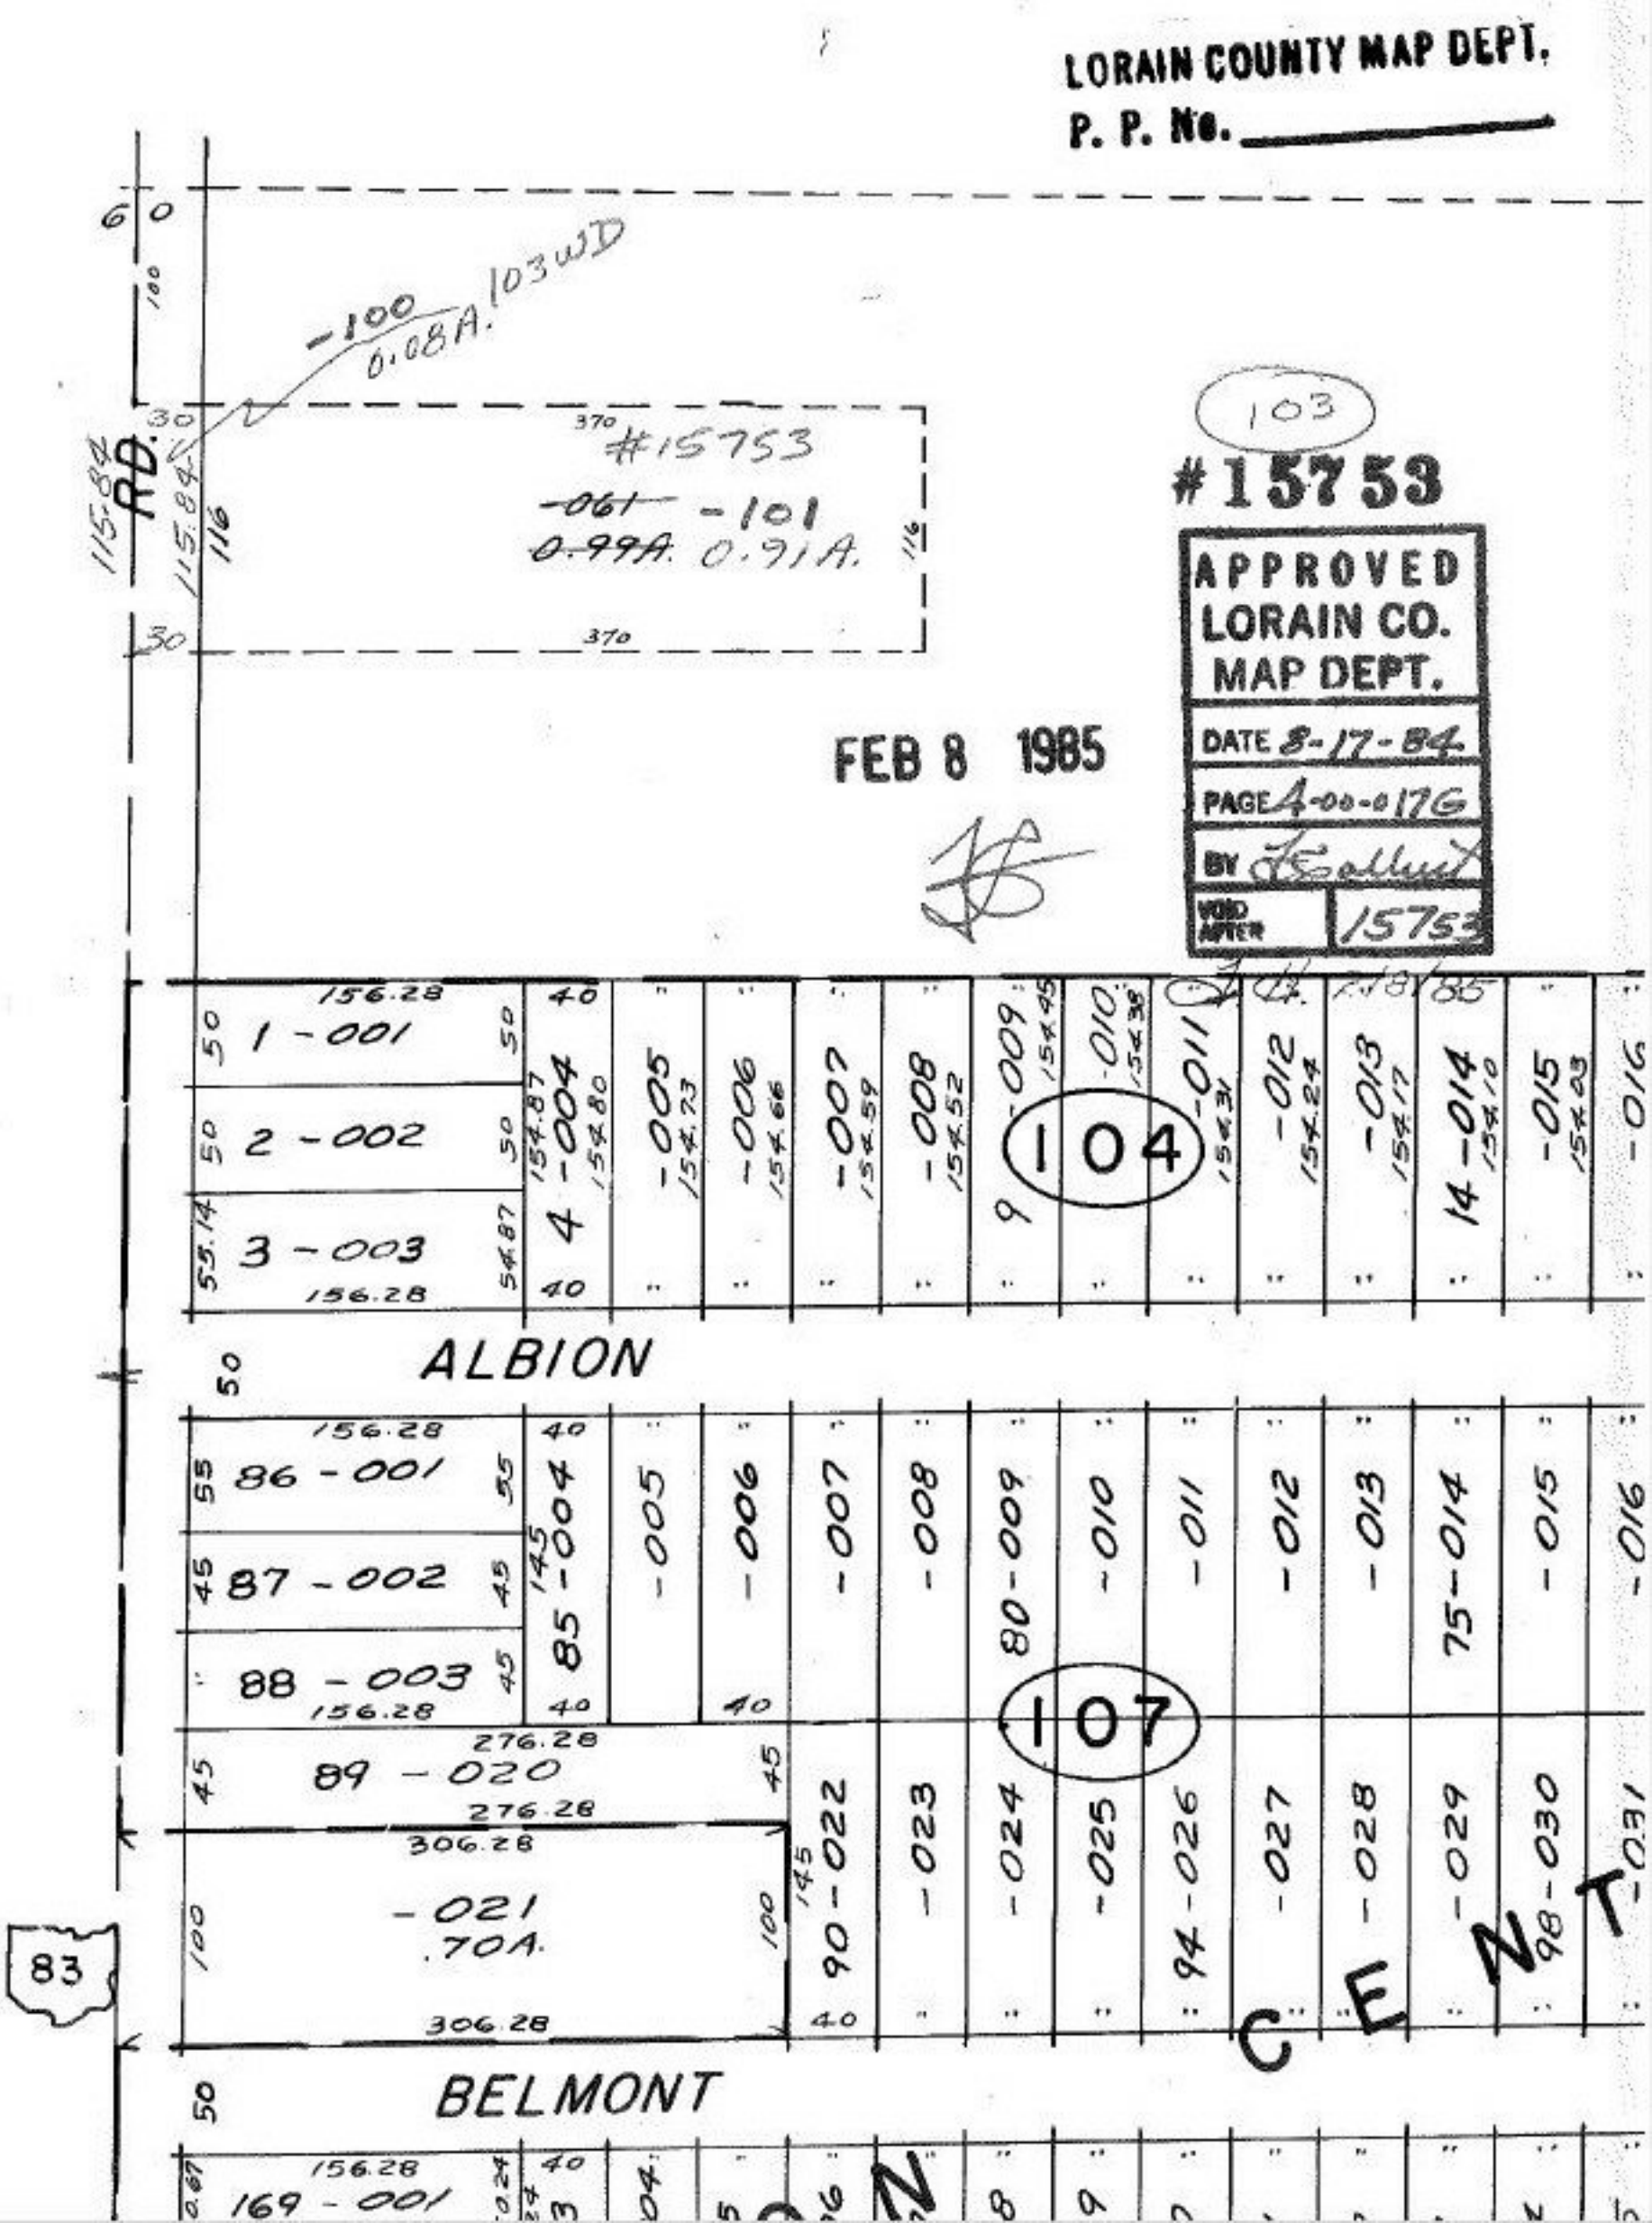
LORAIN COUNTY MAP DEPT.
P. P. No.
103
#15753
APPROVED
LORAIN CO.
MAP DEPT.
DATE 8-17-84
PAGE 4-00-017G
BY
VOID AFTER 15753
FEB 8 1985
-100
0.08A.
103WD
#15753
-061
0.99A.
-101
0.91A.
RD.
115.84
116
370
104
1-001
2-002
3-003
4-004
-005
-006
-007
-008
9-009
-010
-011
-012
-013
14-014
-015
-016
ALBION
86-001
87-002
88-003
85-004
-005
-006
-007
-008
80-009
-010
-011
-012
-013
75-014
-015
-016
107
89-020
-021
.70A.
90-022
-023
-024
-025
94-026
-027
-028
-029
98-030
-031
83
BELMONT
169-001
CENT