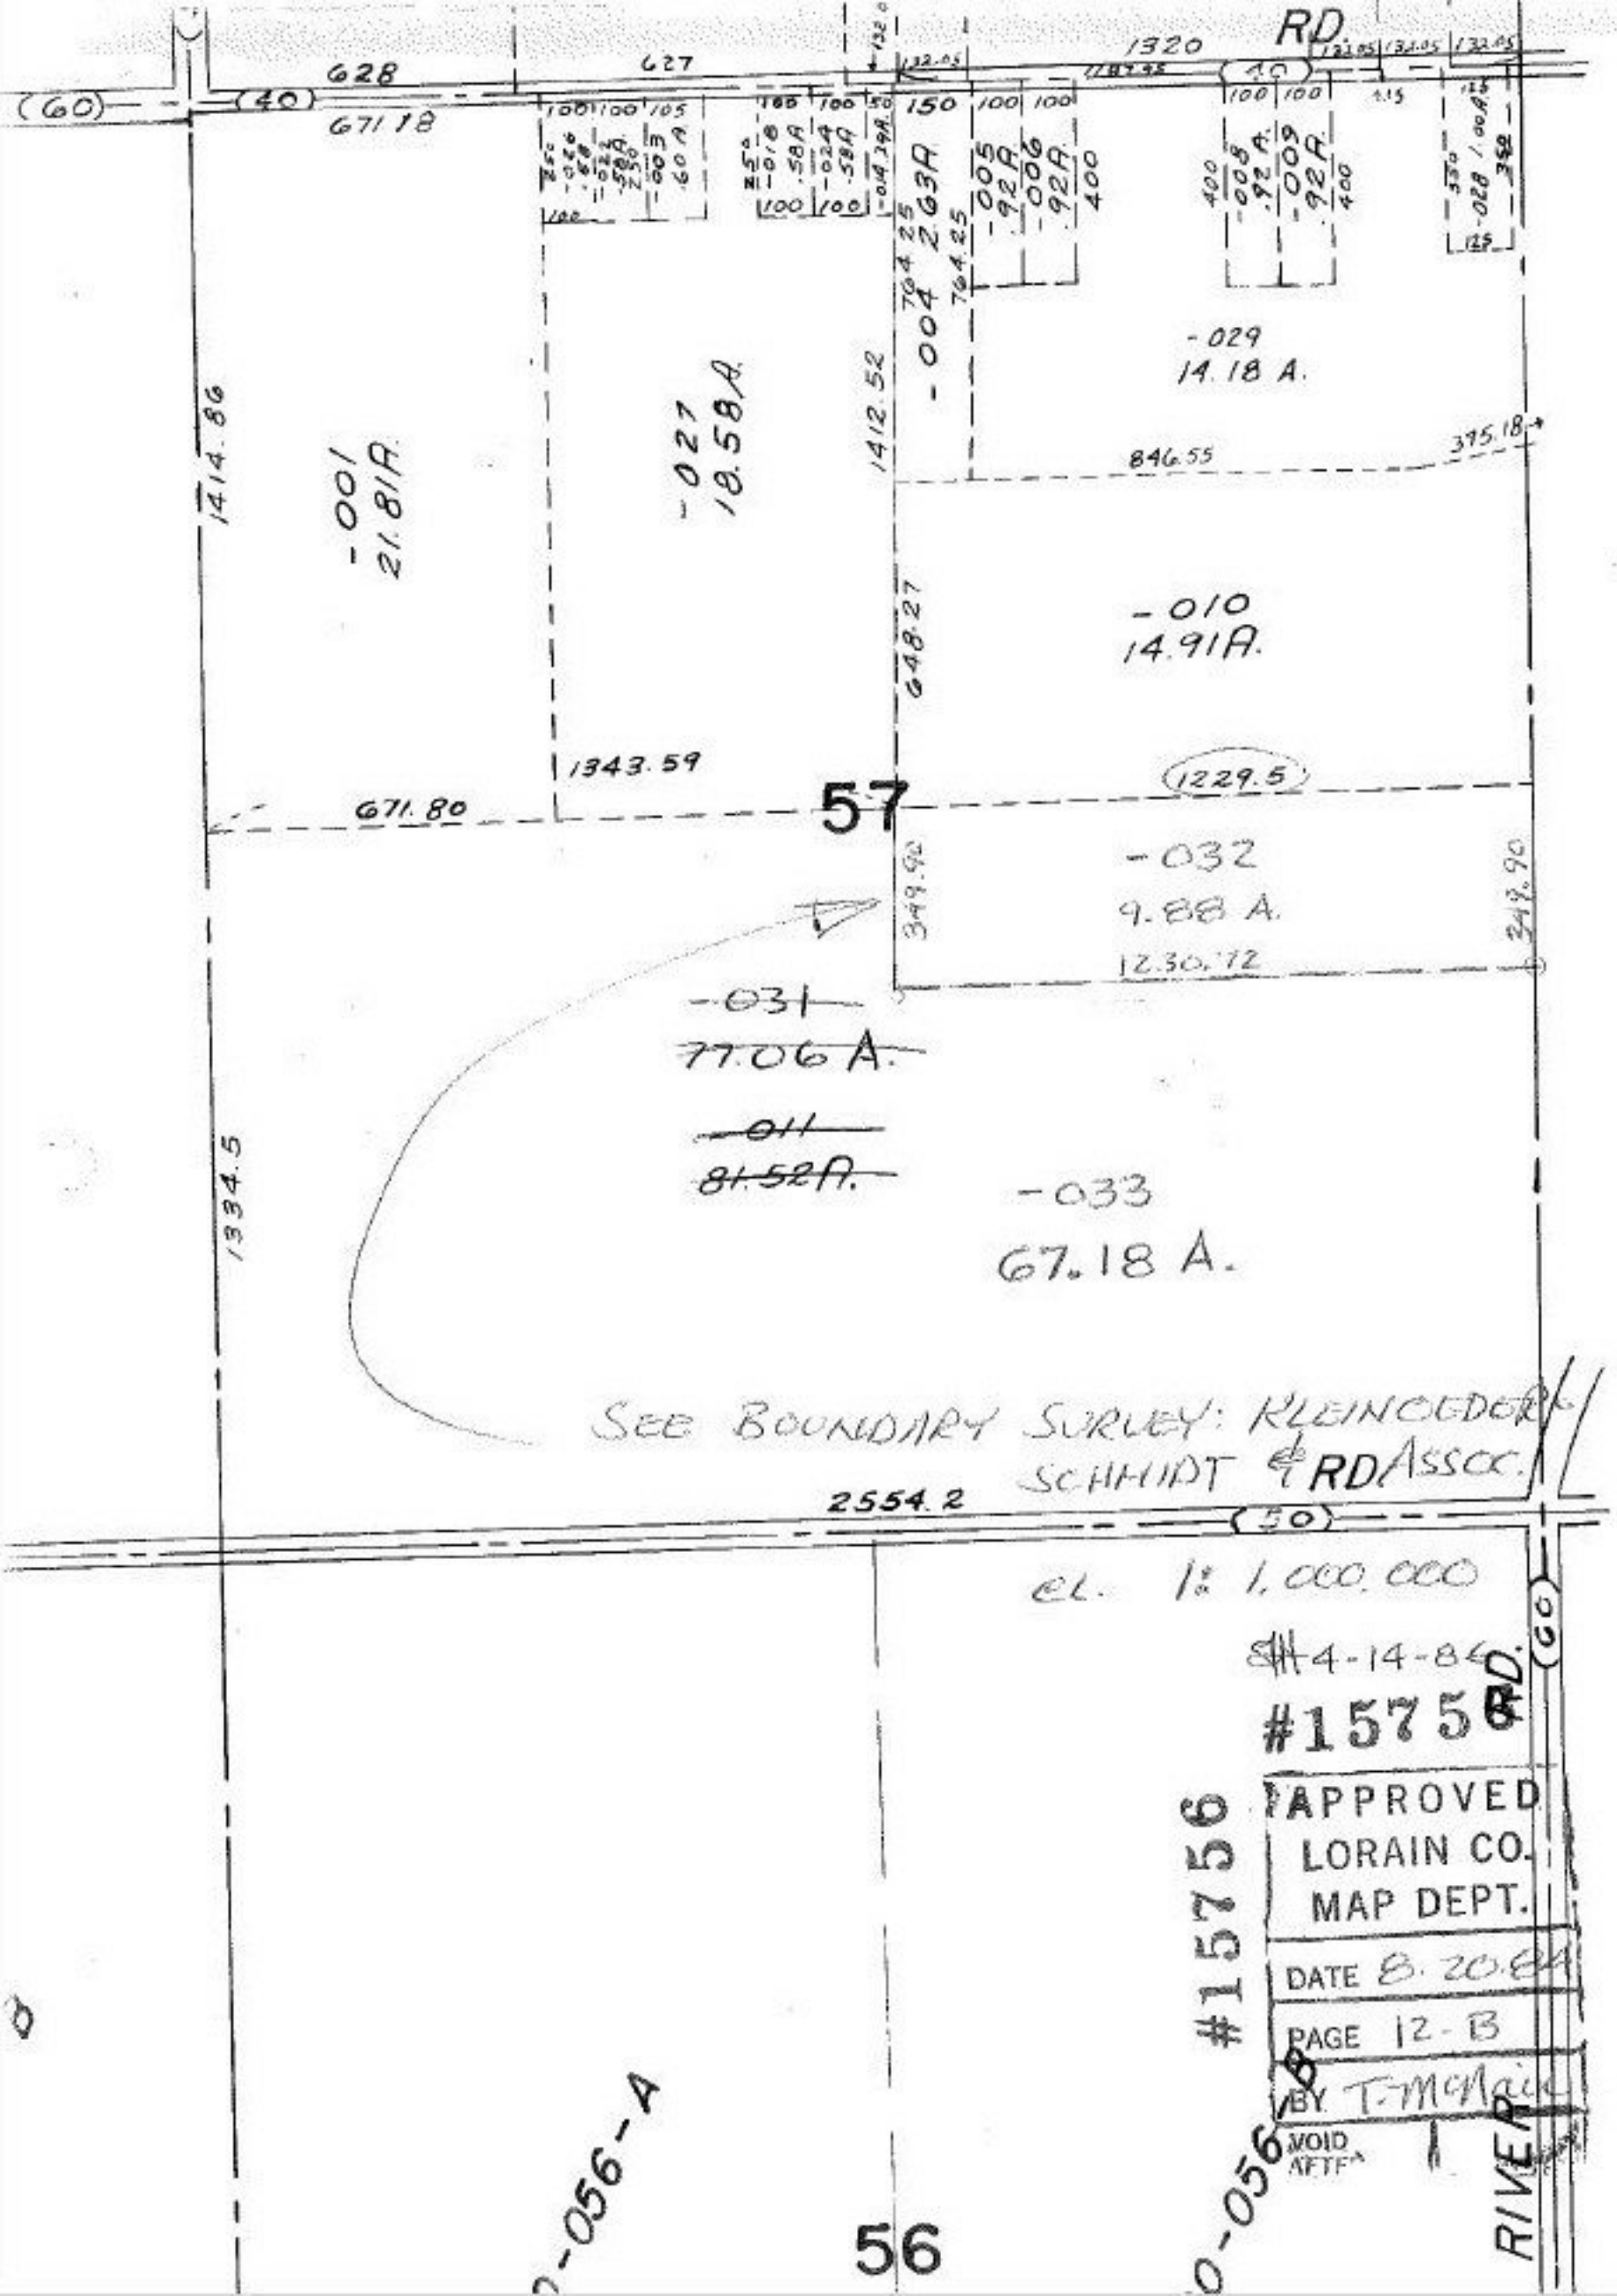

RD.
1320
628
627
(60)
(40)
671.18
150
-004 2.63A
-005 .92A
-006 .92A
-008 .92A
-009 .92A
-029
14.18 A.
-027
18.58A
-001
21.81A
1414.86
1412.52
846.55
375.18
648.27
-010
14.91A.
1343.59
1229.5
671.80
57
-032
9.88 A.
349.90
12.30.72
-031
77.06 A.
-011
81.52A.
-033
67.18 A.
1334.5
SEE BOUNDARY SURVEY: KLEINOEDER & SCHMIDT & RD ASSOC.
2554.2
(50)
CL. 1: 1,000,000
4-14-86
#15756
APPROVED
LORAIN CO.
MAP DEPT.
DATE 8.20.84
PAGE 12-B
BY T. McNair
VOID AFTER
RIVER
-056-A
56