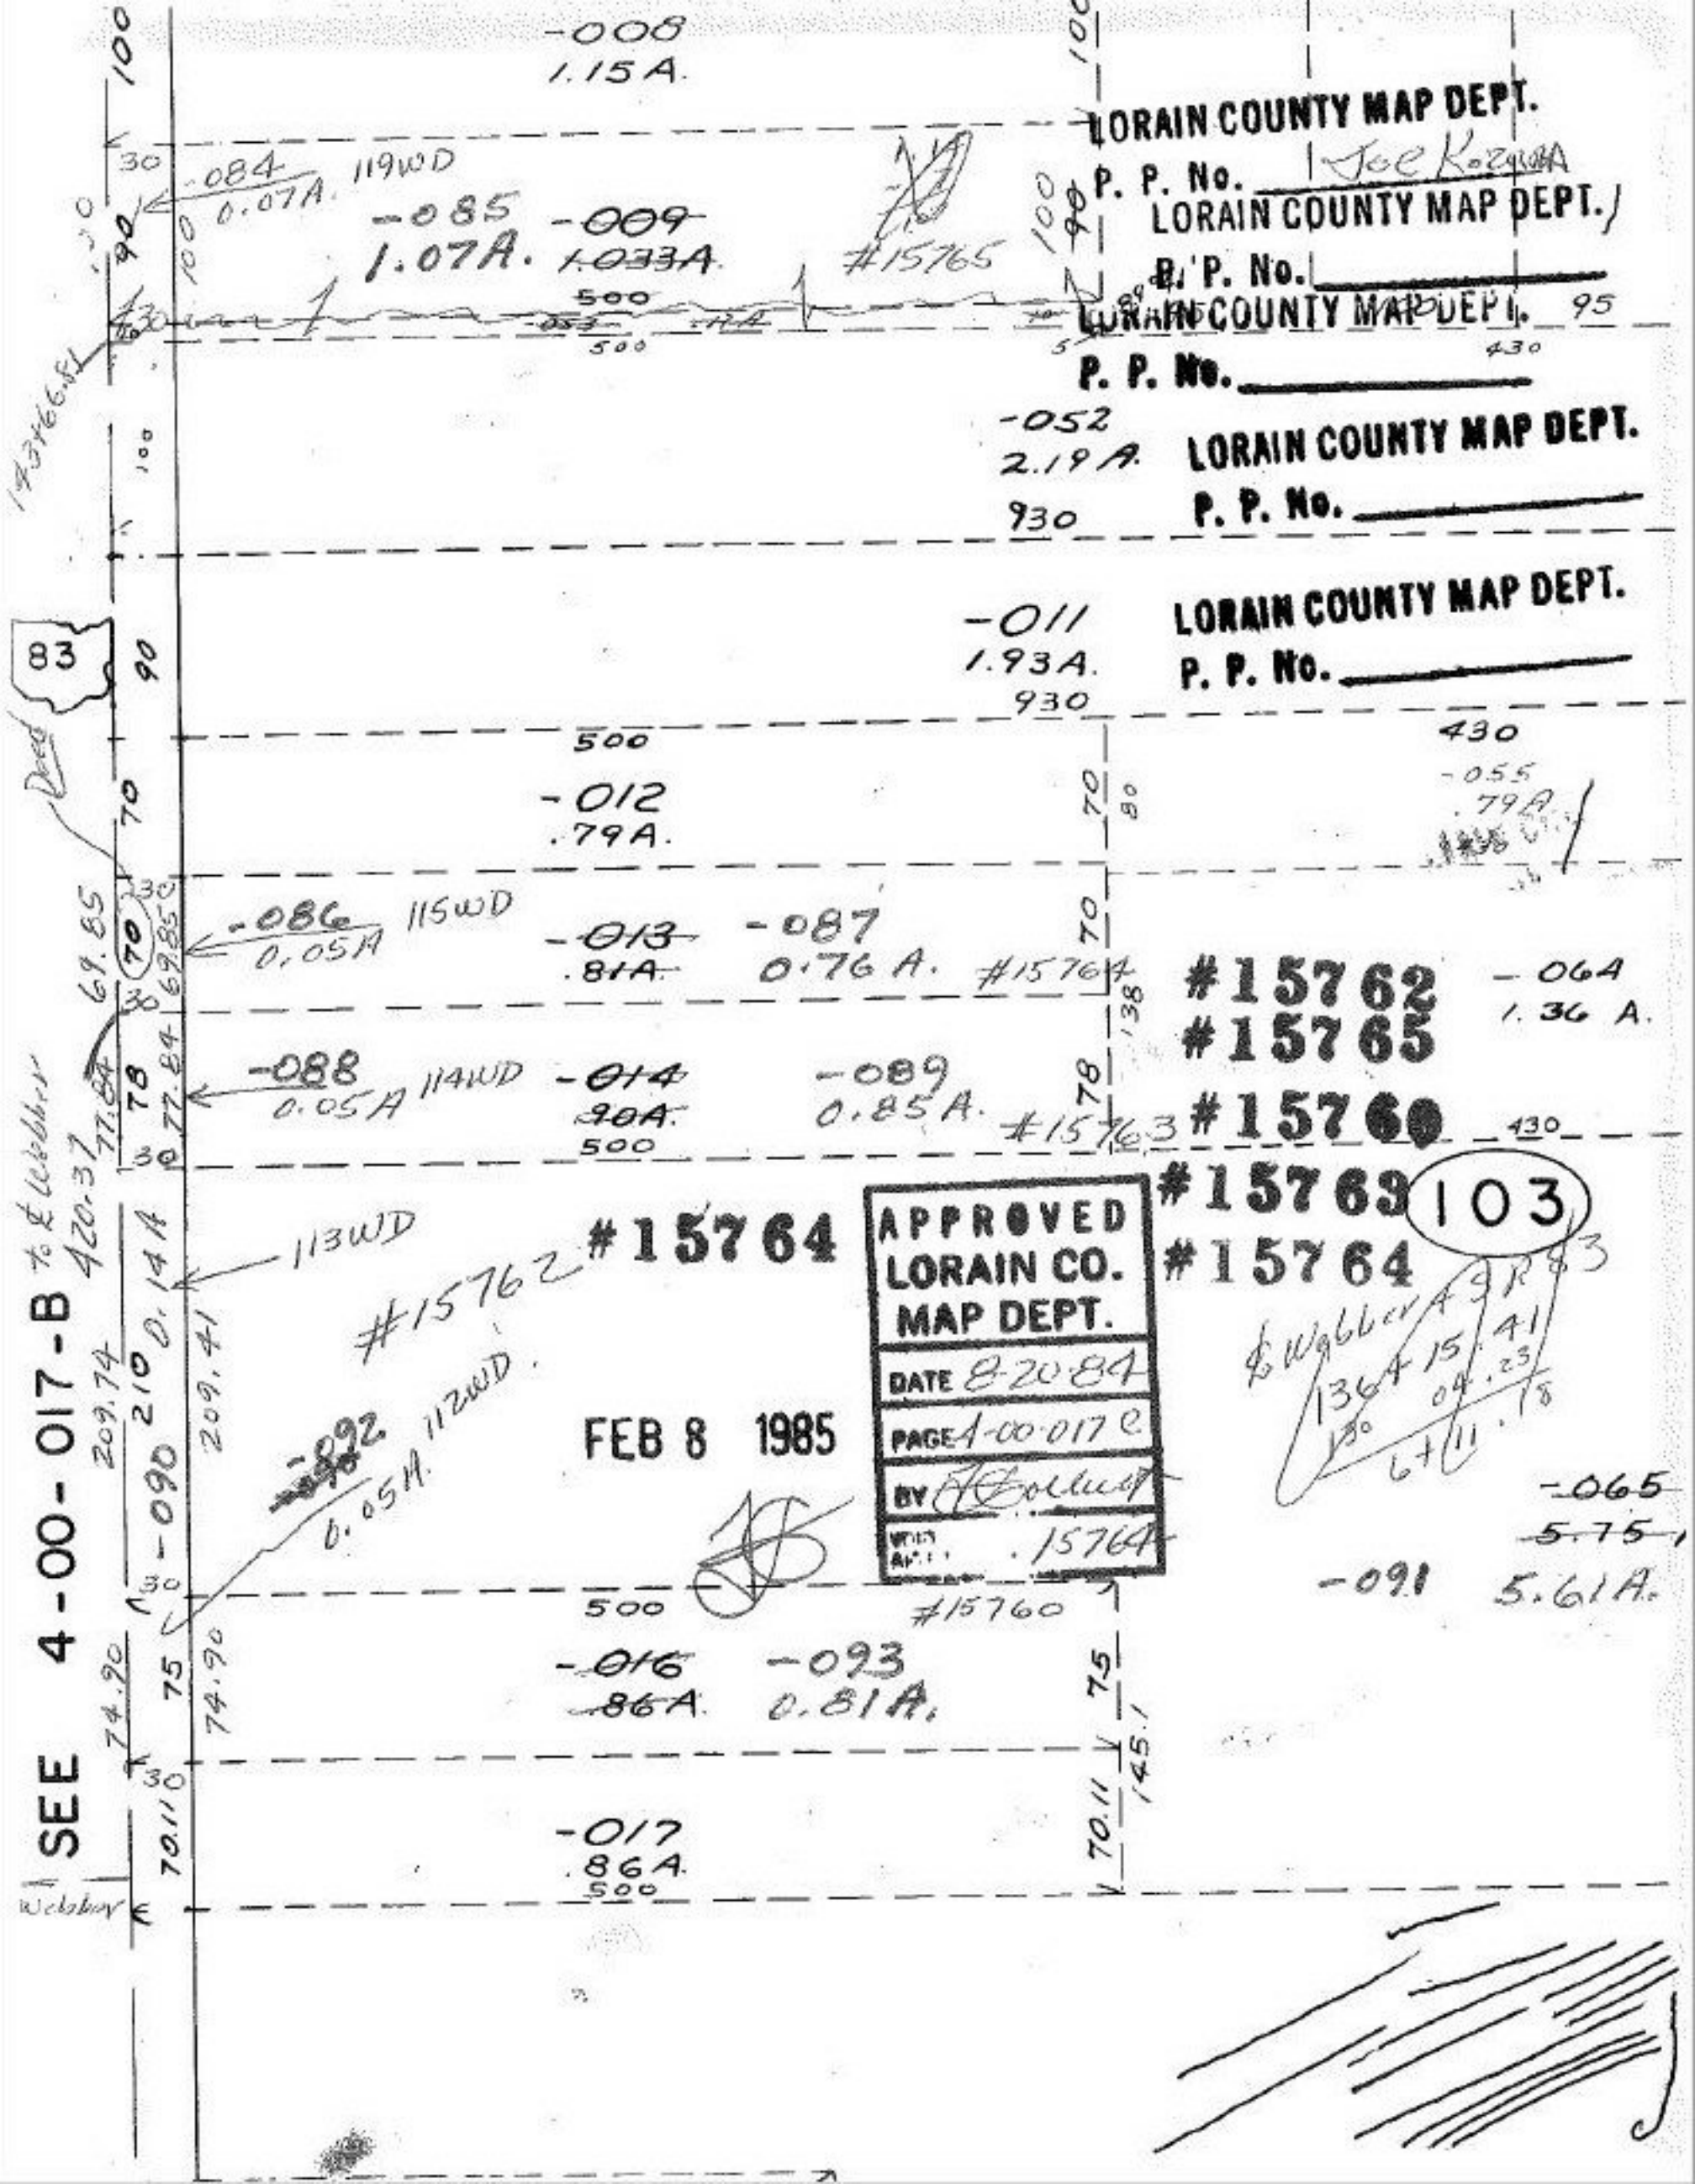

-008
1.15A.
LORAIN COUNTY MAP DEPT.
P. P. No. Joe Kozuba
LORAIN COUNTY MAP DEPT.
P. P. No.
LORAIN COUNTY MAP DEPT.
P. P. No.
-084
0.07A.
119WD
-085
1.07A.
-009
1.033A.
#15765
500
-052
2.19A.
930
LORAIN COUNTY MAP DEPT.
P. P. No.
-011
1.93A.
930
LORAIN COUNTY MAP DEPT.
P. P. No.
83
500
-012
.79A.
430
-055
.79A.
-086
0.05A
115WD
-013
.81A.
-087
0.76 A.
#15764
#15762
#15765
-064
1.36 A.
-088
0.05A
114WD
-014
.90A.
-089
0.85A.
#15763
#15760
430
#15763
103
#15764
113WD
#15762
#15764
APPROVED
LORAIN CO.
MAP DEPT.
DATE 8-20-84
PAGE 4-00-017 C
BY
VOID AFTER .15764
FEB 8 1985
-092
0.05A.
112WD
-090
0.14A
-065
5.75
-091
5.61A.
500
#15760
-016
.86A.
-093
0.81A.
-017
.86A.
500
SEE 4-00-017-B
Webber