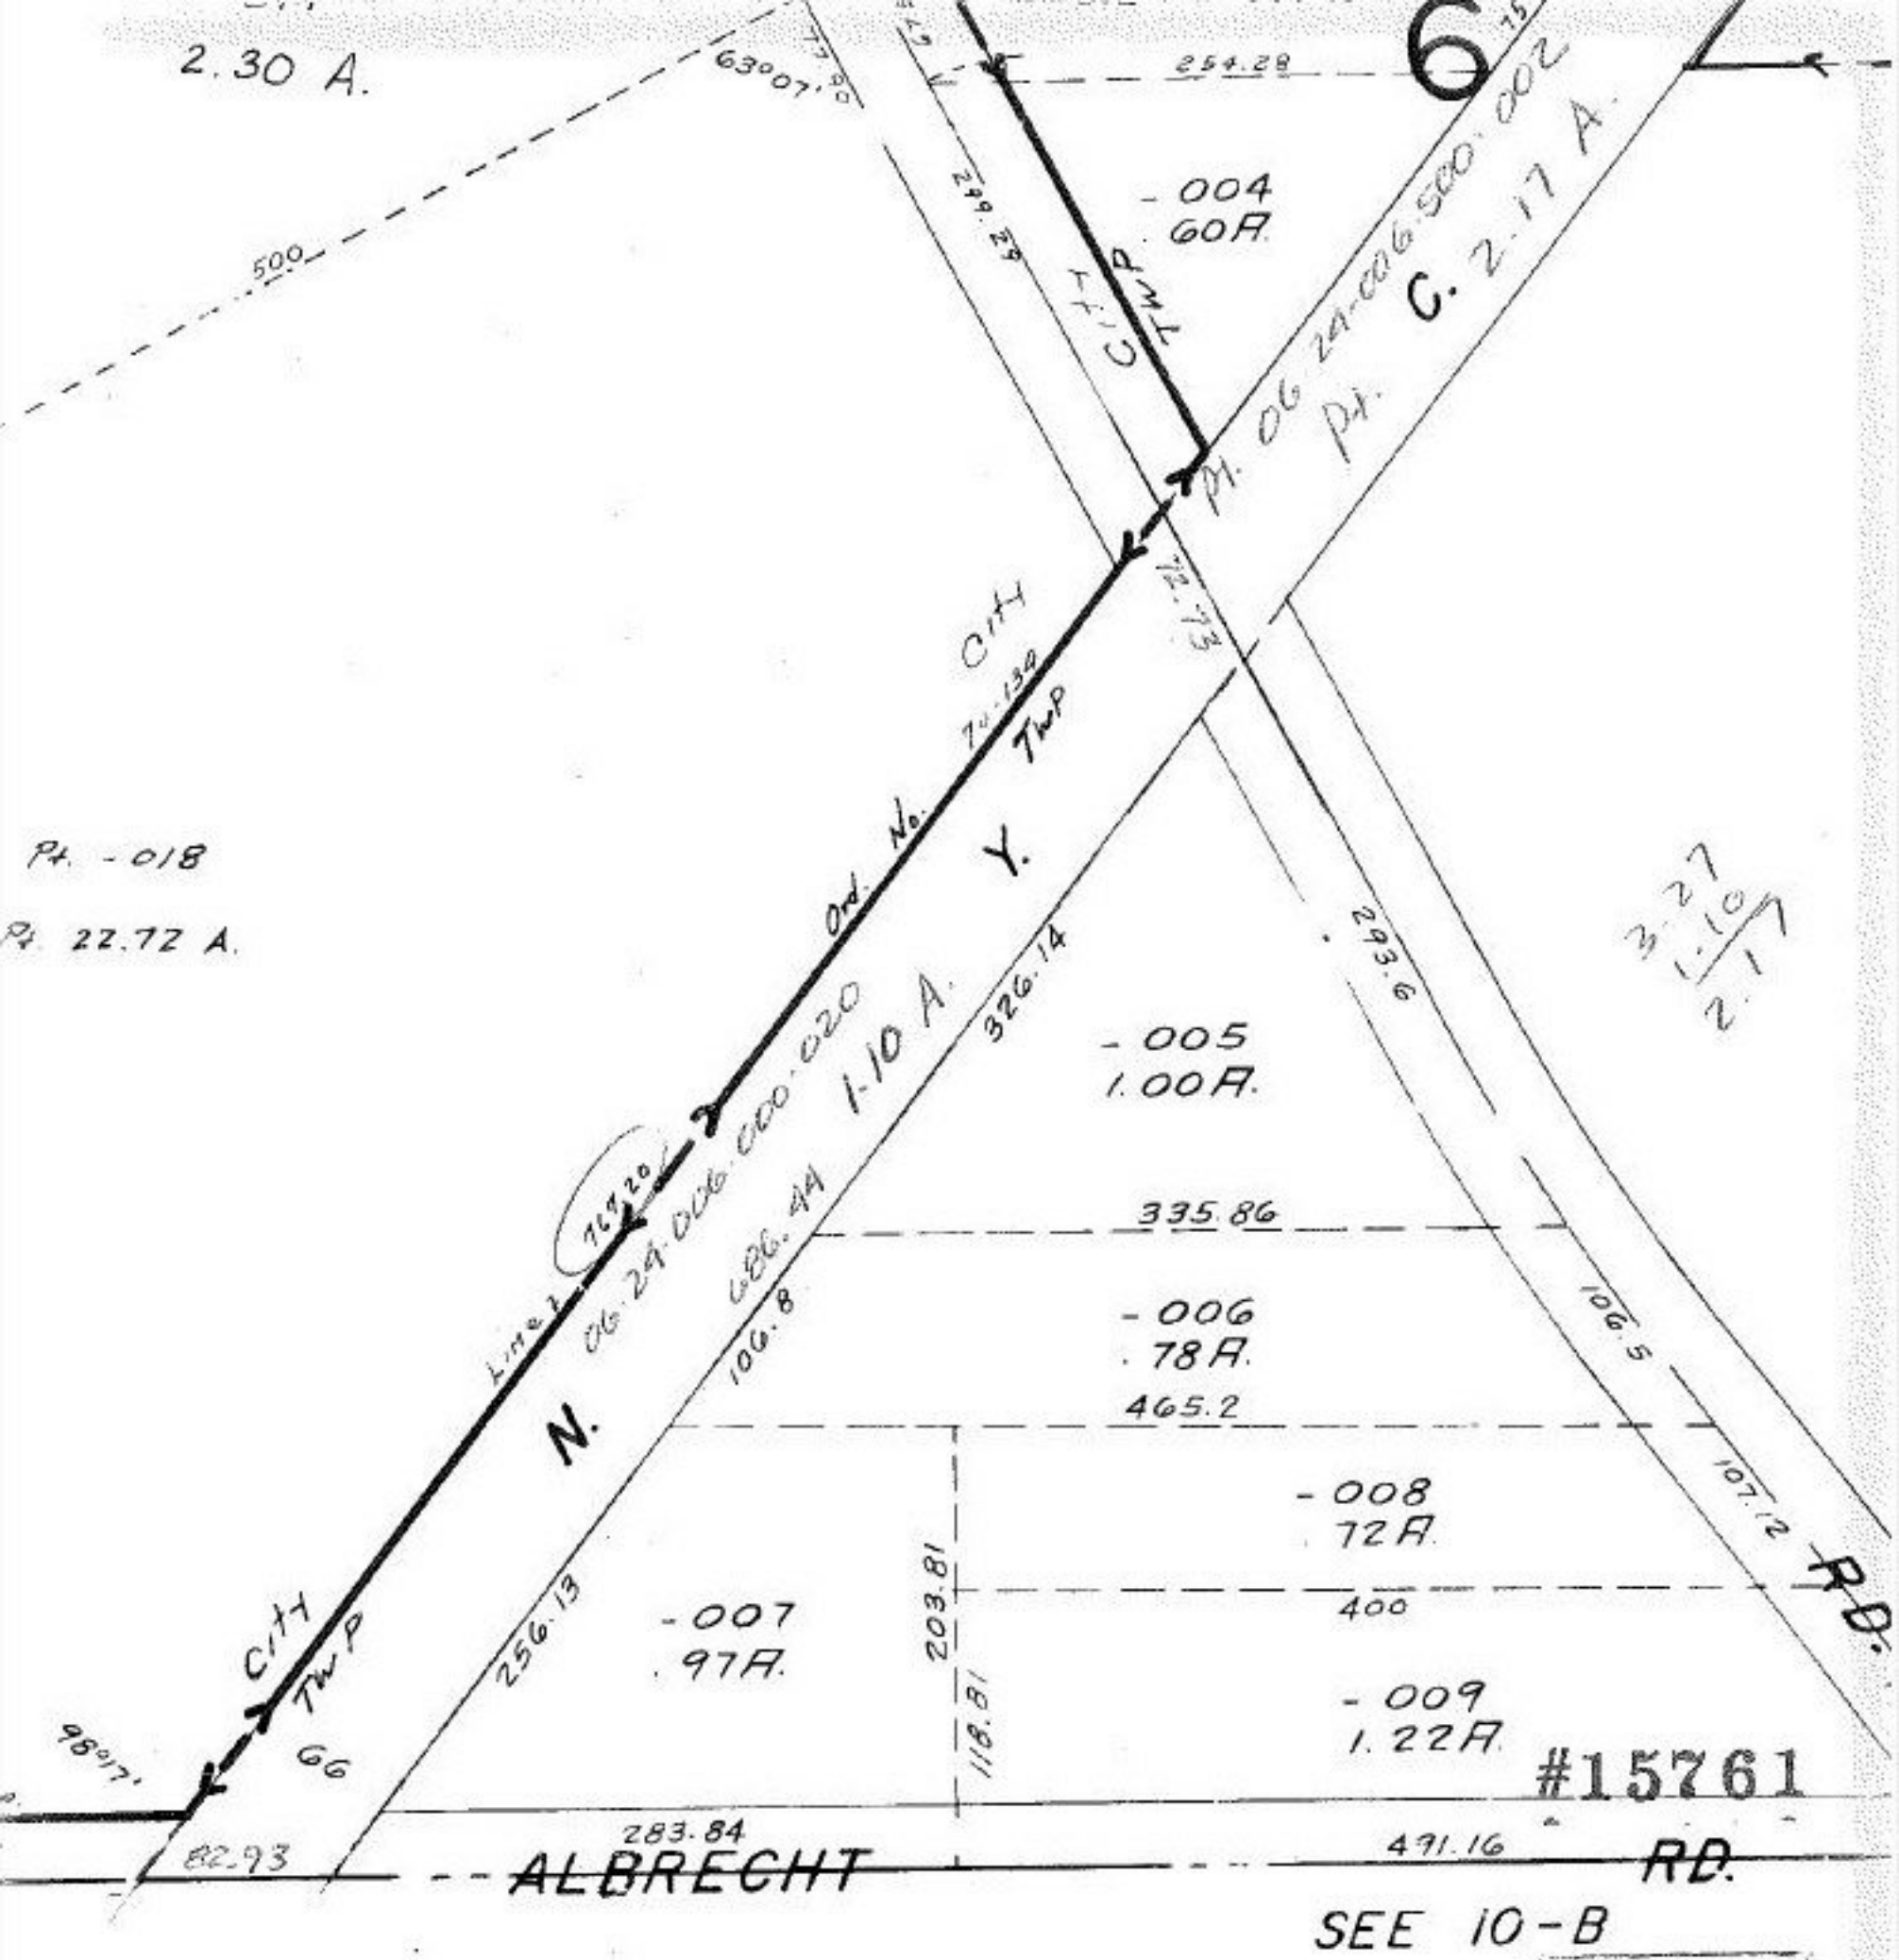

APPROVED
LORAIN CO.
MAP DEPT.
DATE 8-20-84
PAGE 6-131
BY T. McNair
VOID LETTER #15761
9-11-85

LYRIA TWP.

LE: 1" = 100'