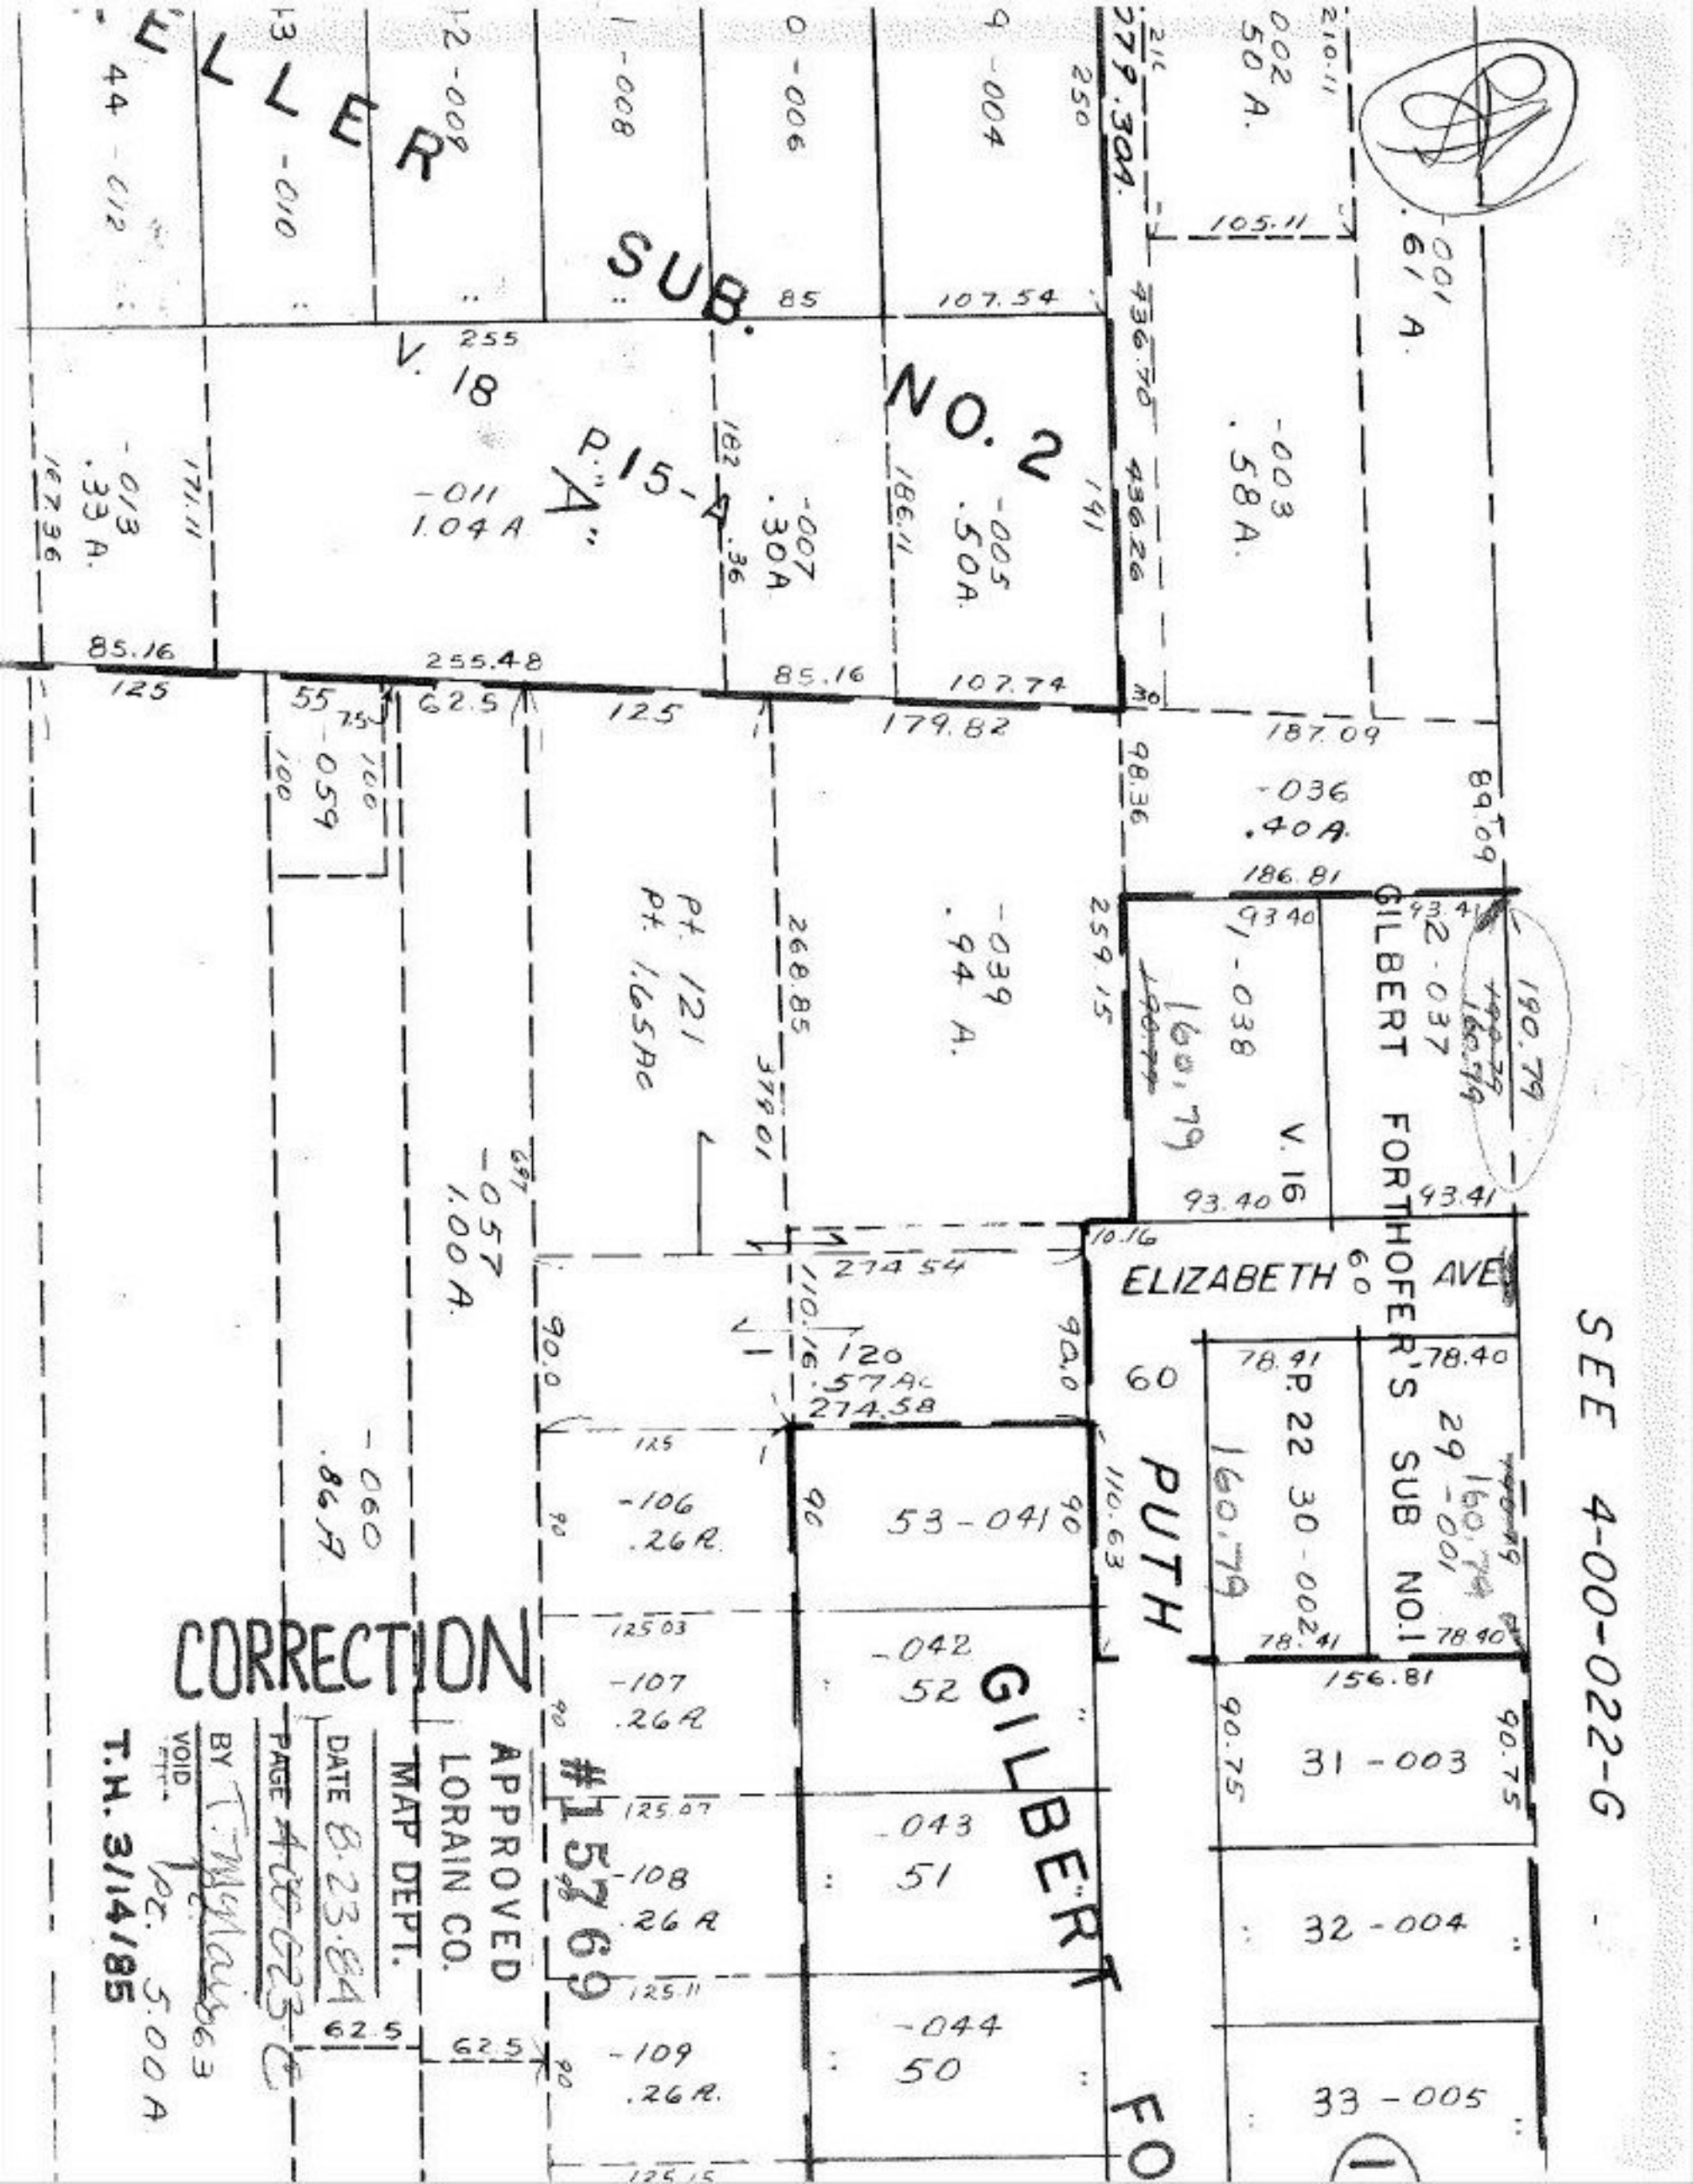

SEE 4-00-022-G
GILBERT FORTHOFER'S SUB NO.1
ELIZABETH AVE
PUTH
GILBERT
V. 18
P. 15-A
"A"
SUB. NO. 2
V. 16
P. 22 30-002
29-001
-003 .58A.
-036 .40A.
-039 .94 A.
-011 1.04 A
-013 .33 A.
-057 1.00 A.
-060 .86 A
-059
Pt. 121 Pt. 1.65Ac
-106 .26 A.
-107 .26 A
-108 .26 A
-109 .26 A.
53-041
-042 52
-043 51
-044 50
31-003
32-004
33-005
CORRECTION
#15769
APPROVED
LORAIN CO.
MAP DEPT.
DATE 8.23.84
PAGE 400023 C
BY
VOID
T.H. 3/14/85