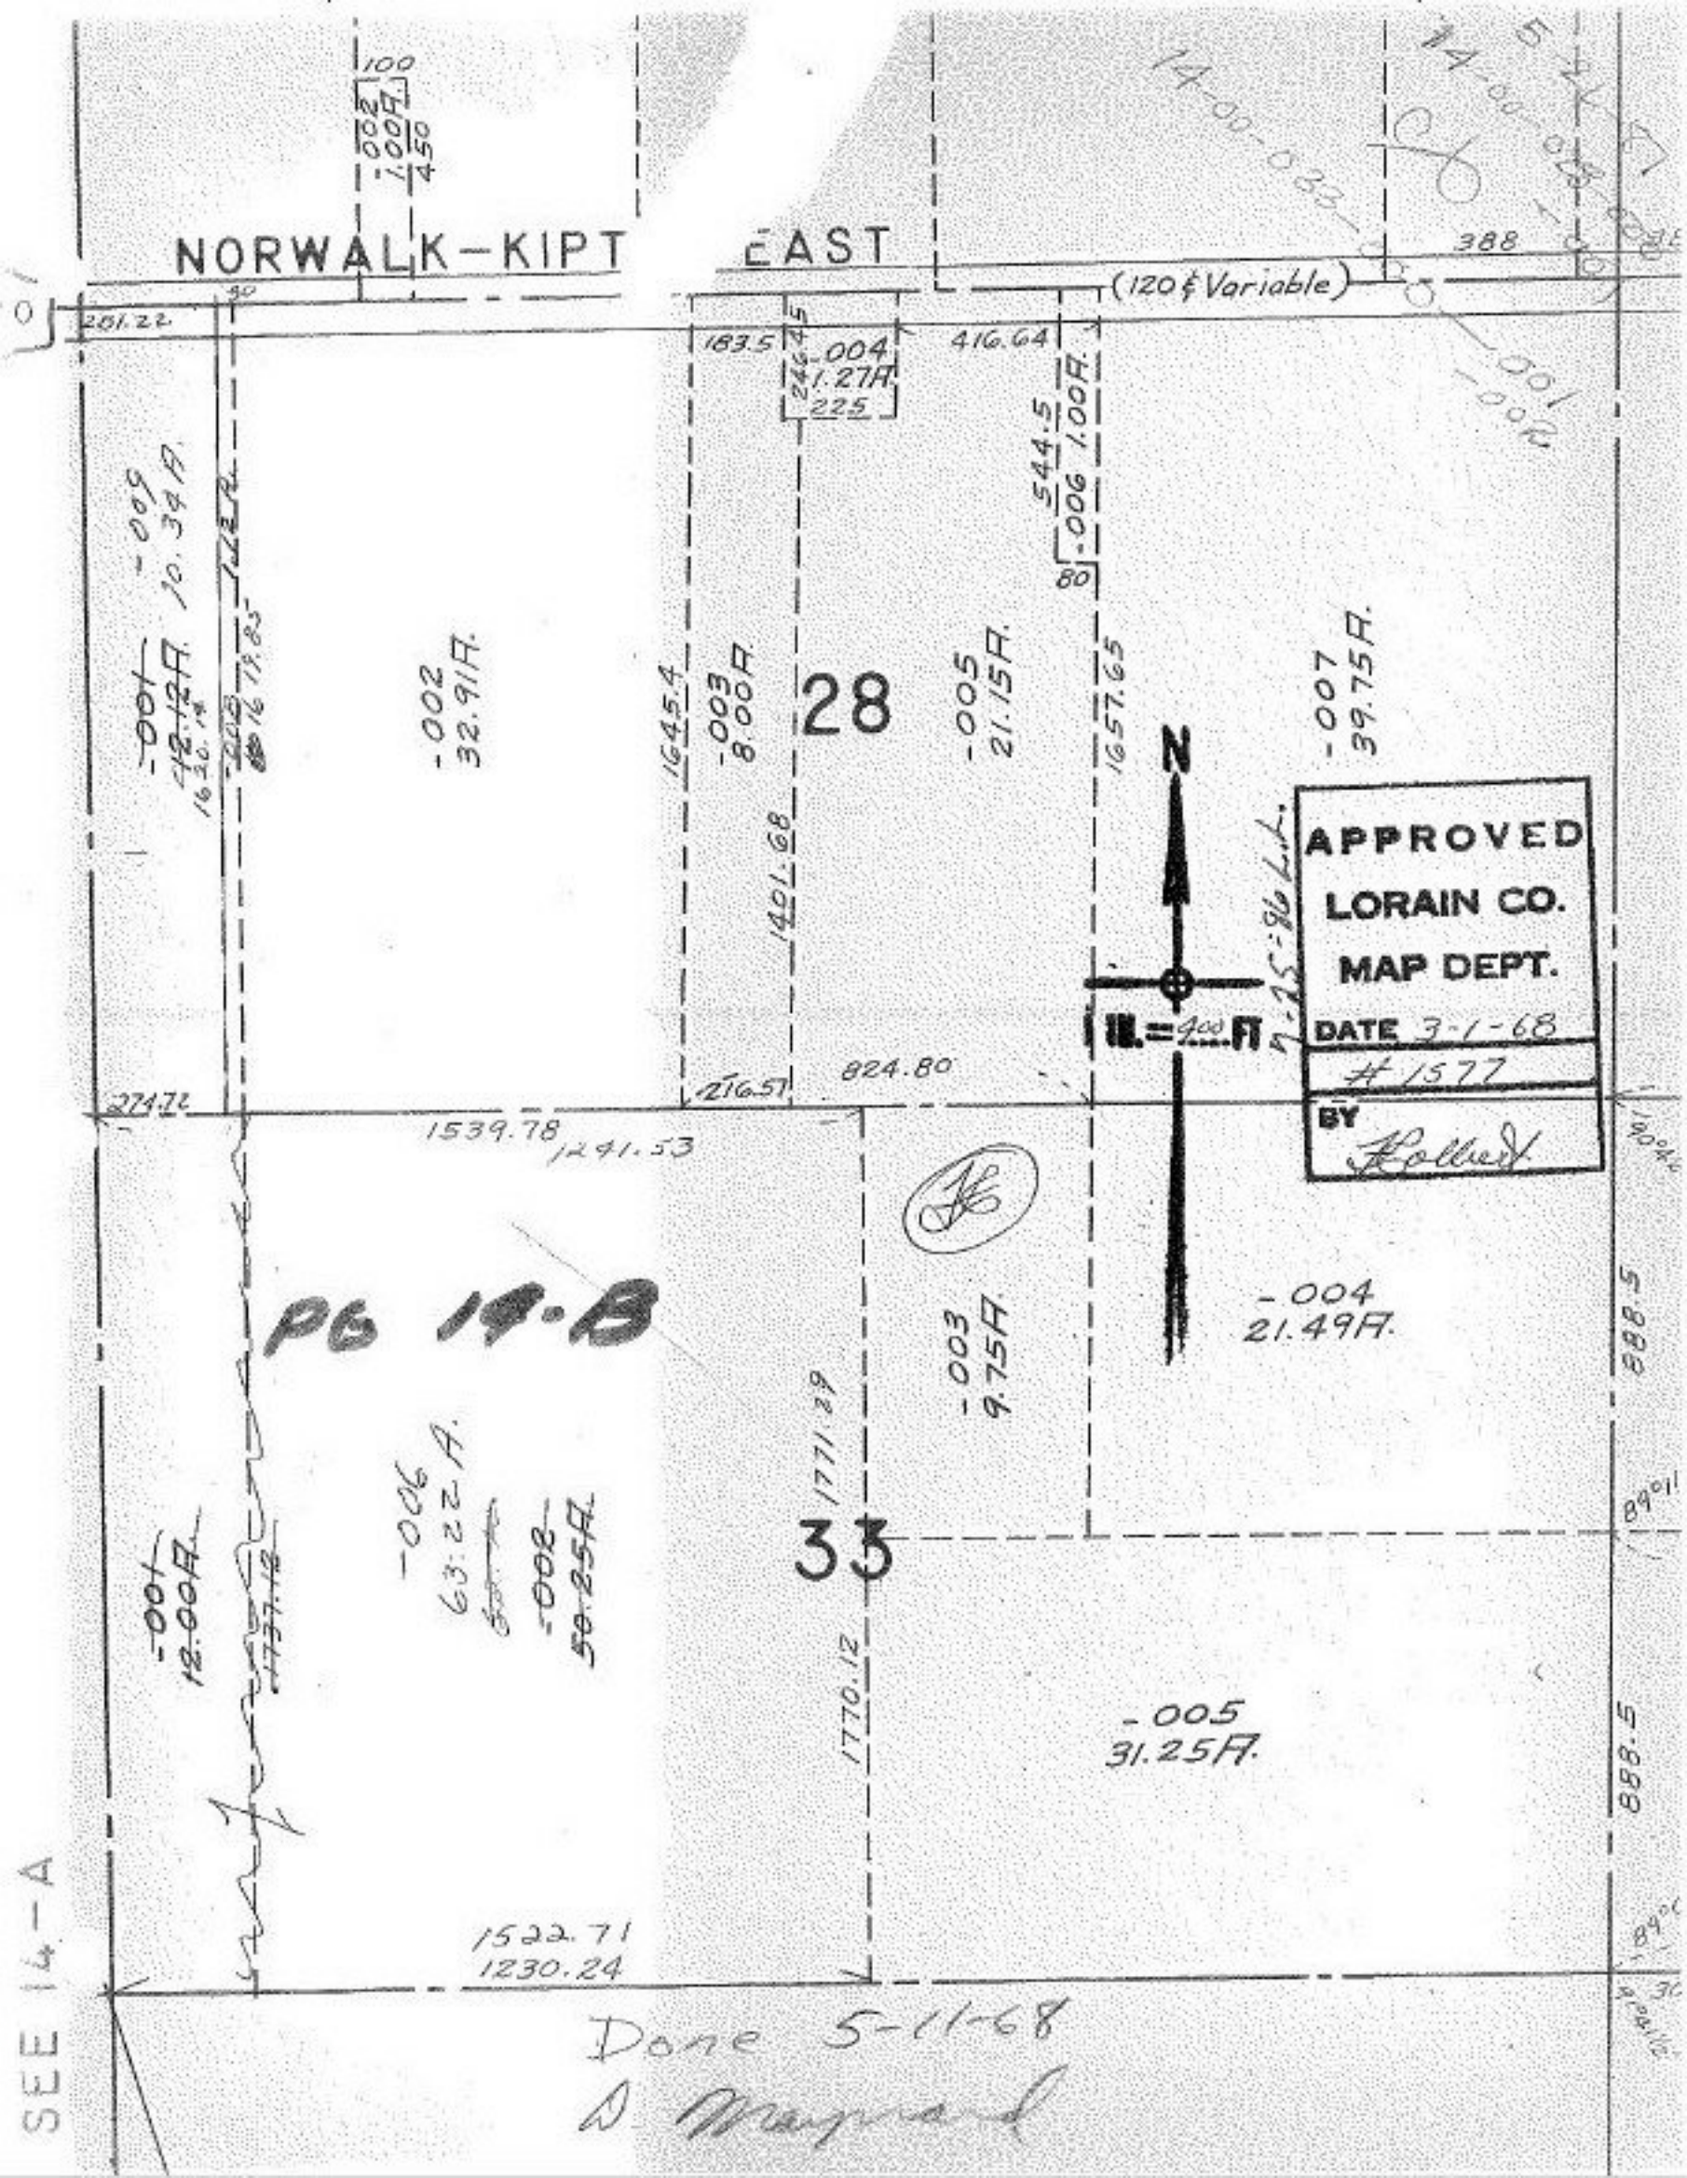
NORWALK-KIPT
EAST
(120' & Variable)
388
201.22
183.5
246.45
225
-004
1.27A.
416.64
544.5
-006
1.00A.
80
100
1.00A.
450
-001
1.00A.
-005
10.34A.
-002
32.91A.
-003
8.00A.
28
-005
21.15A.
-007
39.75A.
1645.4
1657.65
1401.68
1 IN.=400 FT.
N
APPROVED
LORAIN CO.
MAP DEPT.
DATE 3-1-68
#1577
BY
824.80
216.51
1539.78
1241.53
PG 19-B
-003
9.75A.
-004
21.49A.
33
1771.29
1770.12
-006
63.22A.
-008
59.25A.
-005
31.25A.
888.5
1522.71
1230.24
SEE 14-A
Done 5-11-68
D. Maynard