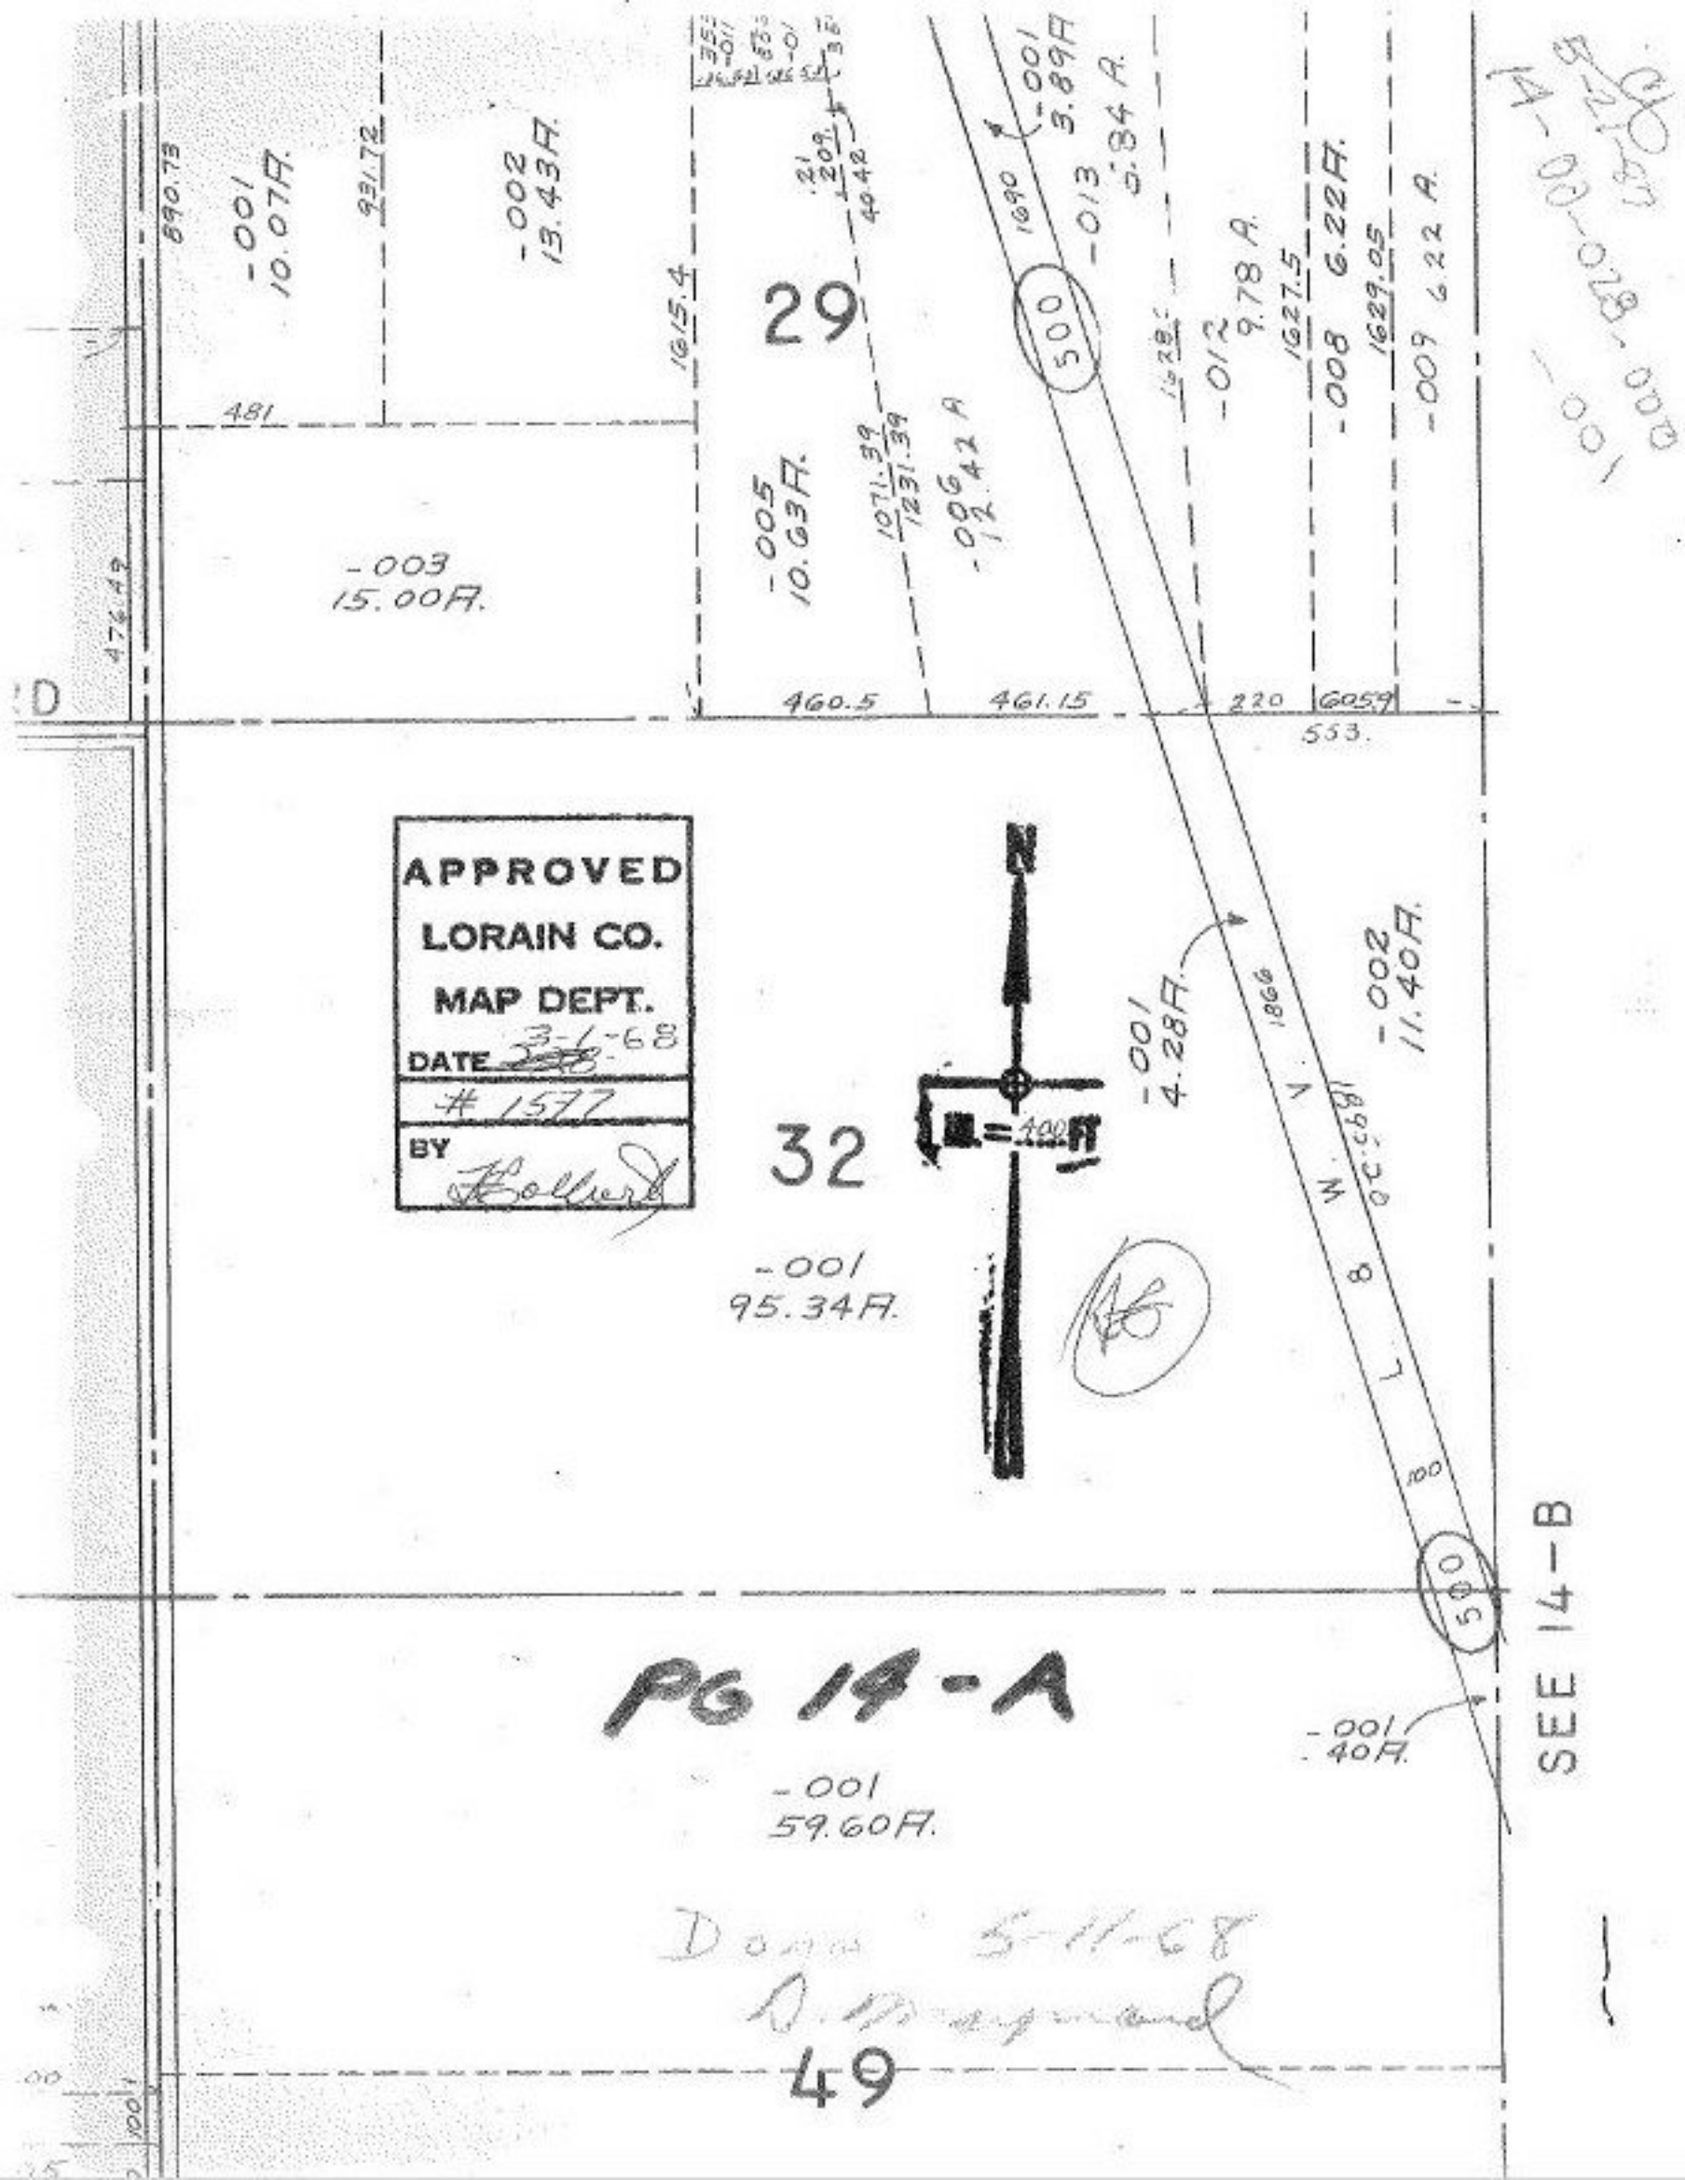
890.73
931.72
-001
10.07A.
-002
13.43A.
1615.4
29
481
-003
15.00A.
-005
10.63A.
-006
12.42A
-001
3.89A
-013
5.84 A.
-012
9.78 A.
-008 6.22A.
-009 6.22 A.
1090
500
1627.5
1629.05
460.5
461.15
220
553.
APPROVED
LORAIN CO.
MAP DEPT.
DATE 3-6-68
1577
BY
32
-001
95.34A.
-001
4.28A.
-002
11.40A.
1866
N 8° W
1693.0
100
500
-001
.40A.
PG 14-A
-001
59.60A.
SEE 14-B
Done 5-11-68
D. Diamond
49