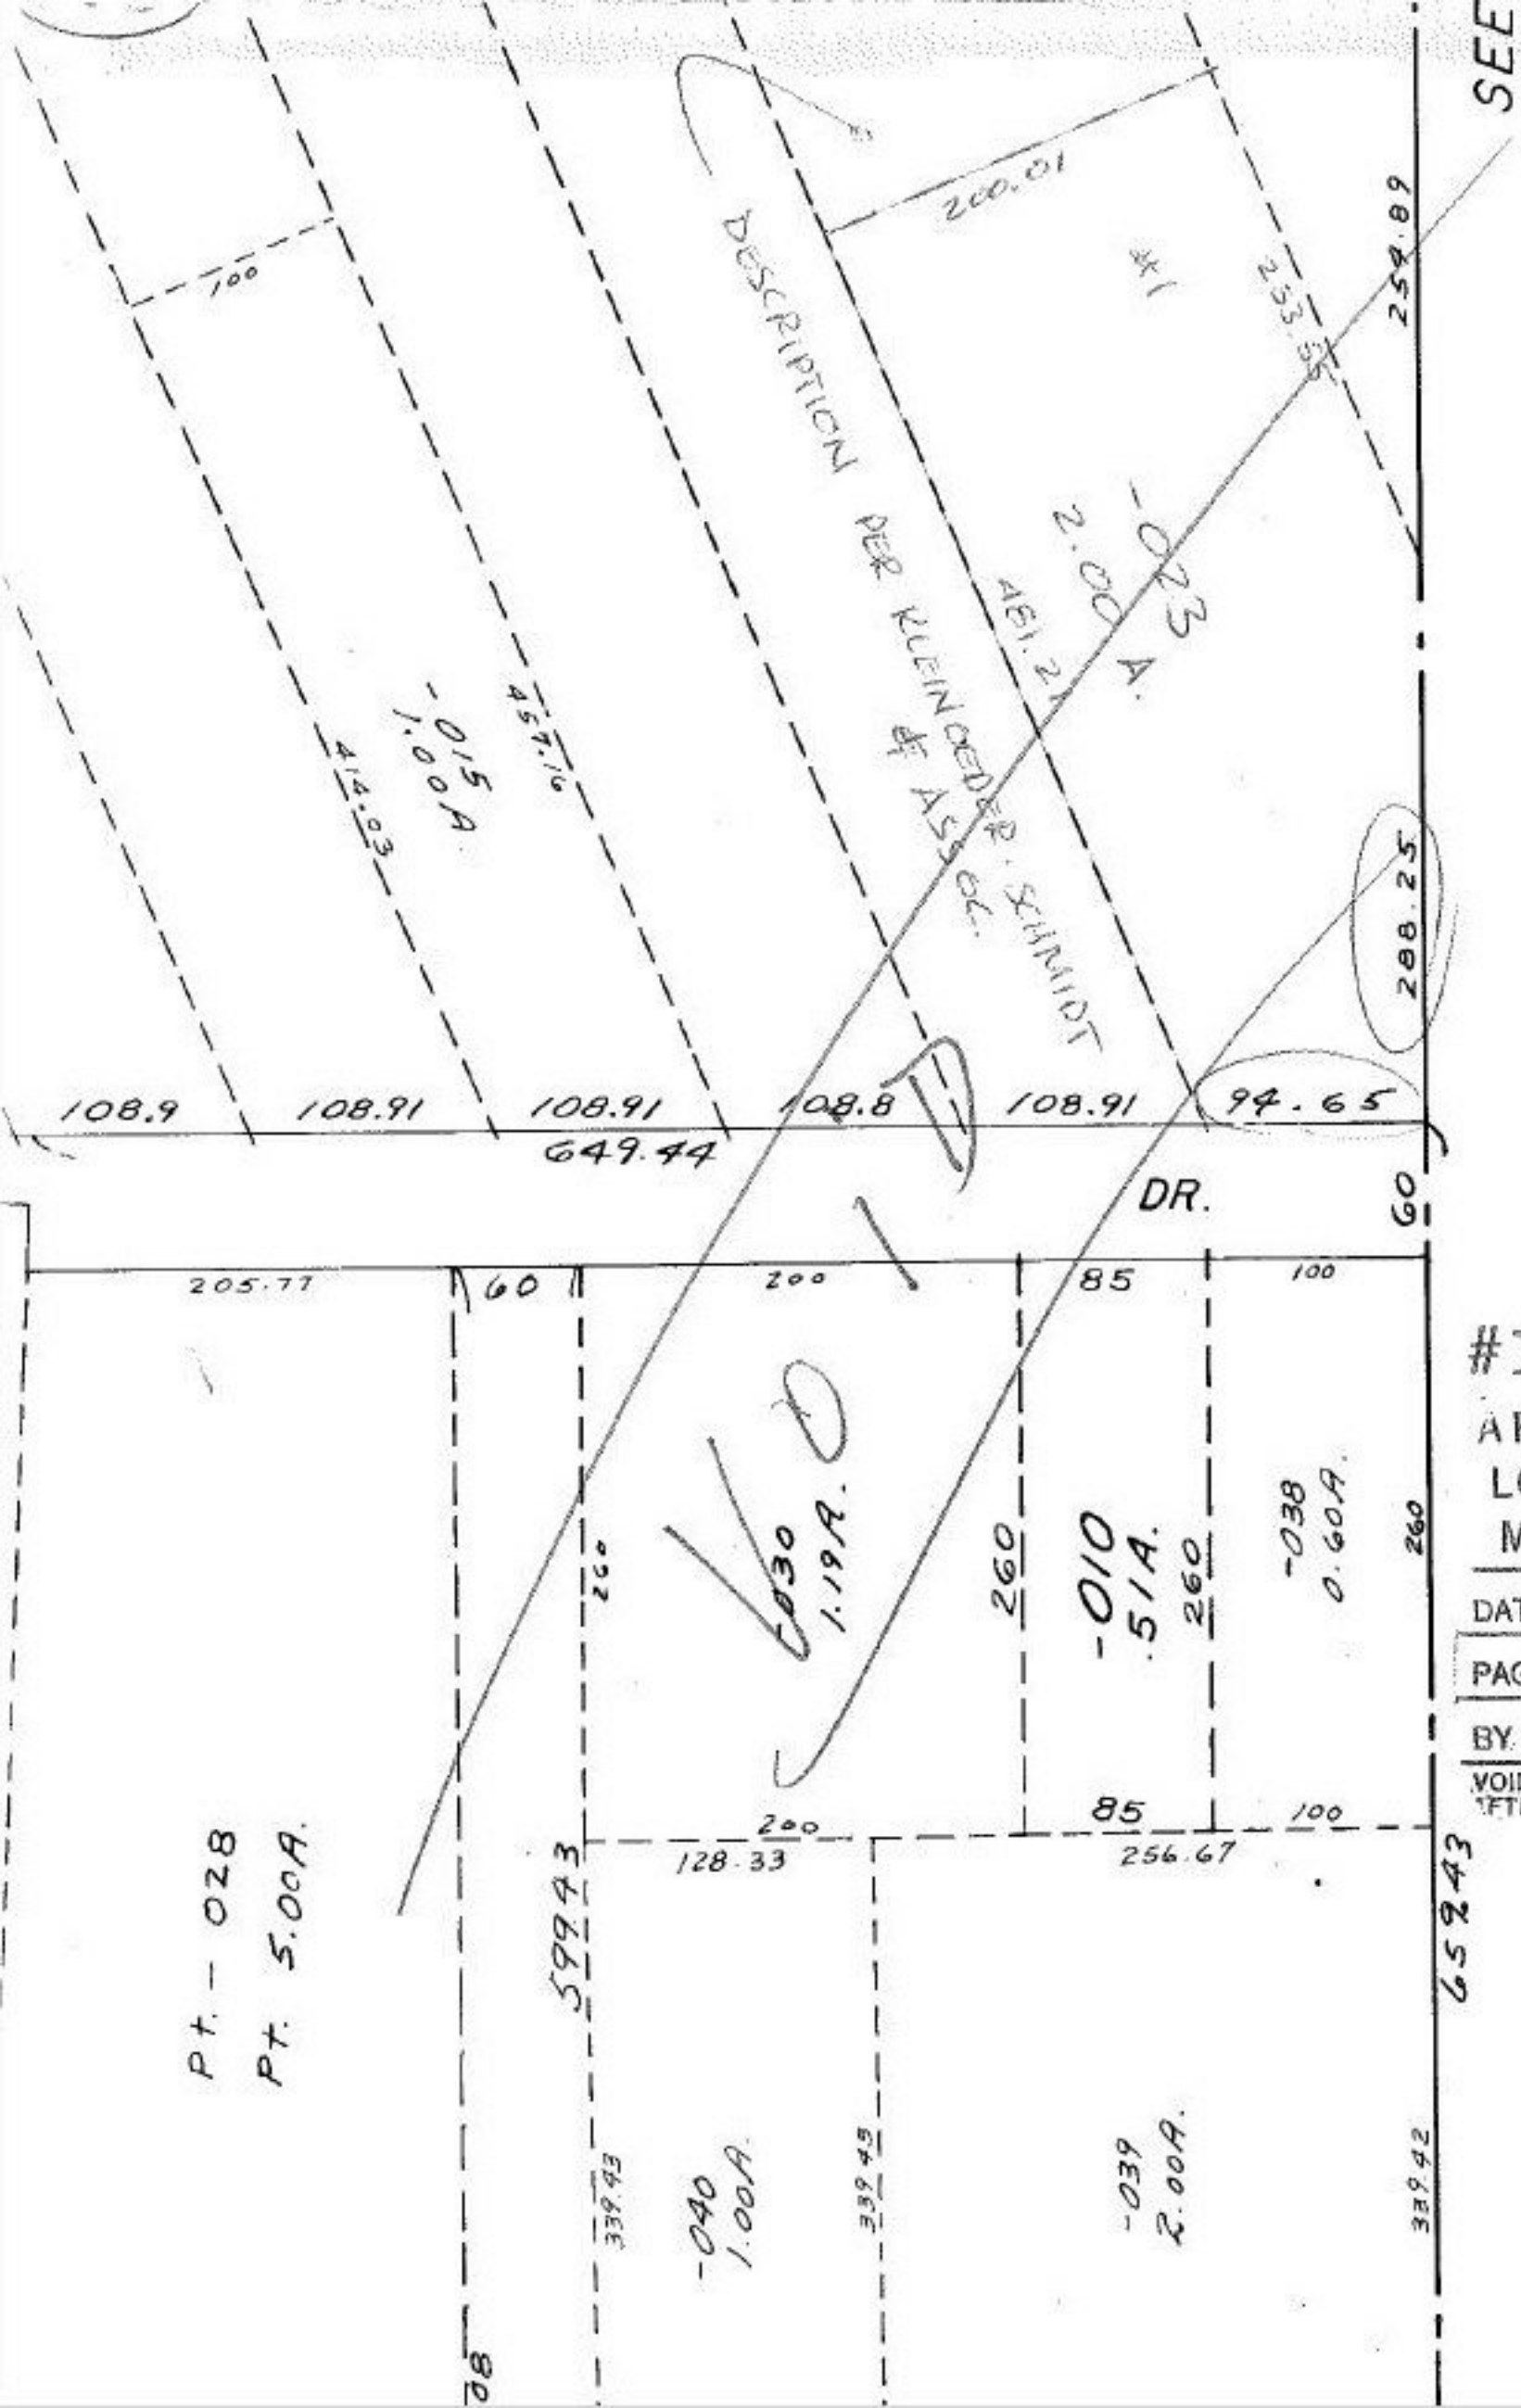

#15773
APPROVED
LORAIN CO.
MAP DEPT.
DATE 8-23-84
PAGE 7-00-035-B
BY T. McNair
VOID