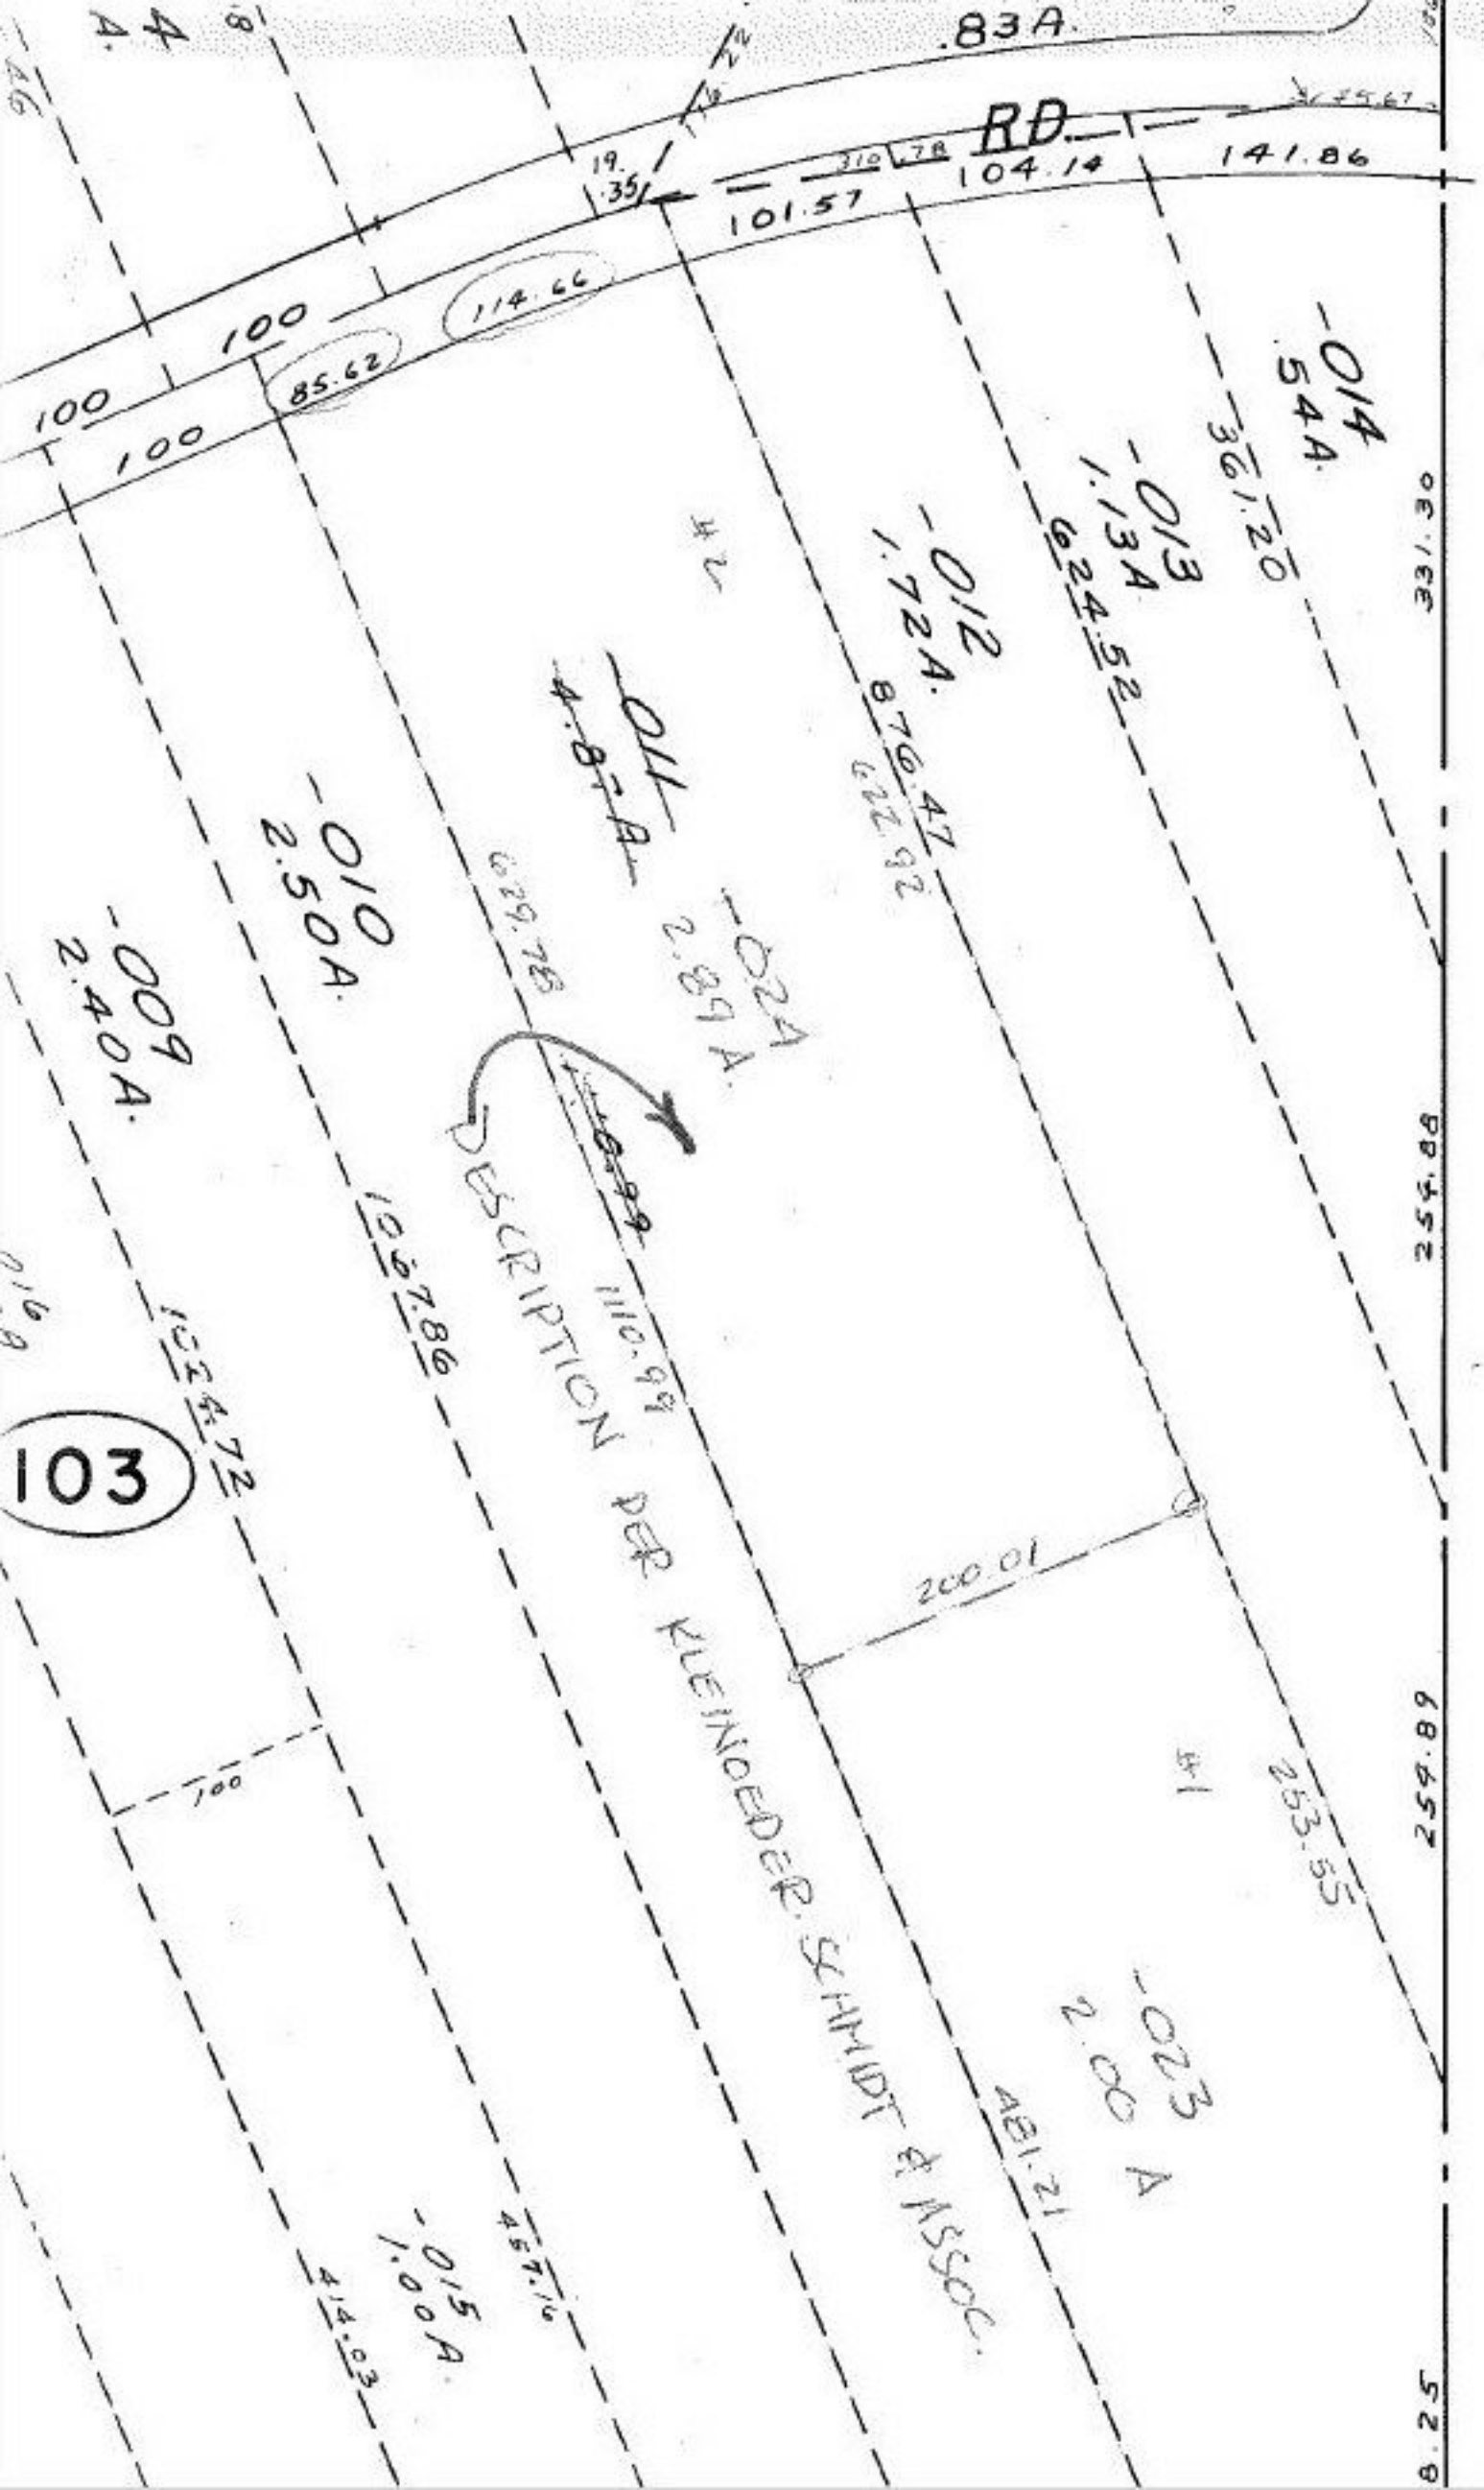

#15773

APPROVED
LORAIN CO.
MAP DEPT.

DATE 8.23.84

PAGE 700-035-B

BY T. McNair

VOID

~~T.N.~~ 10-18-85