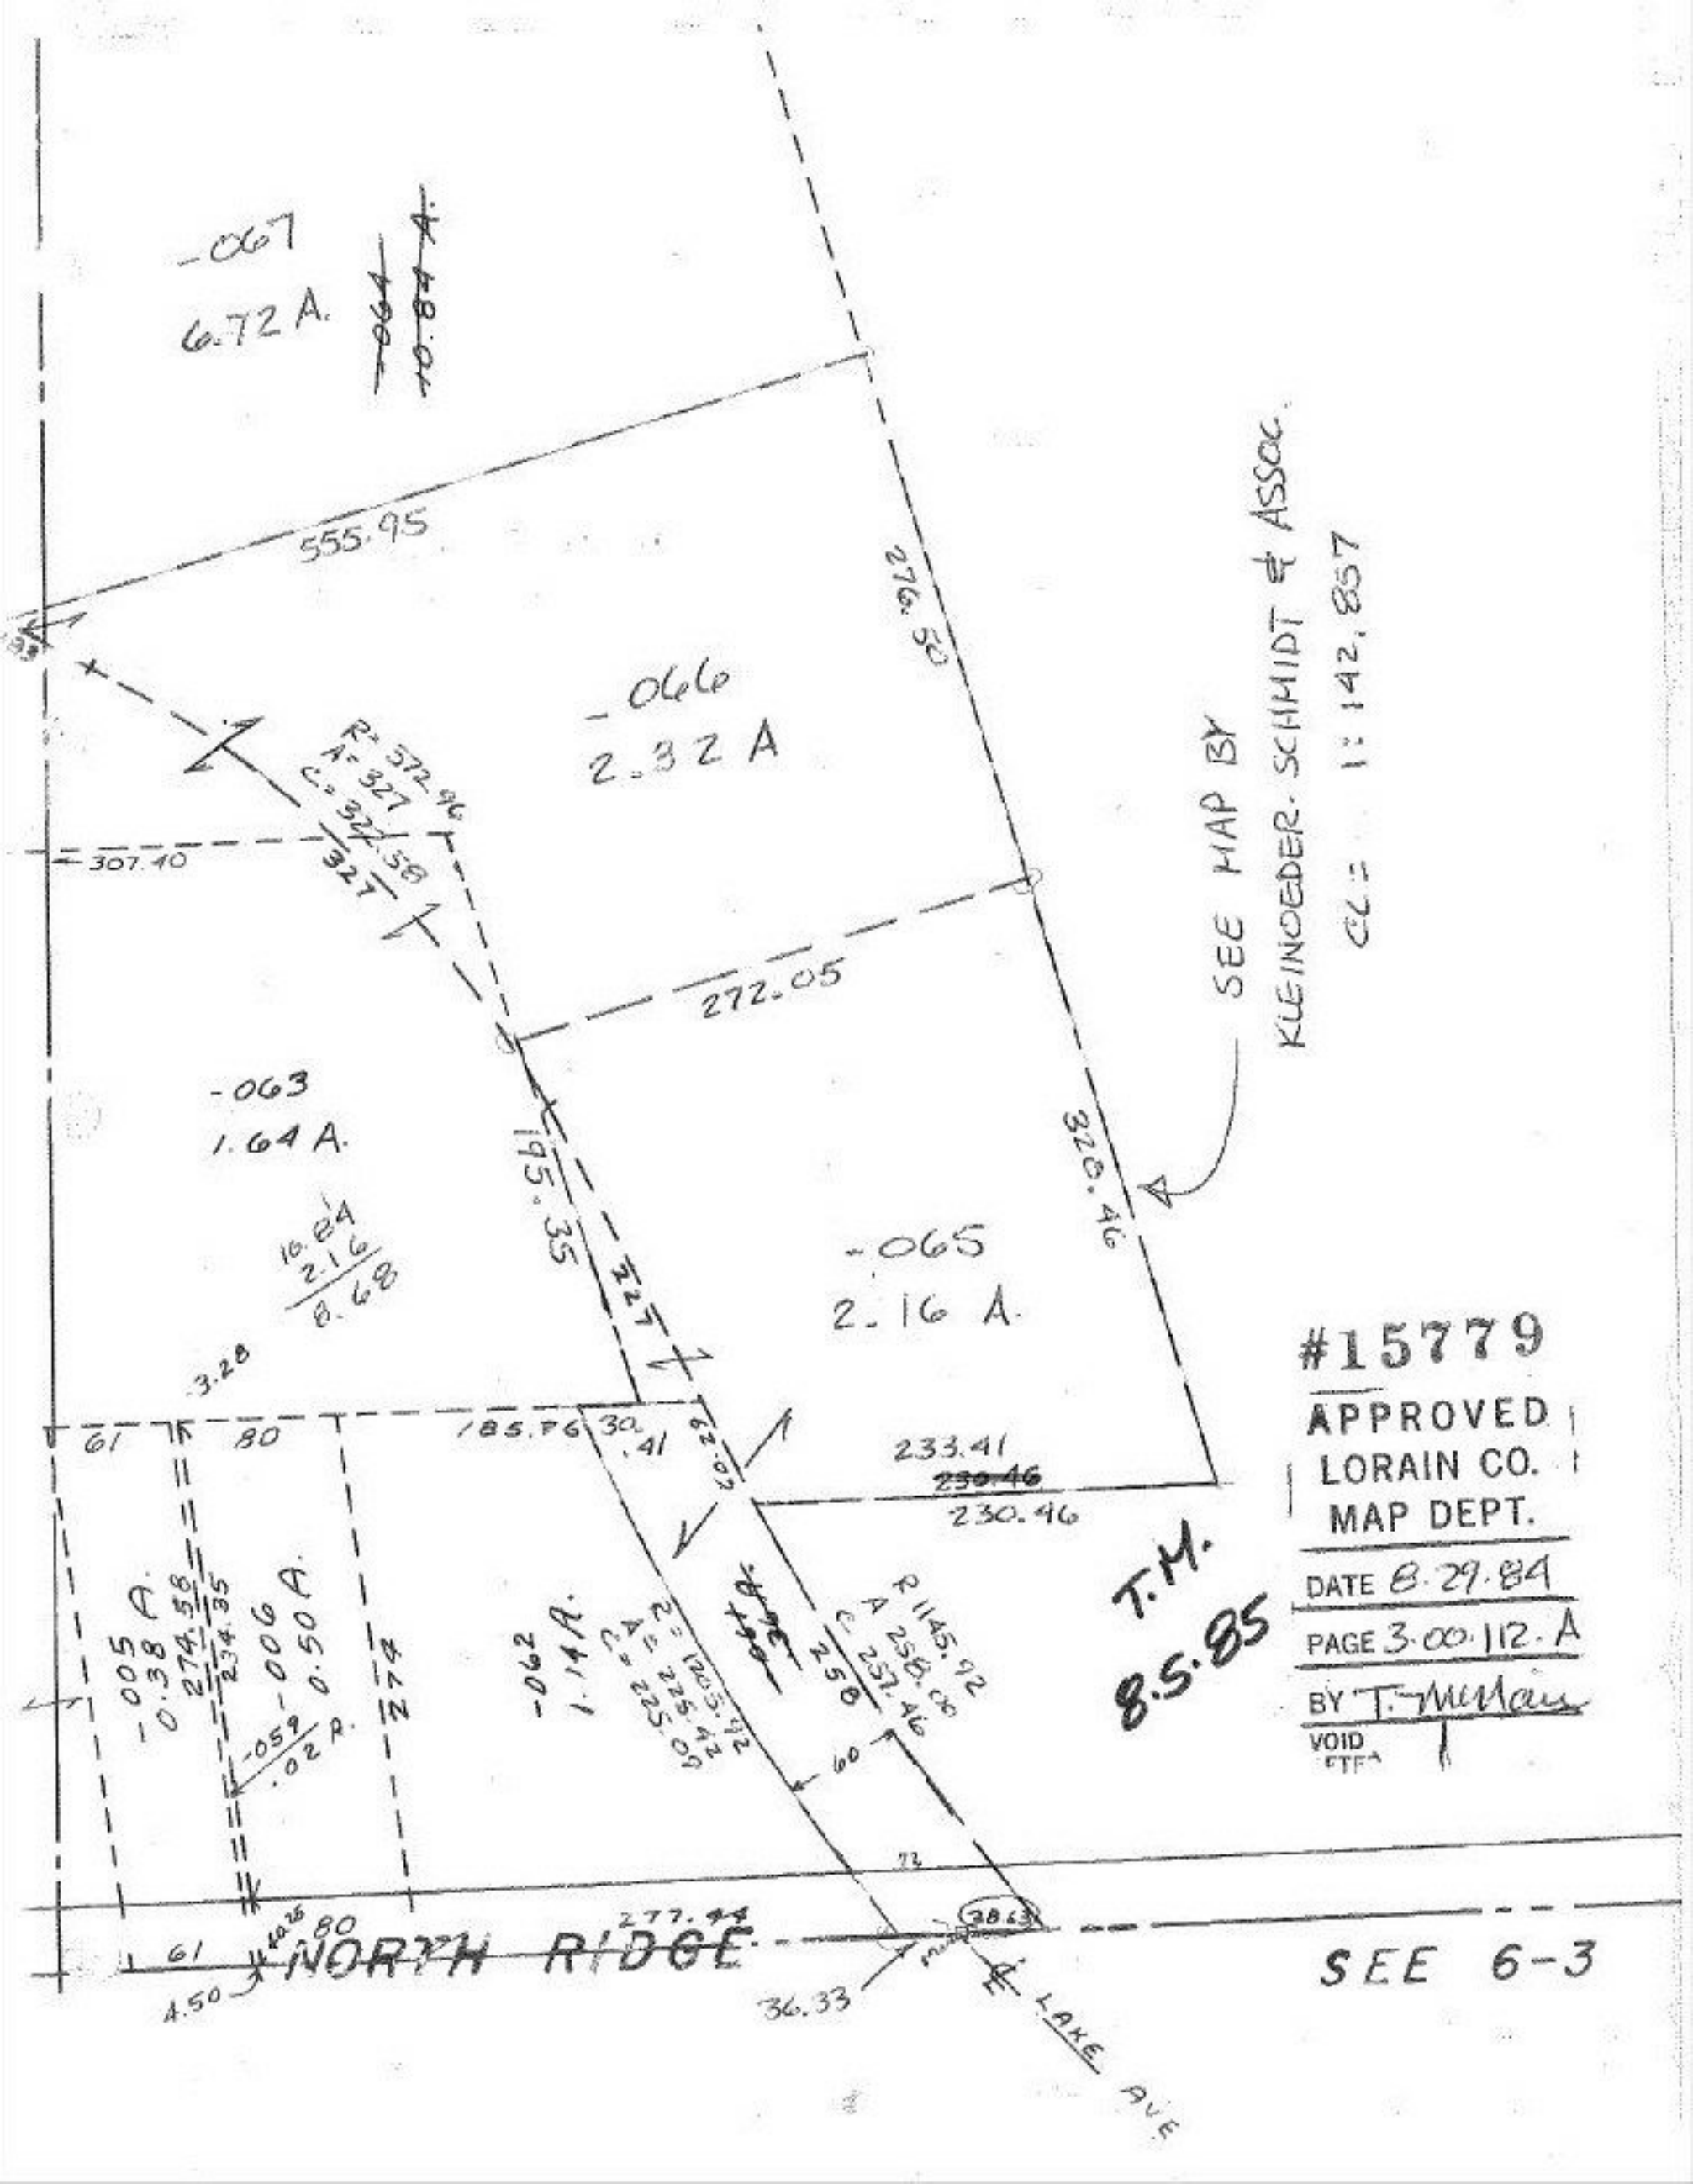

-067
6.72 A.
~~-064~~
~~10.84 A.~~
555.95
276.50
-066
2.32 A
R= 572.96
A= 327
C= 322.58
327
307.40
272.05
-063
1.64 A.
195.35
227
328.46
-065
2.16 A.
10.84
2.16
8.68
3.28
61
80
185.76
30.41
60.29
233.41
~~230.46~~
230.46
-005
0.38 A.
274.58
234.35
-006
0.50 A.
274
-059
.02 A.
-062
1.14 A.
R= 1205.92
A= 225.42
C= 225.09
R 1145.92
A 258.00
C 257.46
258
60
72
277.44
38.63
61
80
4.50
NORTH RIDGE
36.33
LAKE AVE
SEE MAP BY
KLEINOEDER. SCHMIDT & ASSOC.
CL = 1:142,857
T.M.
8.5.85
#15779
APPROVED
LORAIN CO.
MAP DEPT.
DATE 8.29.84
PAGE 3.00.112.A
BY T. McNair
VOID
SEE 6-3