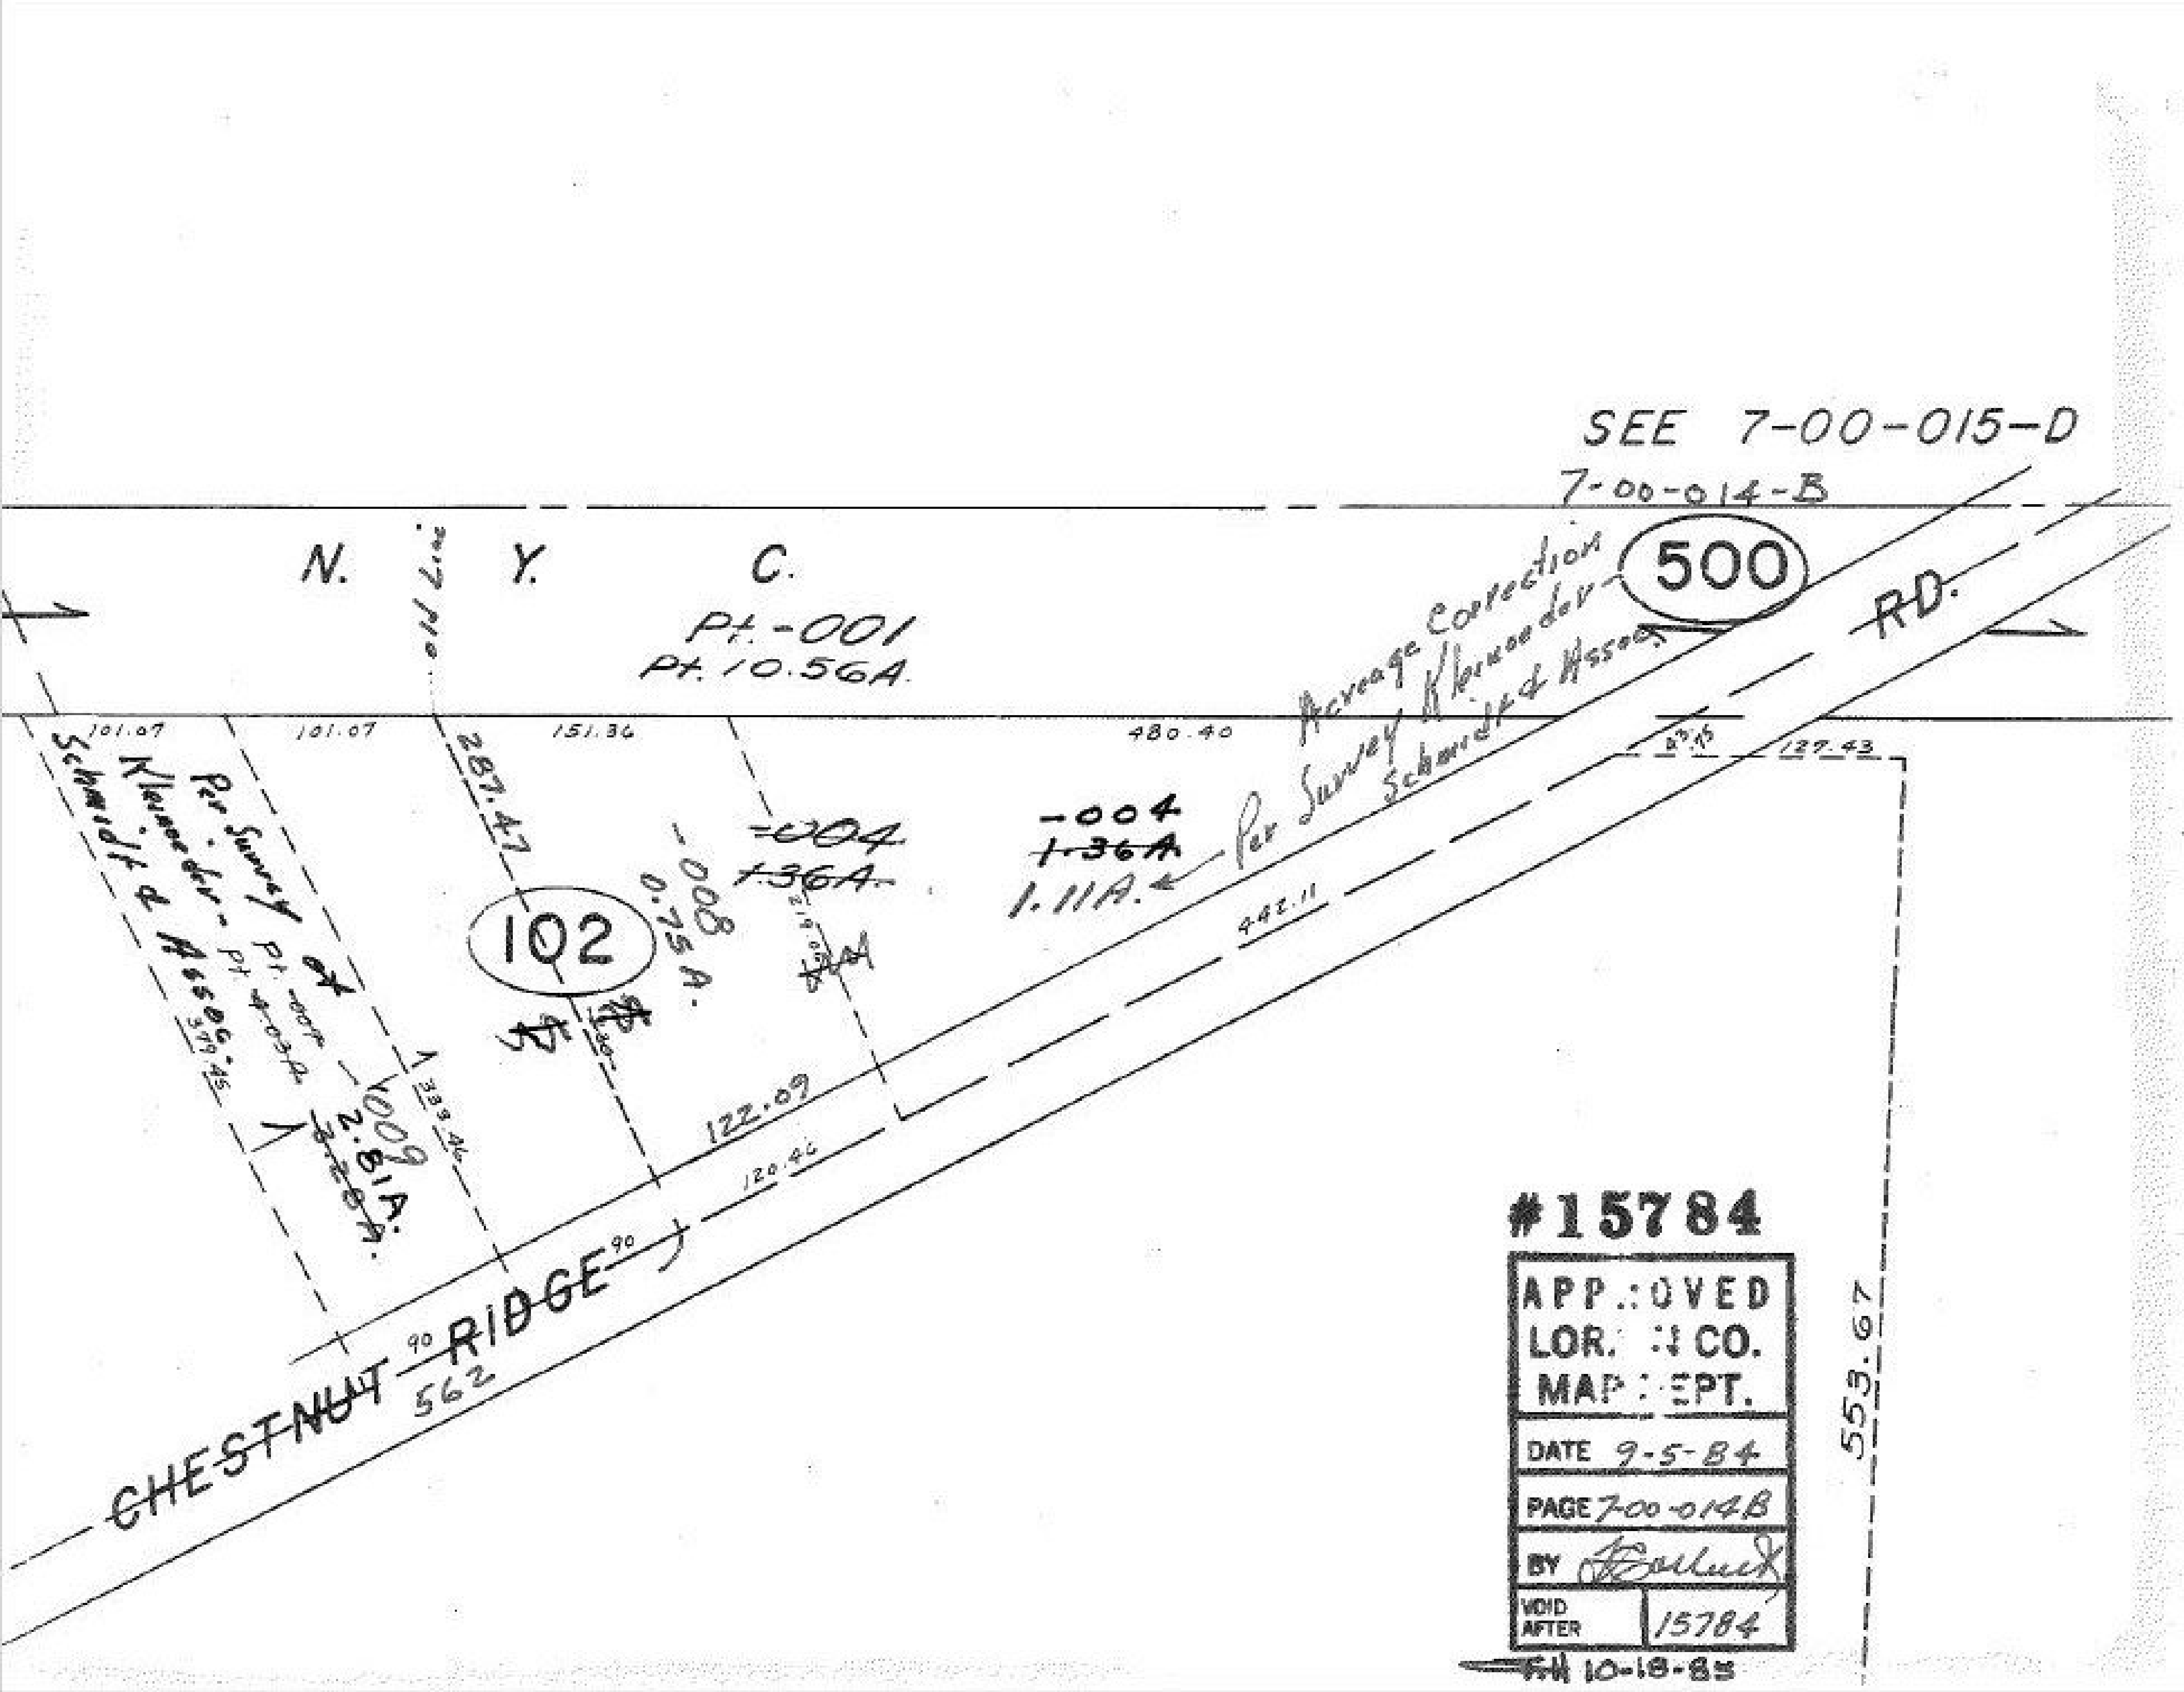

SEE 7-00-015-D
7-00-014-B
500
N. Y. C.
Pt.-001
Pt. 10.56A
RD.
Acreage Correction
Per Survey Kleinoeder-
Schmidt & Assoc.
-004
1.36A
1.11A.
-004
1.36A
-008
0.75A.
102
Per Survey of
Kleinoeder - Pt. -007
Schmidt & Assoc. - Pt. 4.03A
-009
2.81A.
3.20A.
101.07
101.07
151.36
480.40
287.47
127.43
442.11
122.09
120.46
339.46
379.45
553.67
CHESTNUT RIDGE
562
#15784
APPROVED
LORAIN CO.
MAP DEPT.
DATE 9-5-84
PAGE 7-00-014B
BY
VOID AFTER 15784
10-18-85