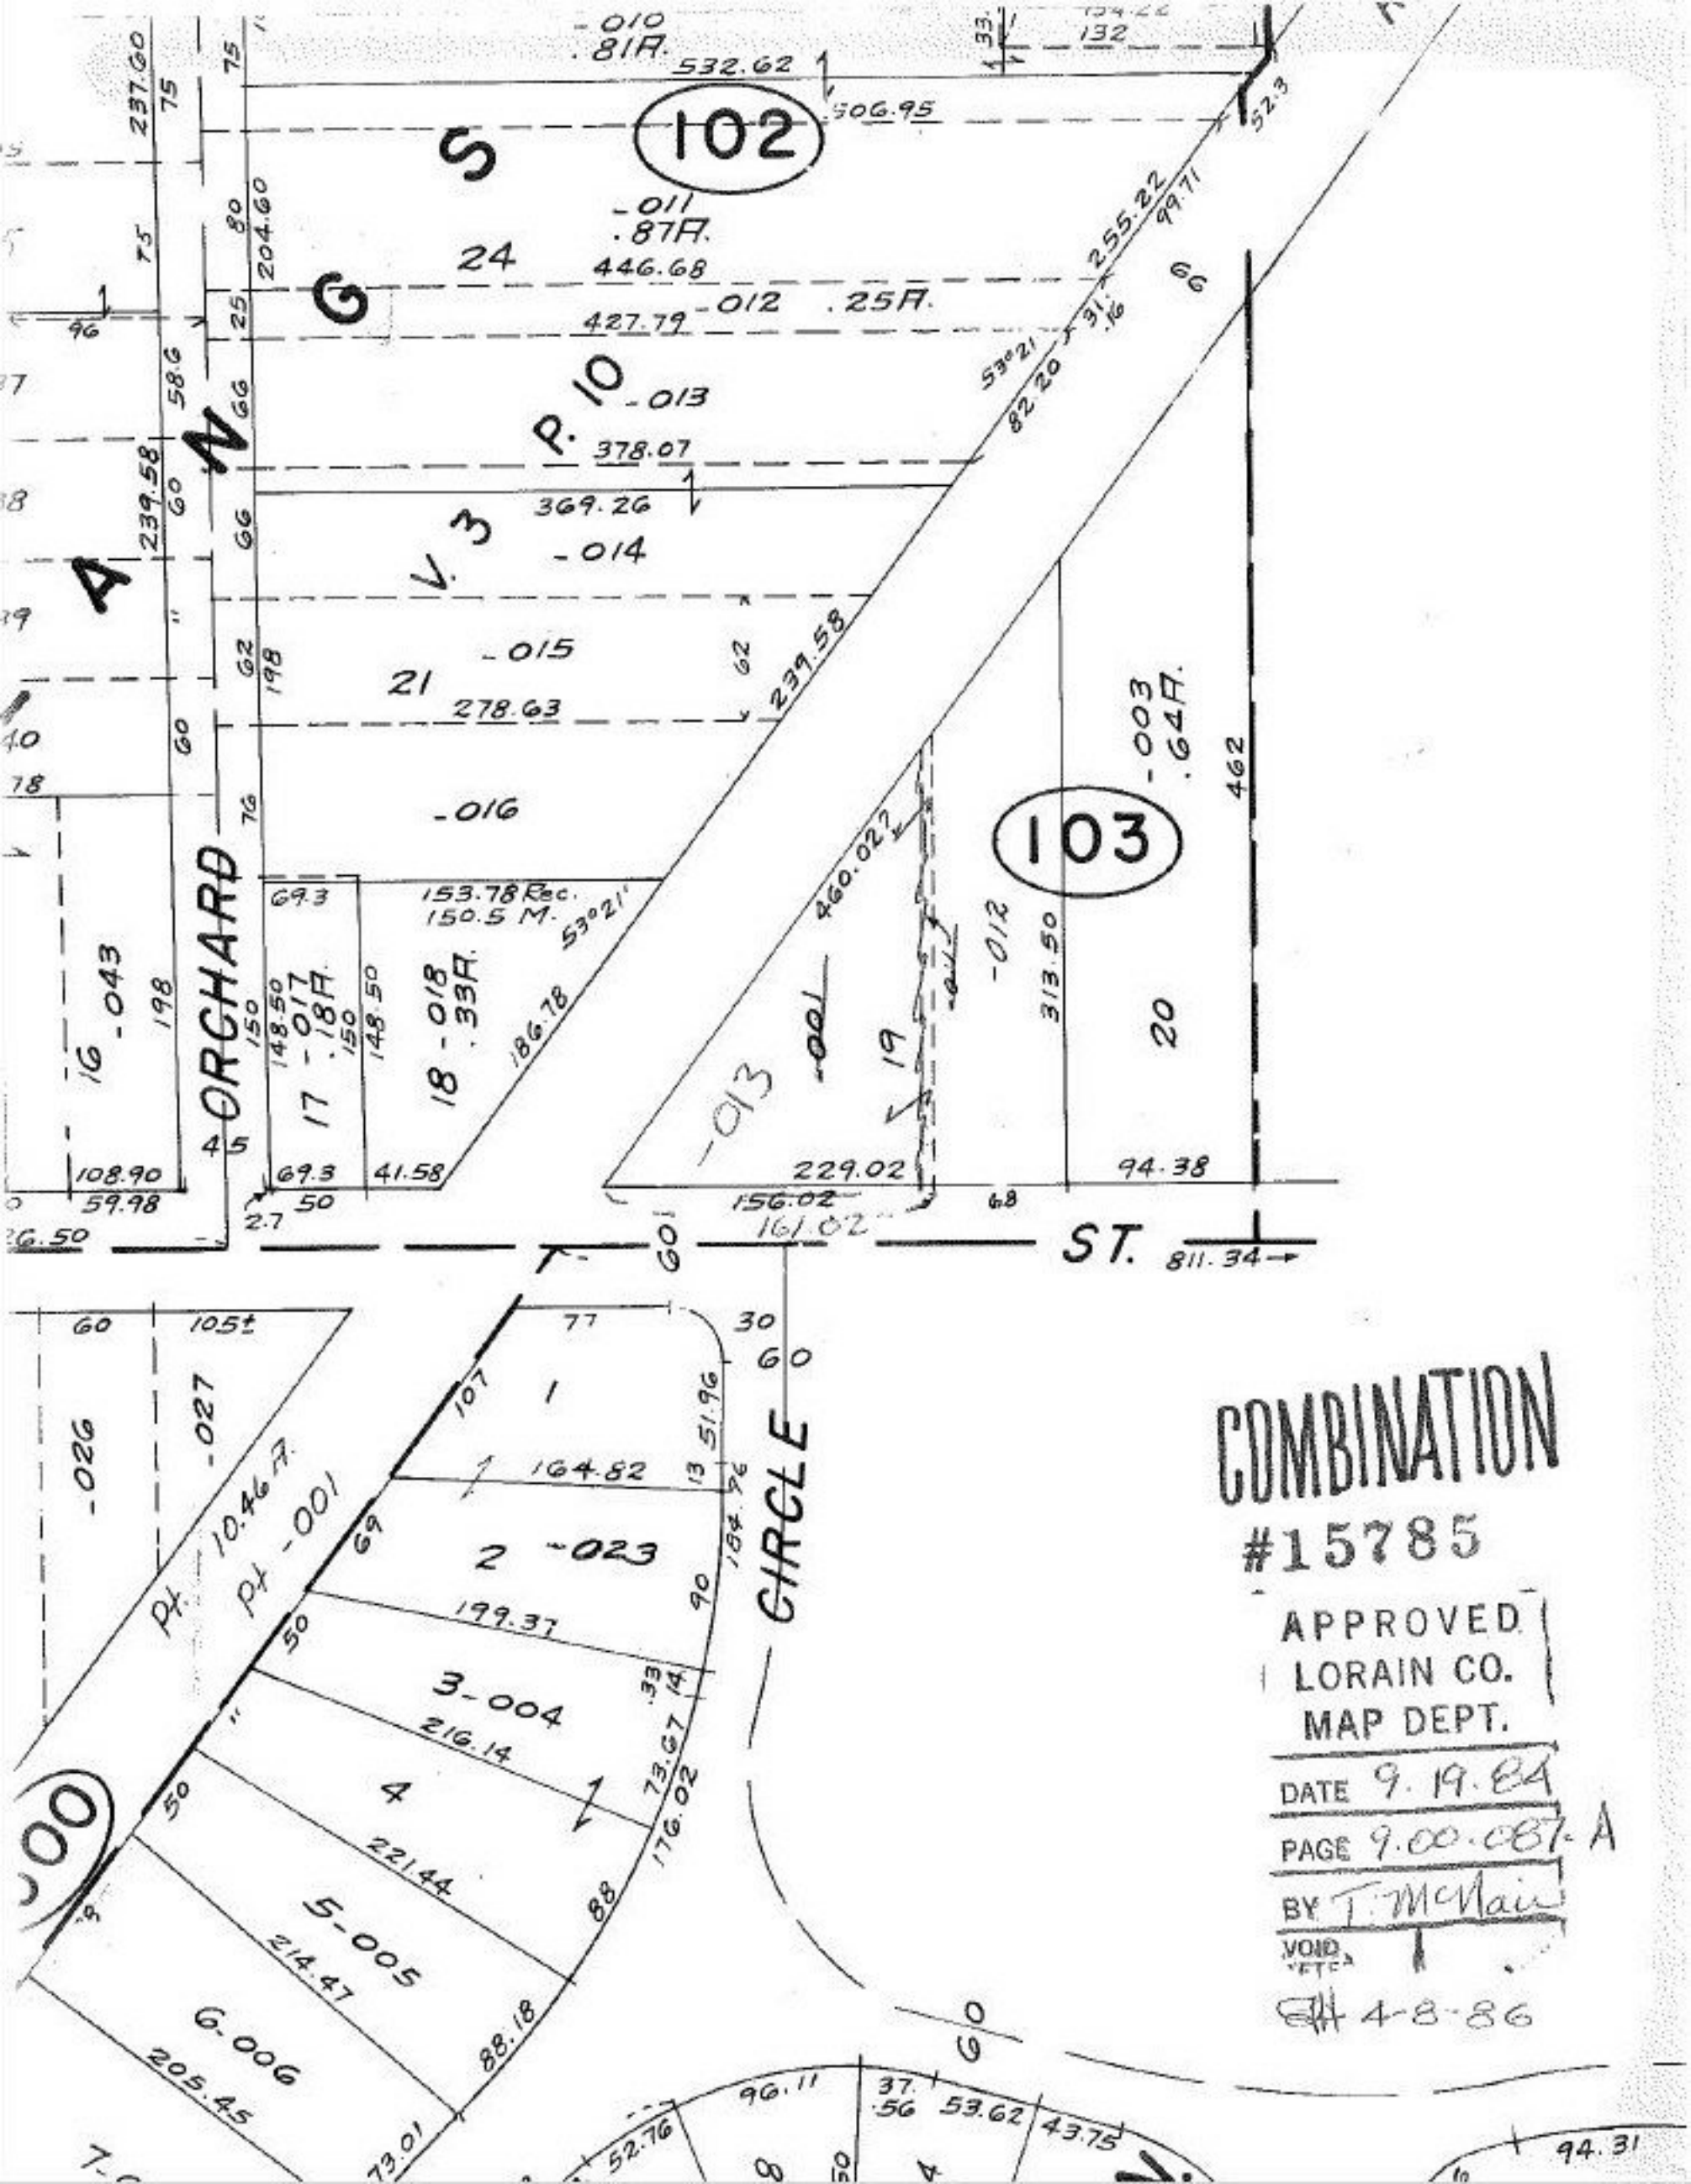

COMBINATION
#15785
APPROVED
LORAIN CO.
MAP DEPT.
DATE 9.19.84
PAGE 9.00.087-A
BY T. McNair
VOID
4-8-86