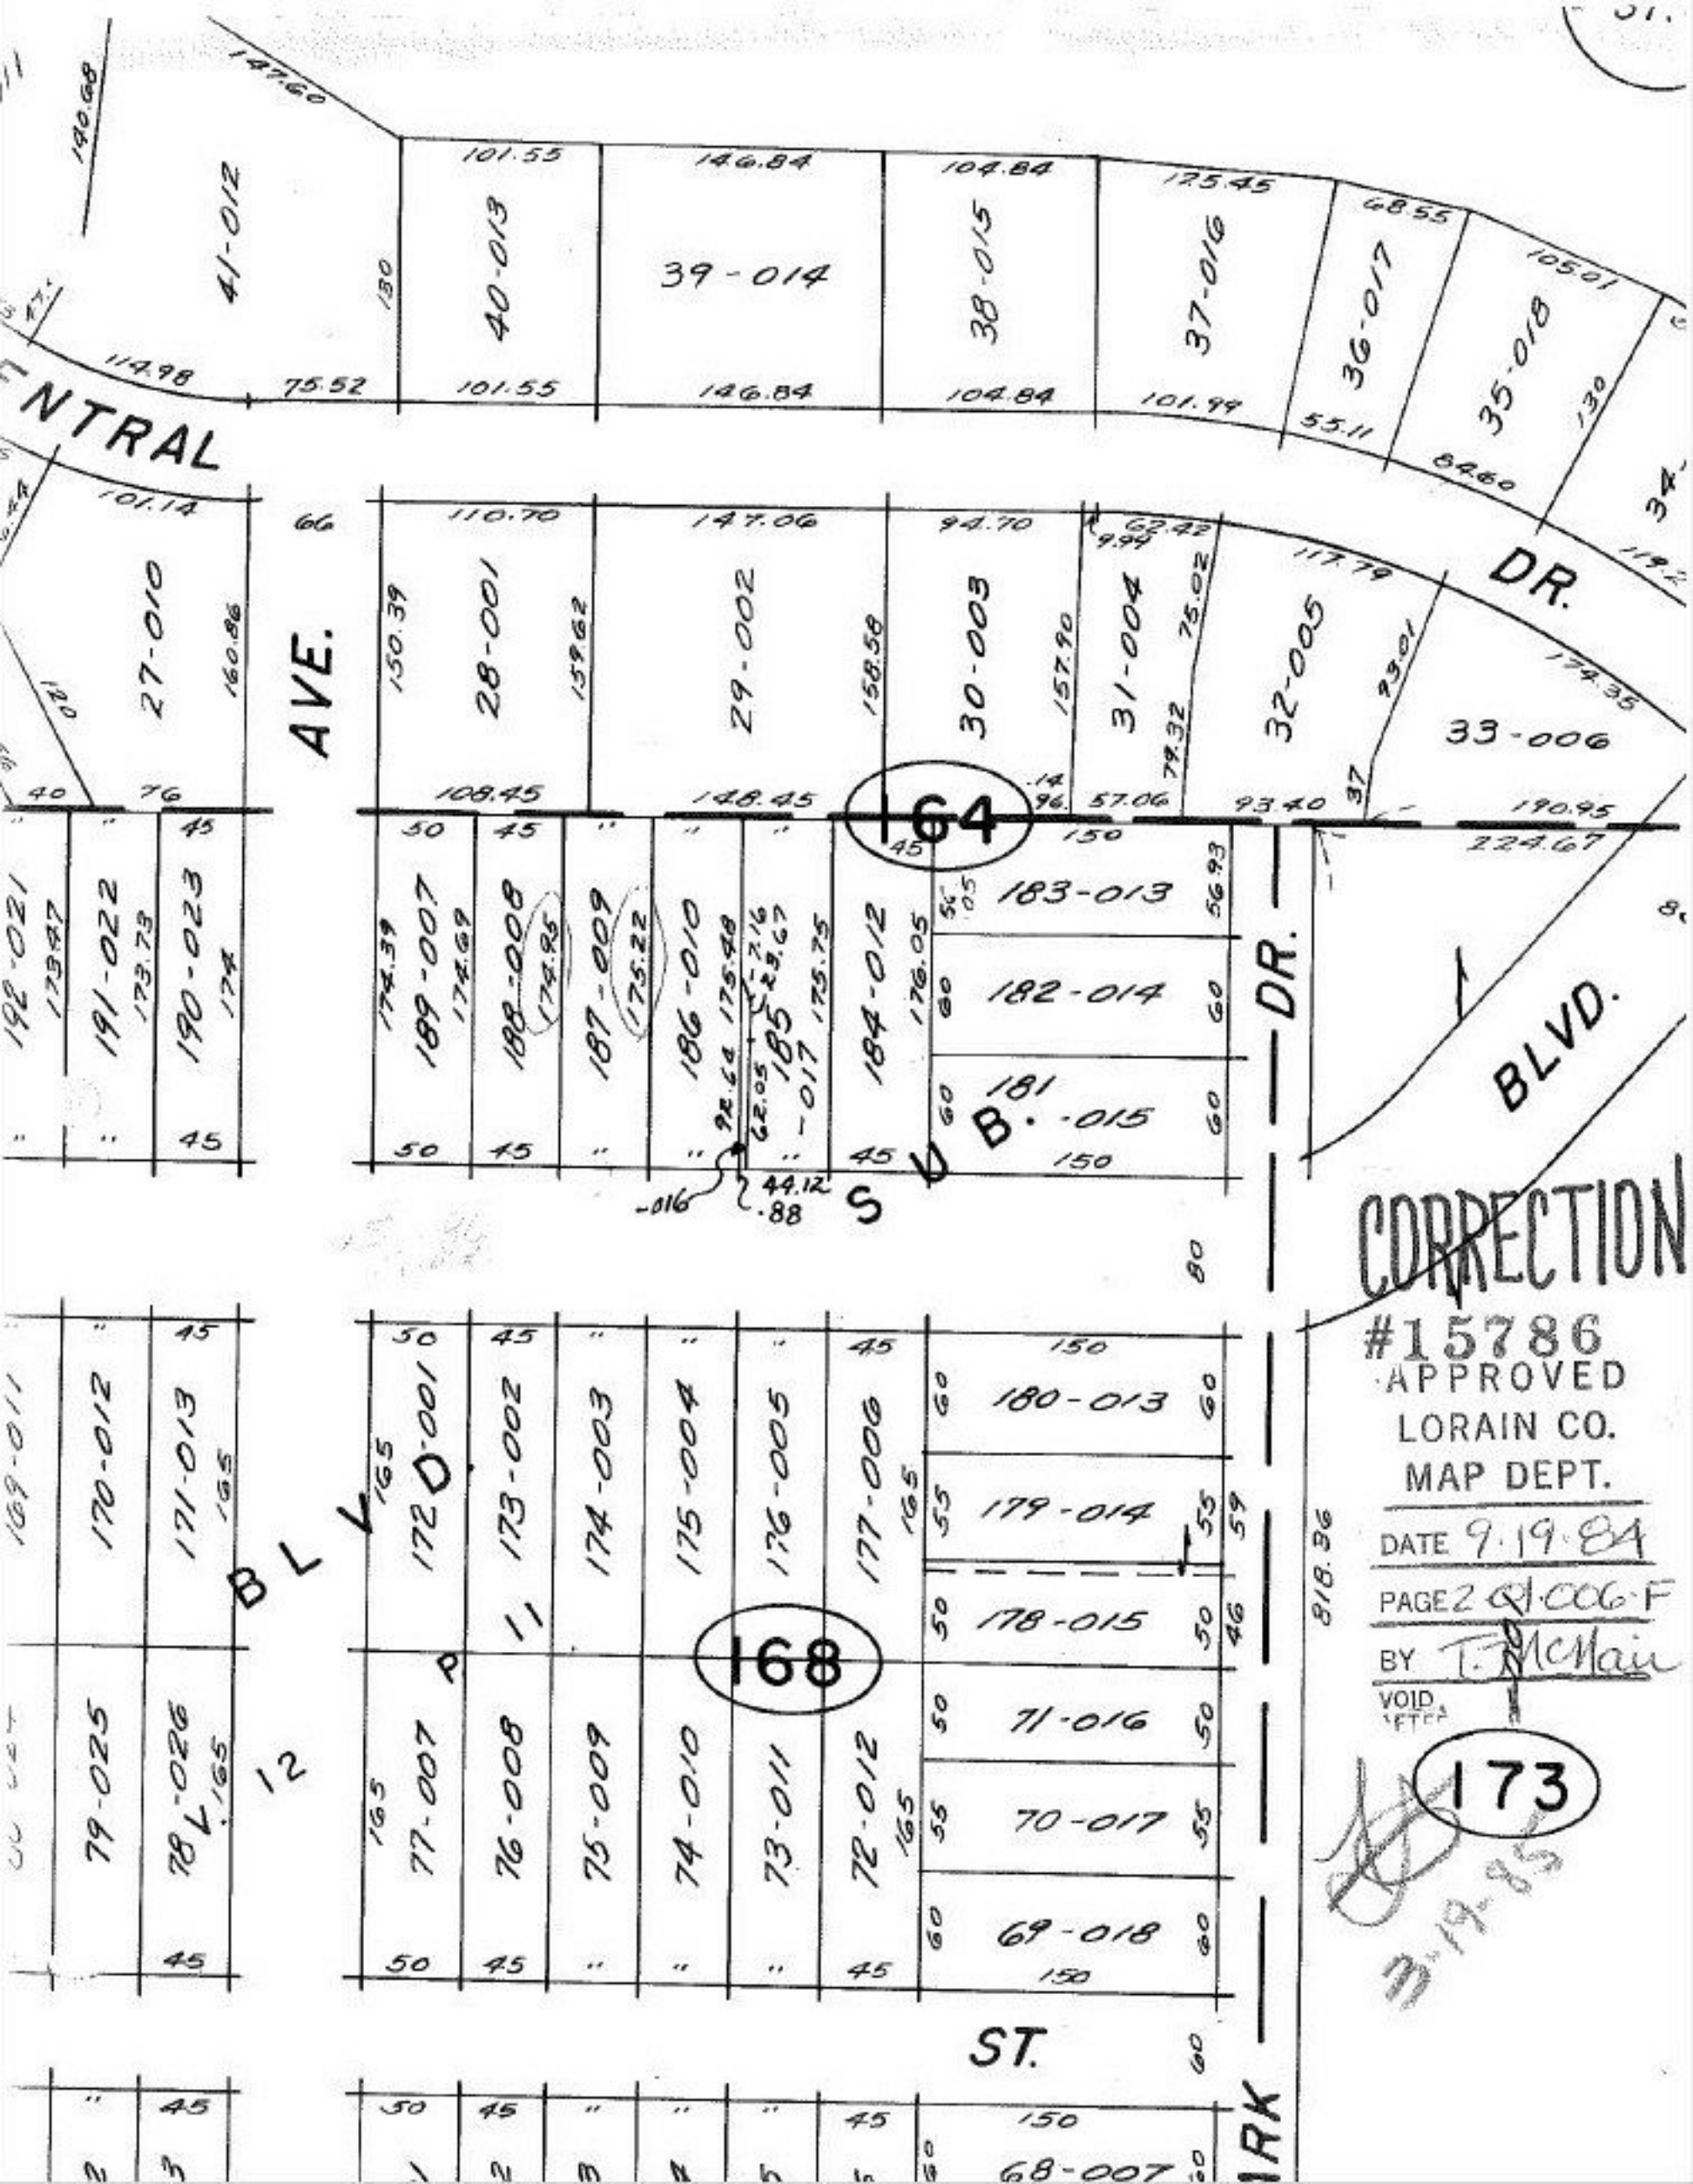

CENTRAL
AVE.
DR.
BLVD.
ST.
SUB. DR.
BLVD.
ARK
164
168
173
41-012
40-013
39-014
38-015
37-016
36-017
35-018
27-010
28-001
29-002
30-003
31-004
32-005
33-006
183-013
182-014
181-015
180-013
179-014
178-015
71-016
70-017
69-018
68-007
192-021
191-022
190-023
189-007
188-008
187-009
186-010
184-012
170-012
171-013
172-001
173-002
174-003
175-004
176-005
177-006
79-025
78-026
77-007
76-008
75-009
74-010
73-011
72-012
CORRECTION
#15786
APPROVED
LORAIN CO.
MAP DEPT.
DATE 9.19.84
PAGE 2 Q1.006-F
BY T. McMain
VOID AFTER
3-19-85