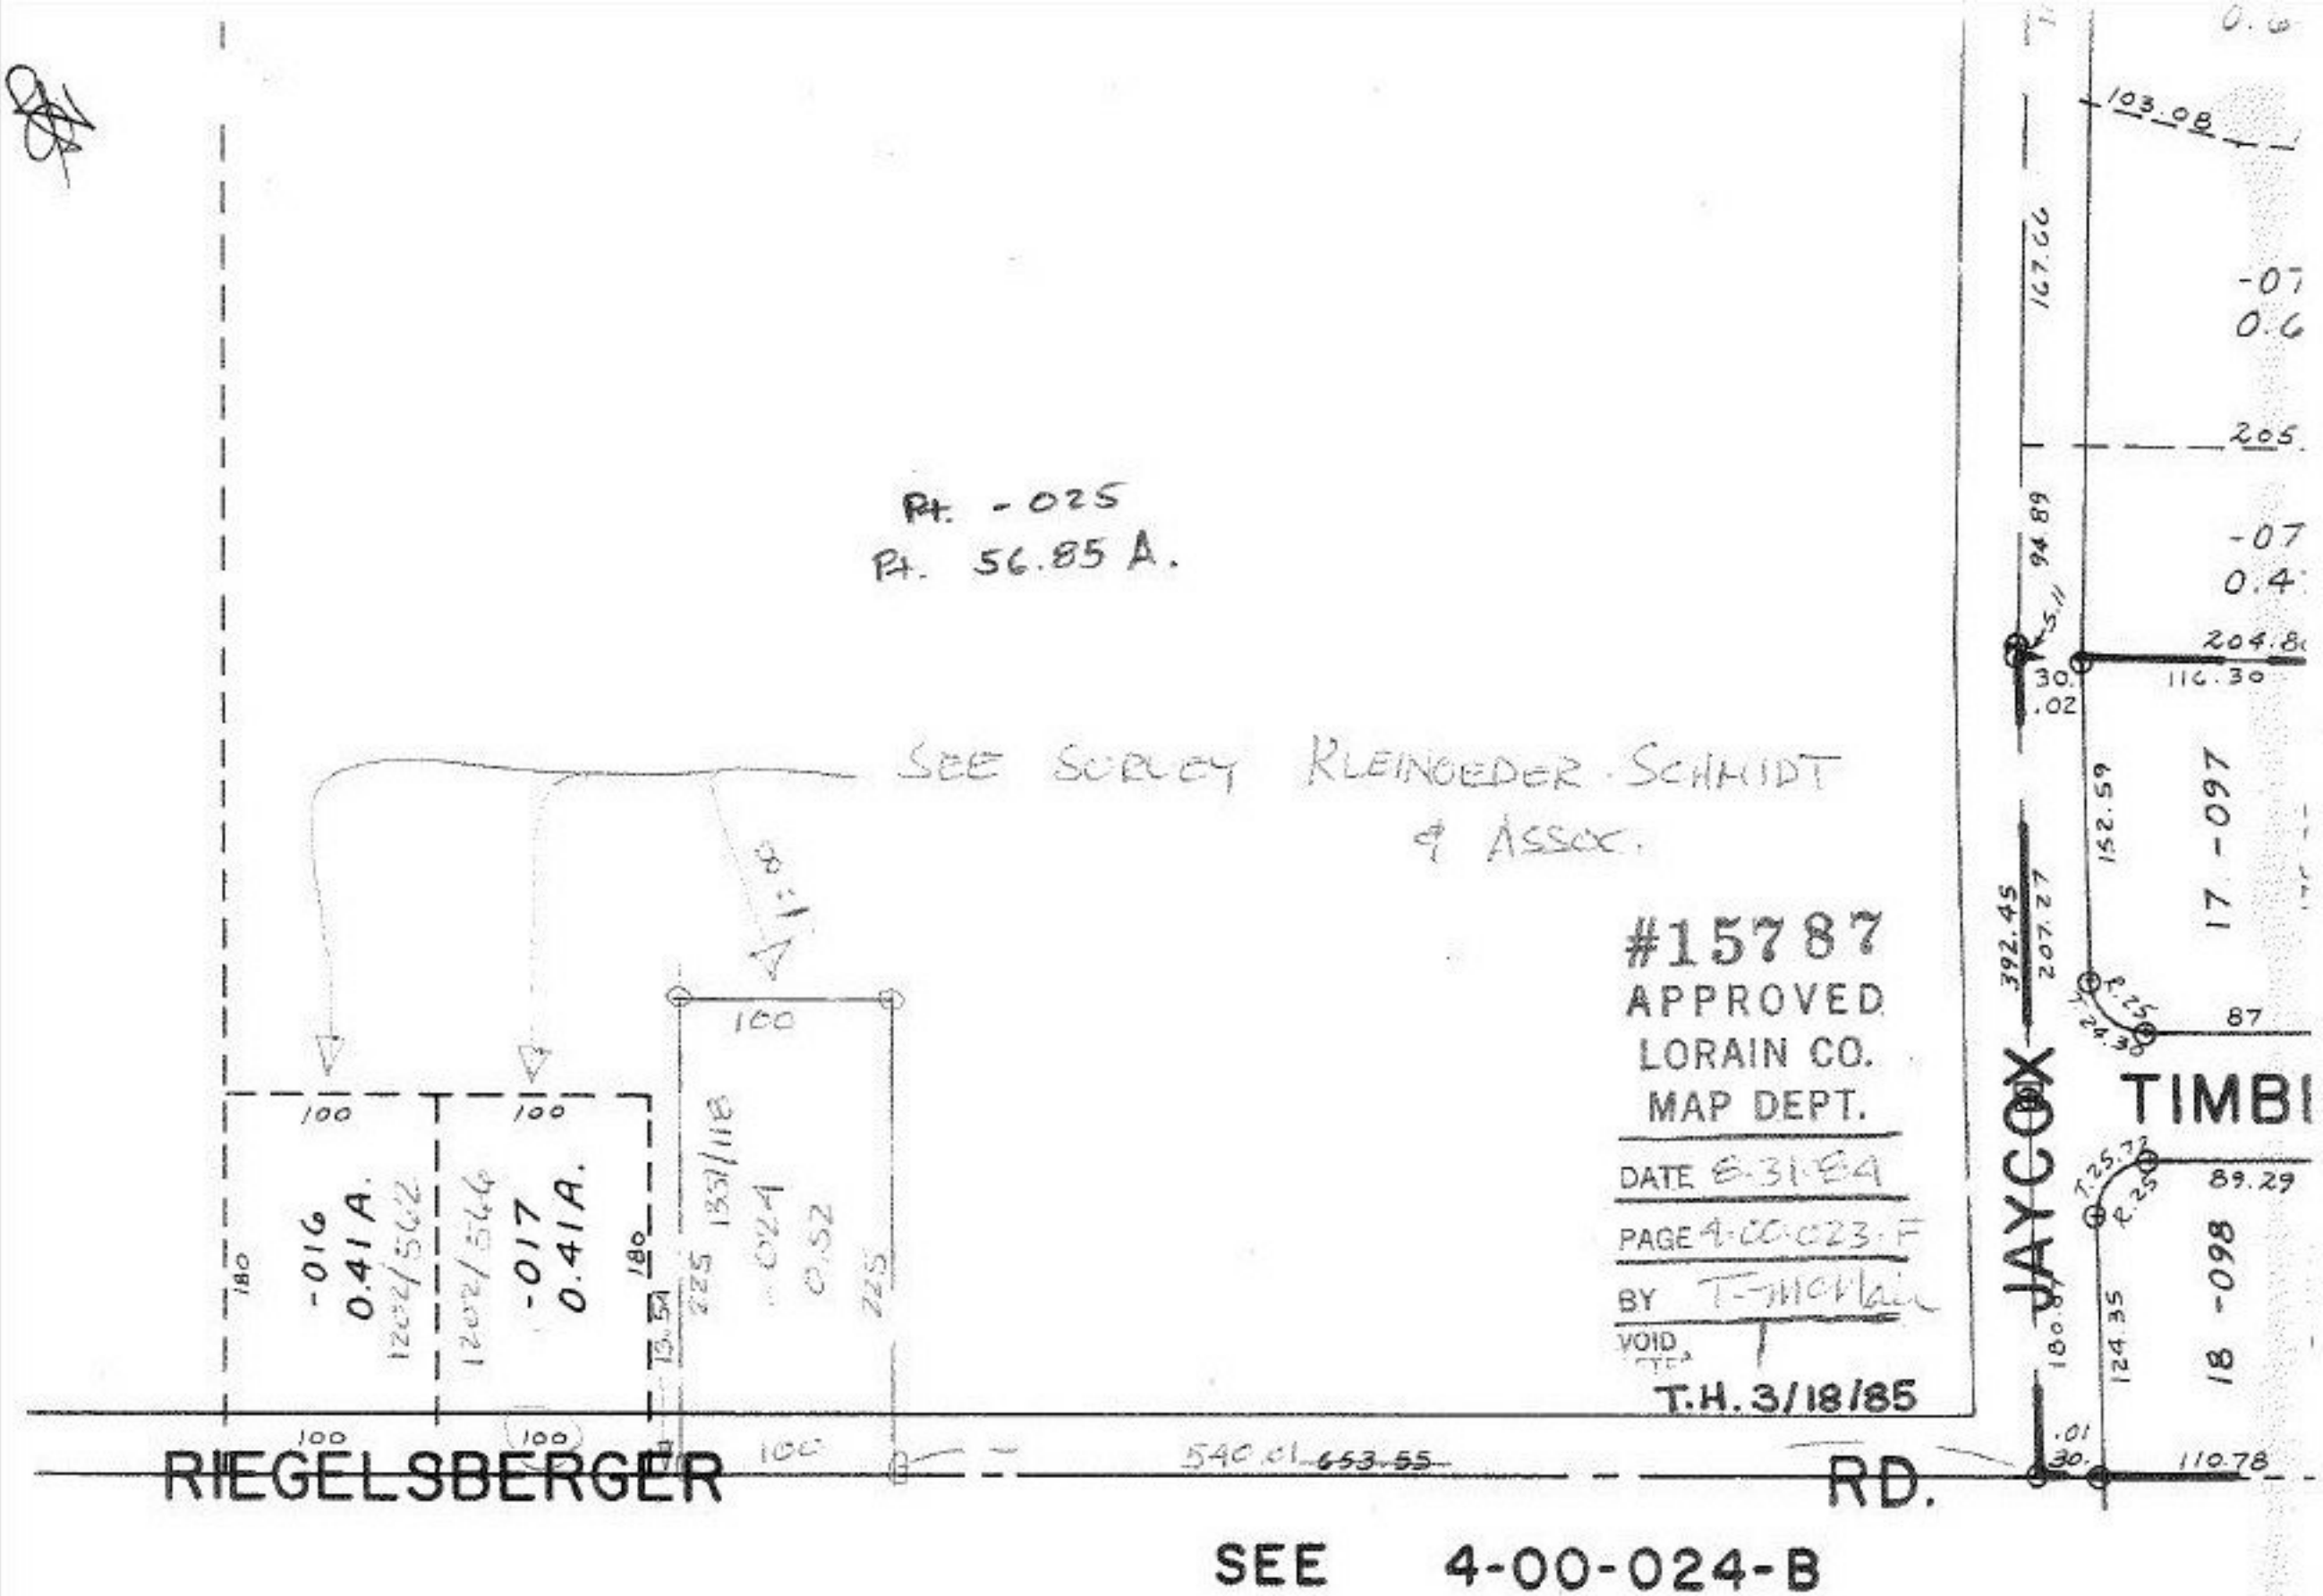

Pt. -025
Pt. 56.85 A.
SEE SURVEY KLEINOEDER SCHMIDT & ASSOC.
#15787
APPROVED
LORAIN CO.
MAP DEPT.
DATE 8-31-84
PAGE 4-00-023-F
BY T-McNair
VOID
T.H. 3/18/85
-016
0.41 A.
1202/562
-017
0.41 A.
1202/566
1351/118
-024
0.52
100
180
225
13.54
540.01
653.55
RIEGELSBERGER
RD.
JAYCOX
TIMBI
103.08
167.66
205
94.89
204.8
116.30
152.59
392.45
207.27
87
89.29
124.35
110.78
17 -097
18 -098

SEE 4-00-024-B