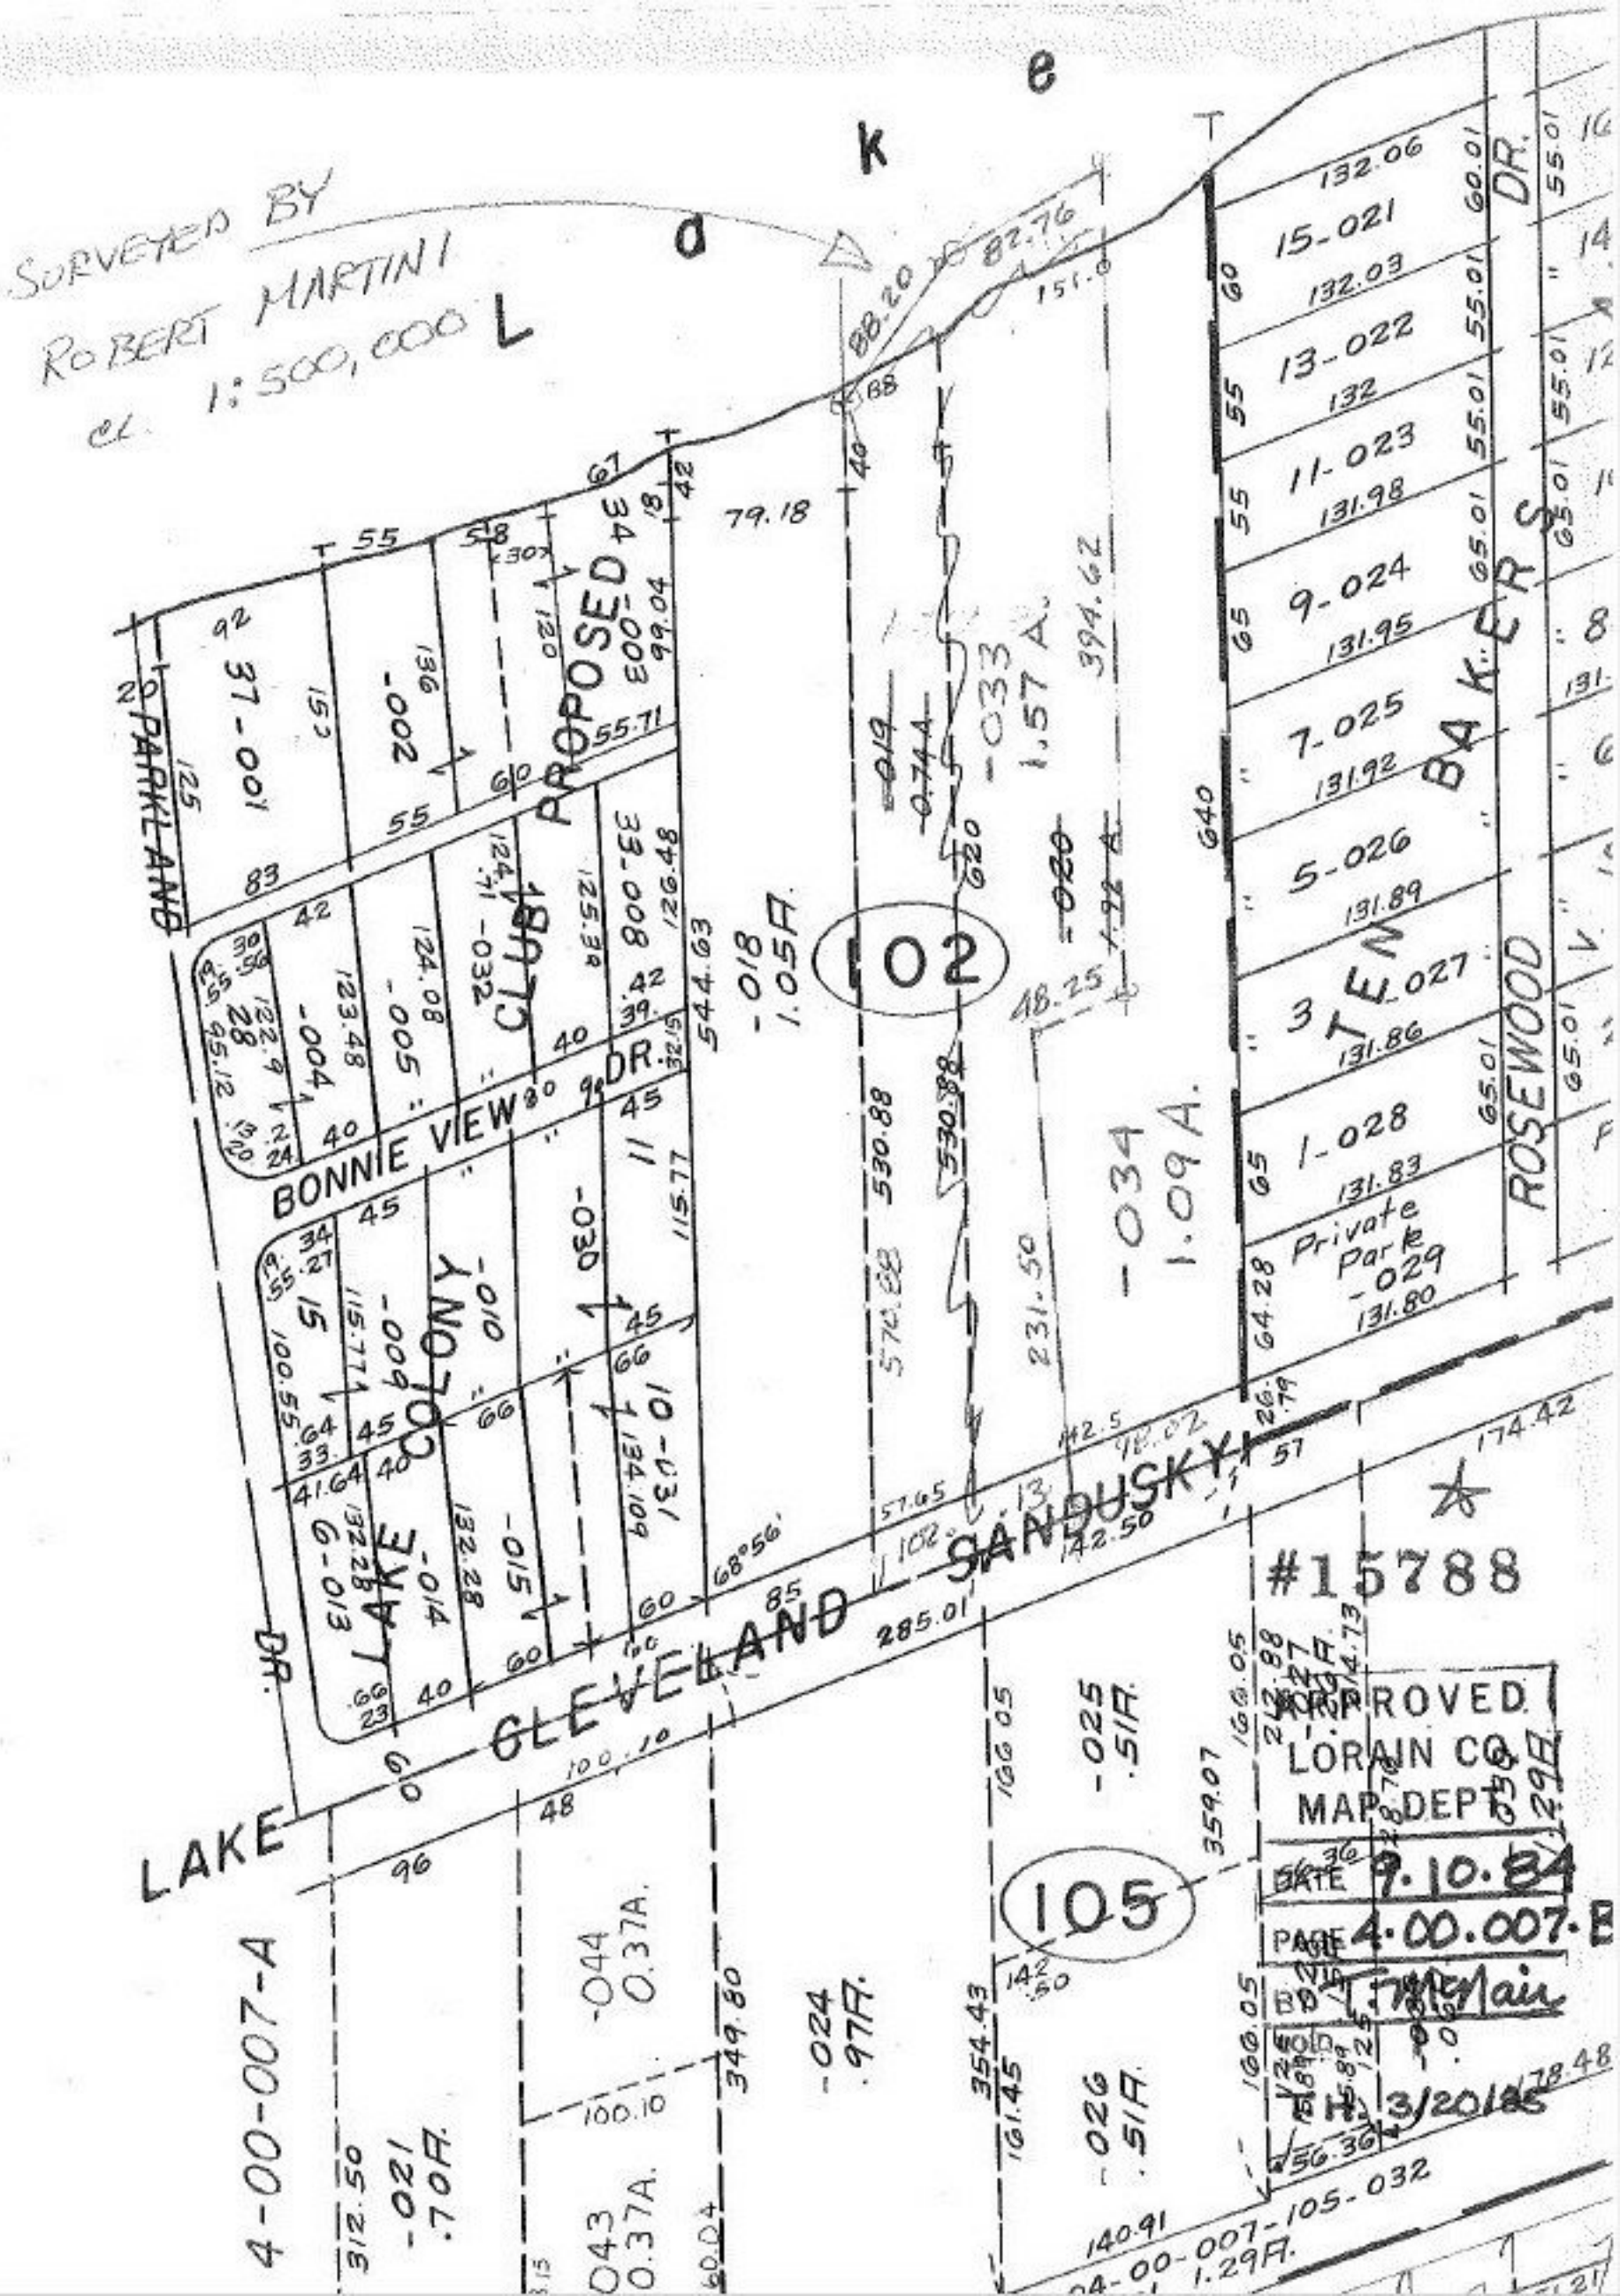SURVEYED BY
ROBERT MARTINI
@ 1:500,000