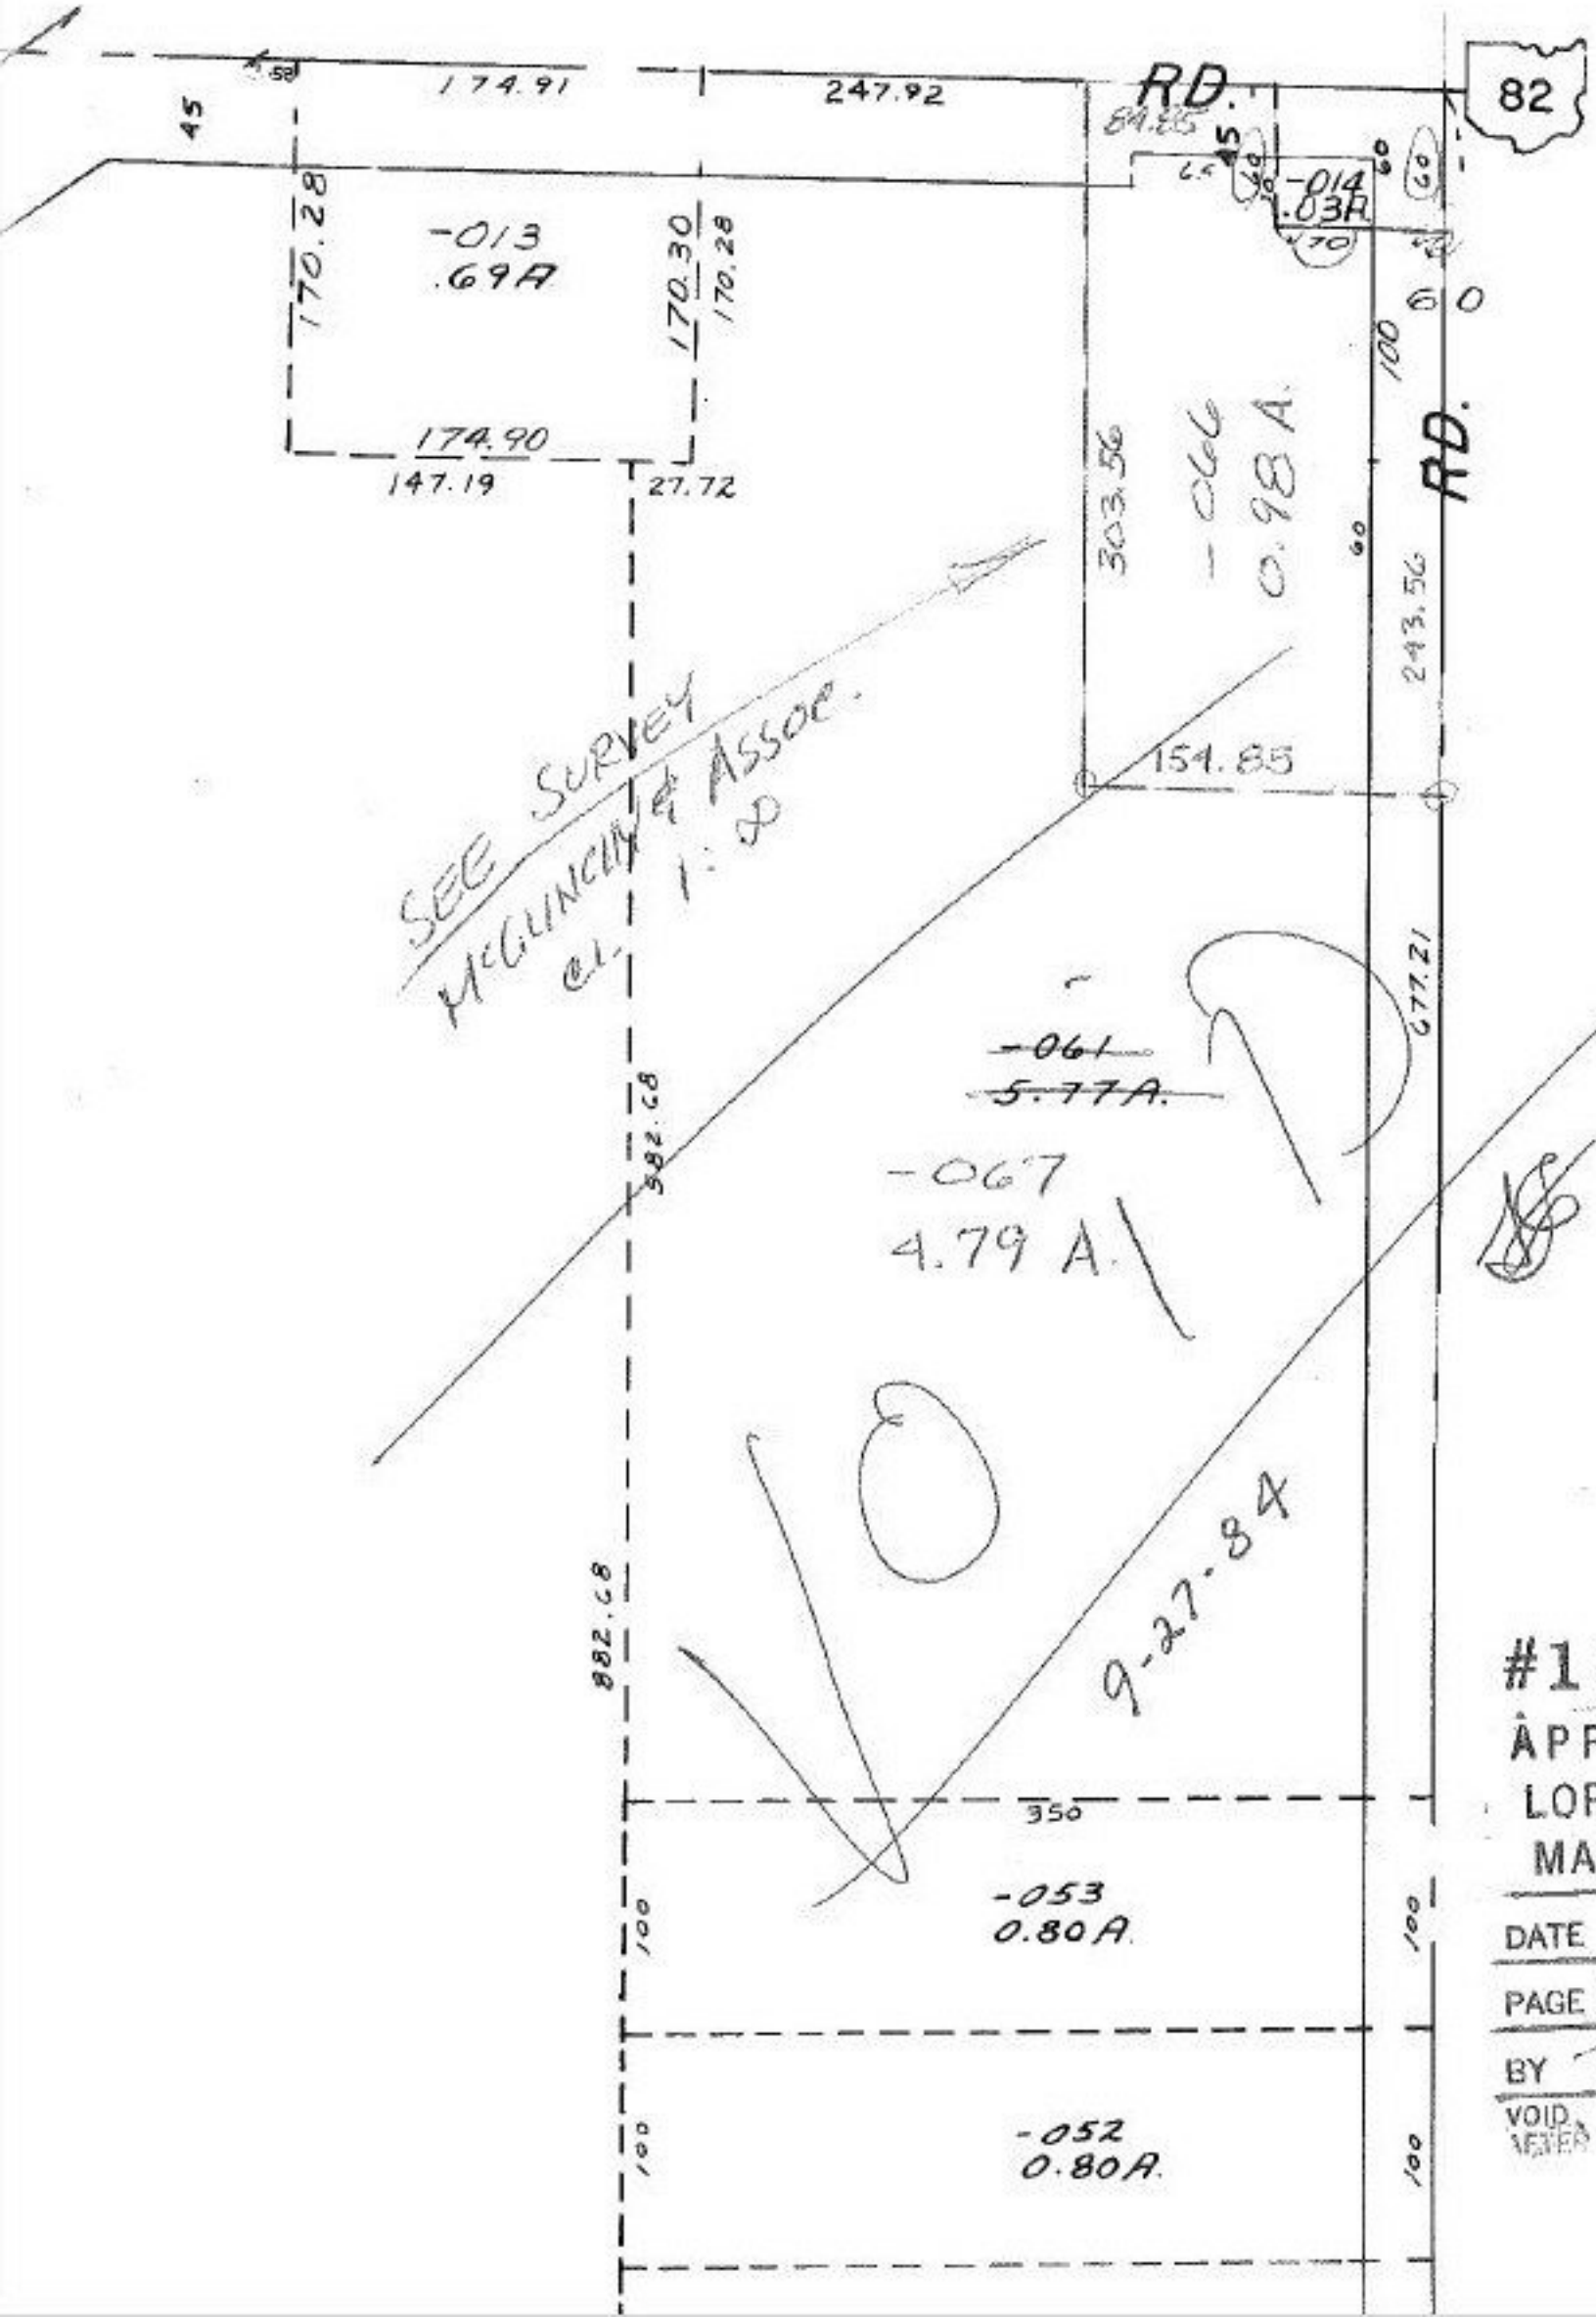

#15802
APPROVED
LORAIN CO.
MAP DEPT.
DATE 9.17.84
PAGE 11-00-016-B
BY T. McNair
VOID