SEE 4-00-018-D

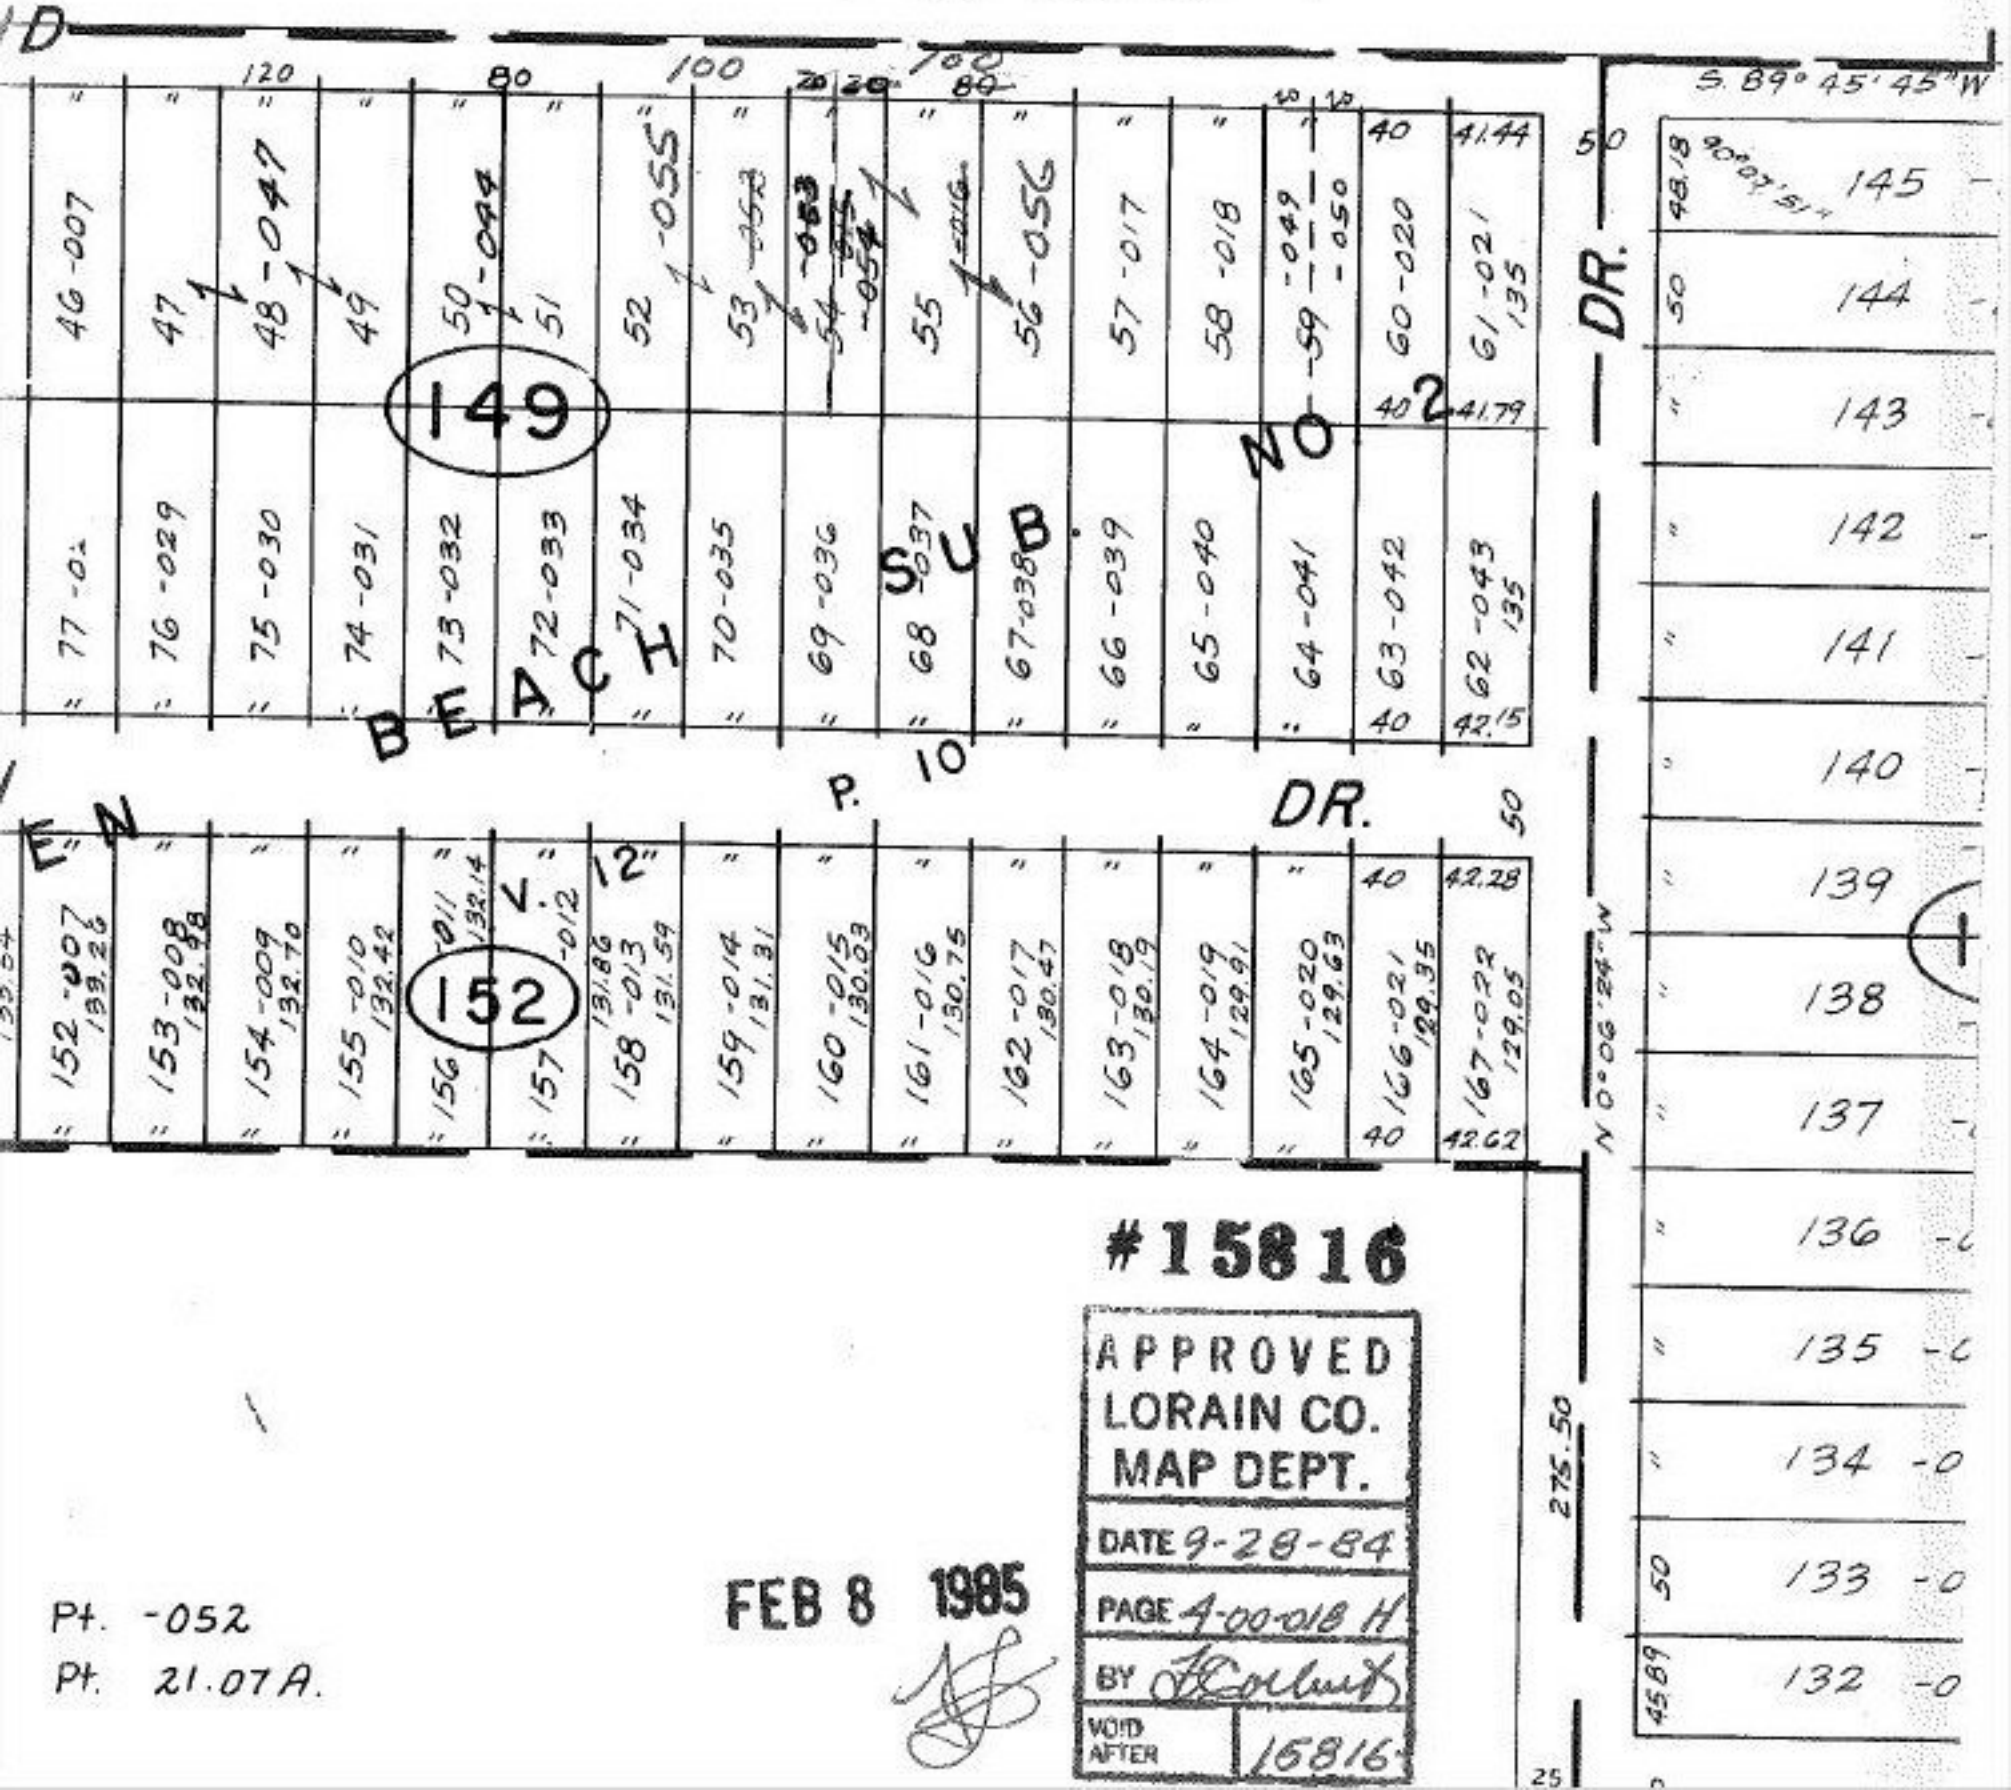


#15816

APPROVED
LORAIN CO.
MAP DEPT.
DATE 9-28-84
PAGE 4-00-018 H
BY
VOID AFTER 16816

FEB 8 1985

Pt. -052
Pt. 21.07A.