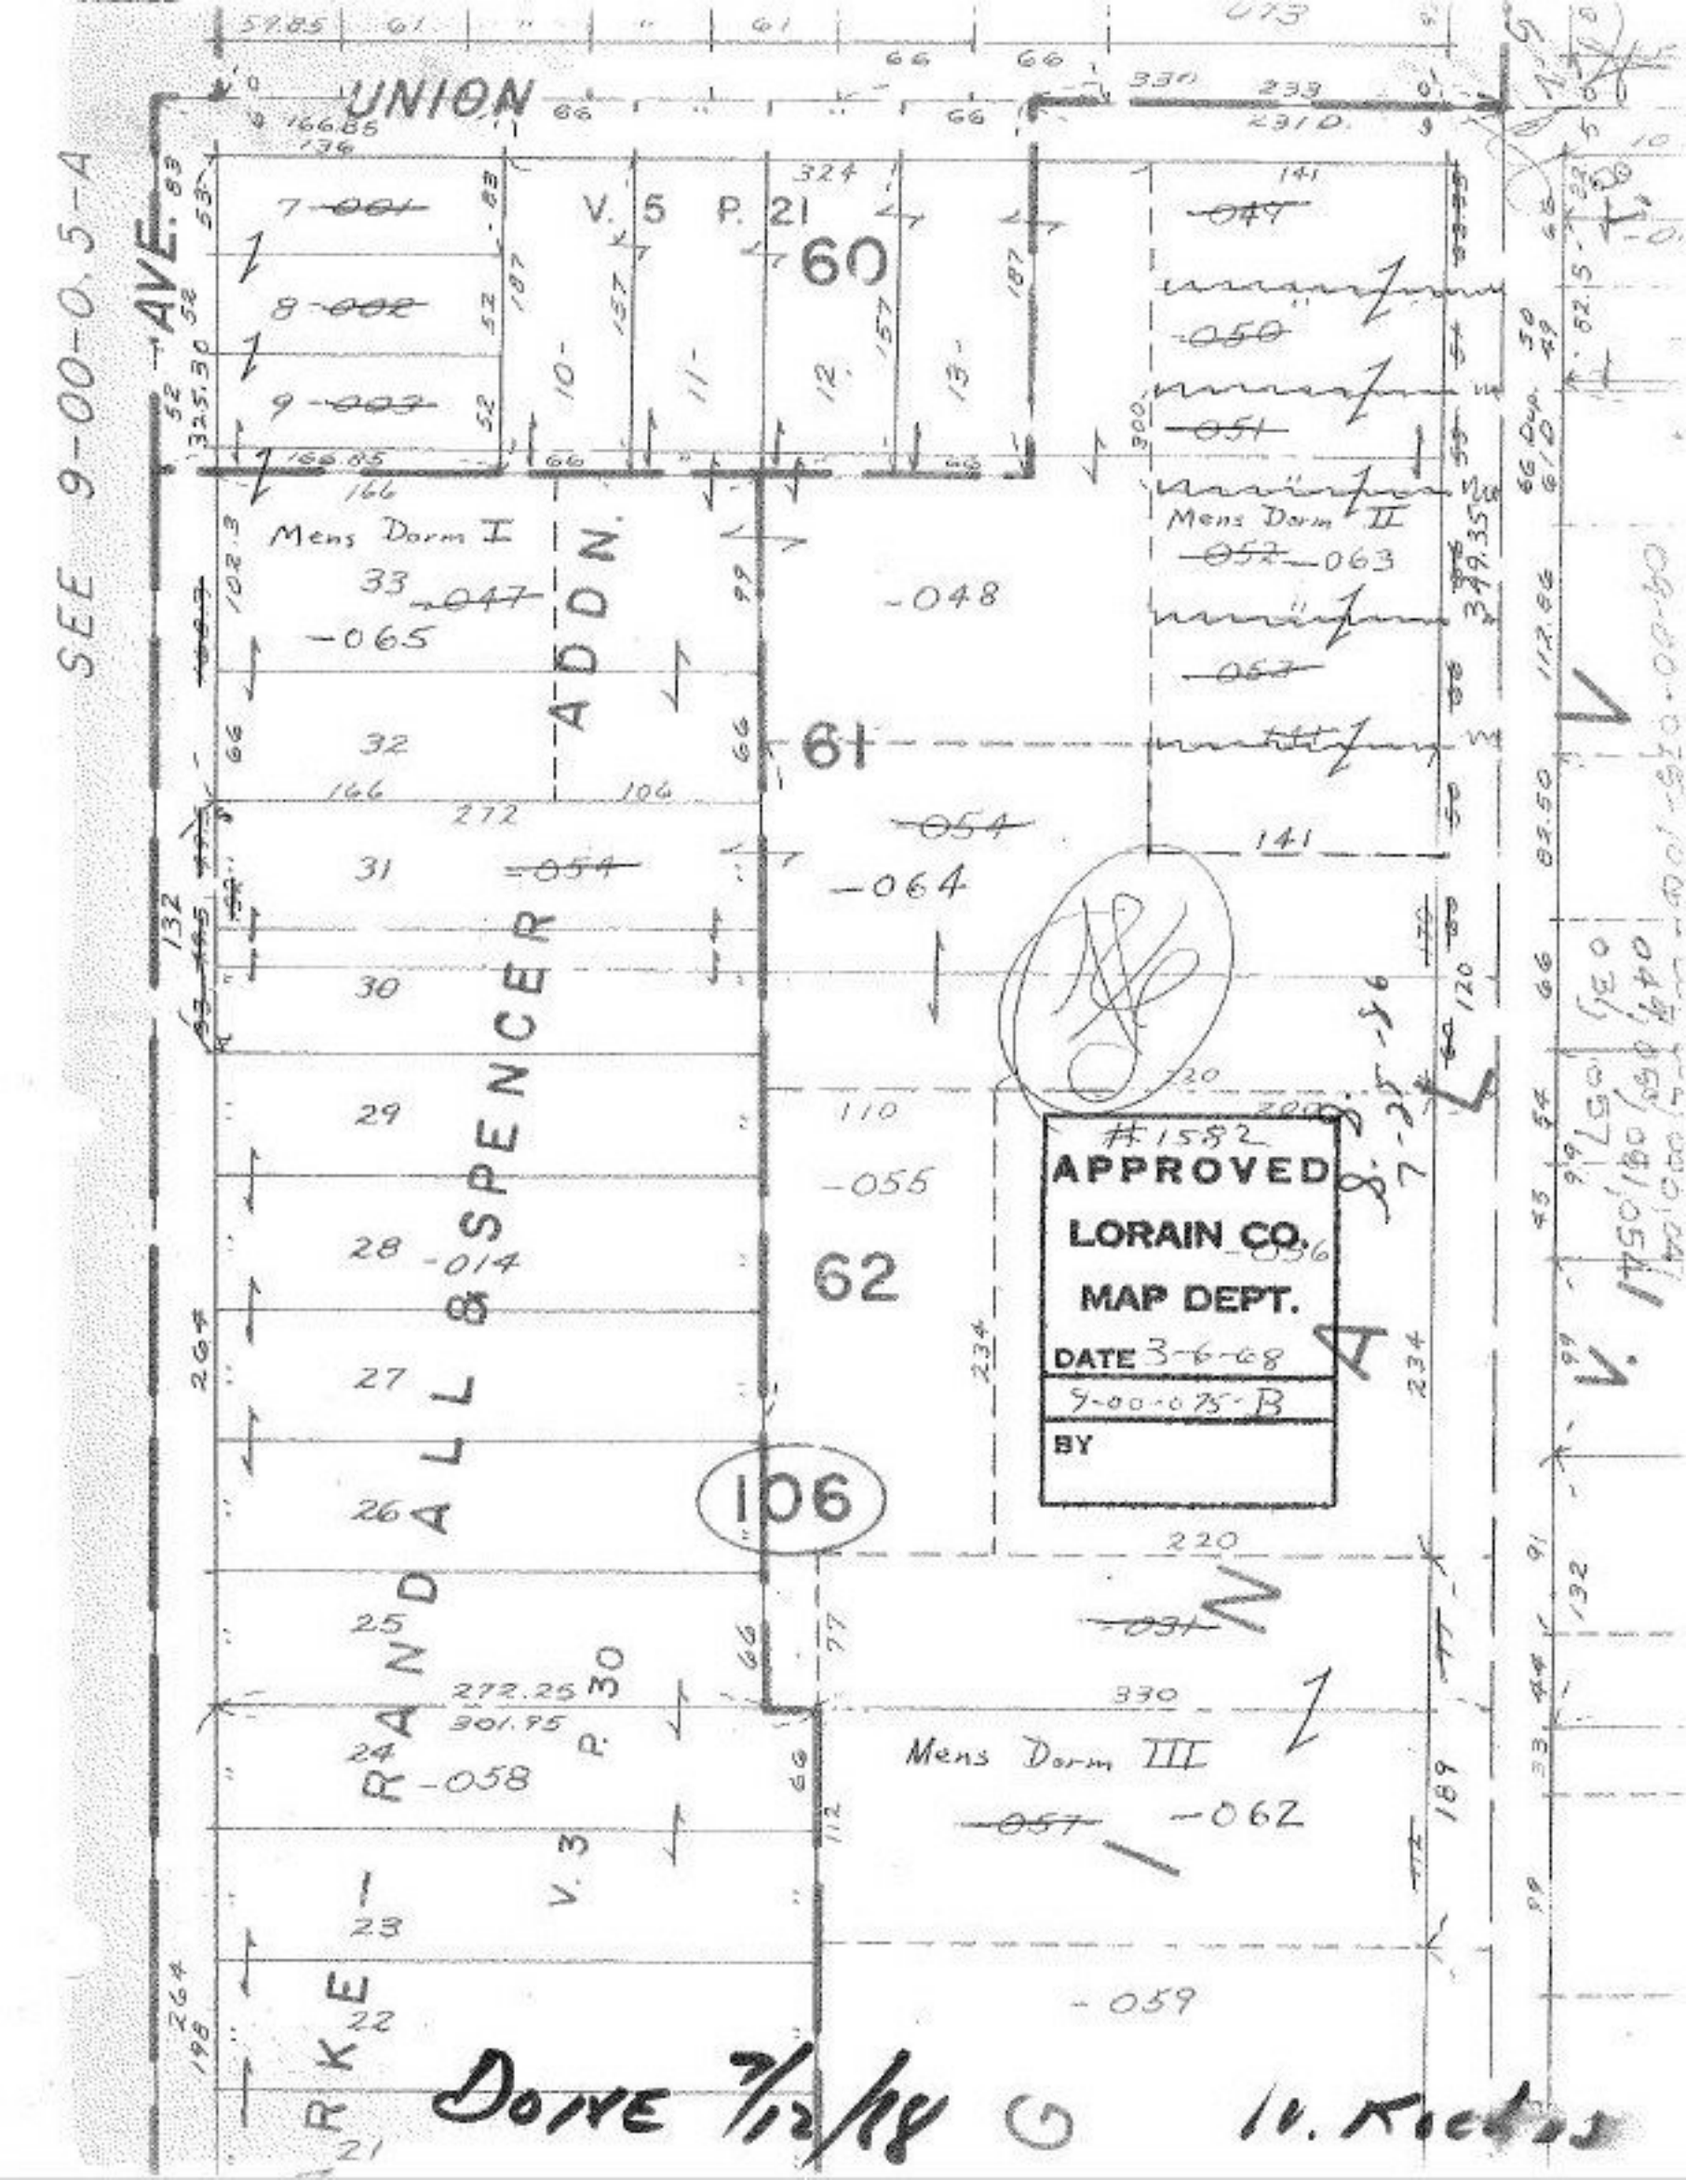

UNION
AVE.
SEE 9-00-0.5-A
V. 5 P. 21
60
61
62
106
Mens Dorm I
Mens Dorm II
Mens Dorm III
ADDN.
RANDALL & SPENCER
V. 3 P. 30
#1582
APPROVED
LORAIN CO.
MAP DEPT.
DATE 3-6-68
9-00-075-B
BY
Done 7/12/68