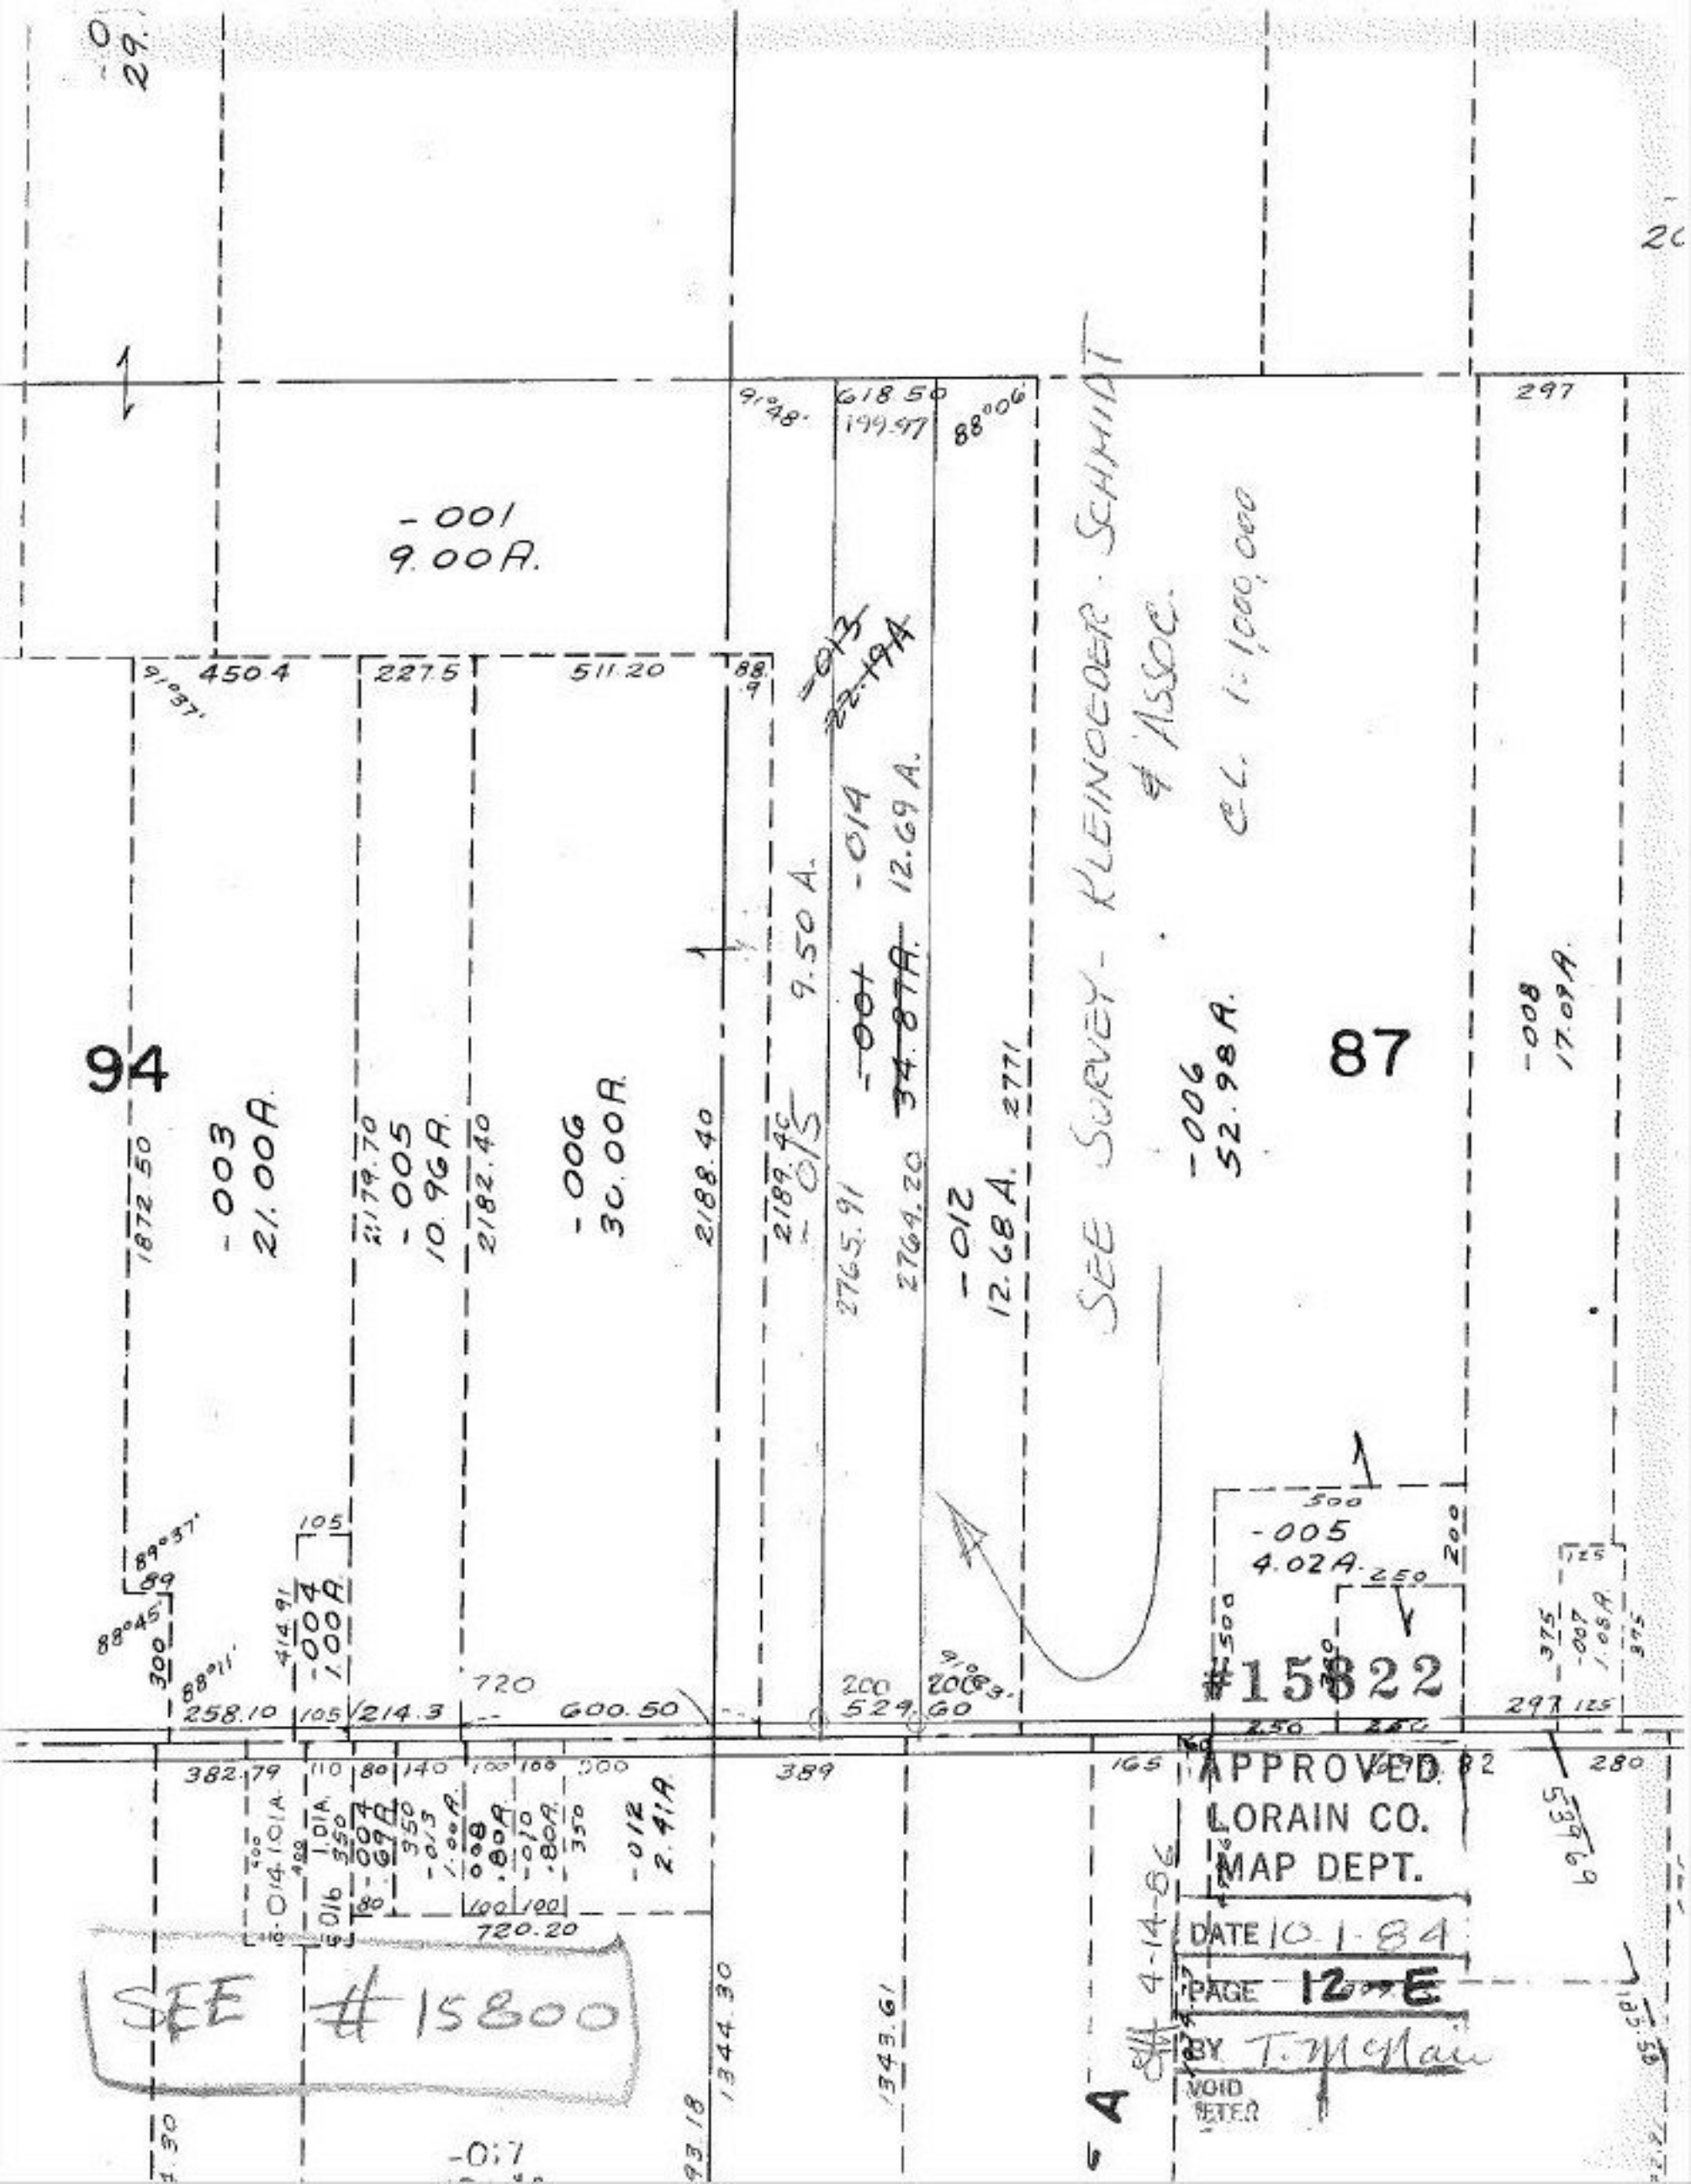
94
87
-001
9.00A.
-003
21.00A.
-005
10.96A.
-006
30.00A.
-012
12.68A.
-006
52.98A.
-005
4.02A.
-004
1.00A.
-012
2.41A.
-014
12.69A.
9.50 A.
SEE SURVEY - KLEINOEDER - SCHMIDT & ASSOC.
C.L. 1:1,000,000
SEE #15800
#15822
APPROVED
LORAIN CO.
MAP DEPT.
DATE 10-1-84
PAGE 12-E
BY T. McMain
VOID AFTER