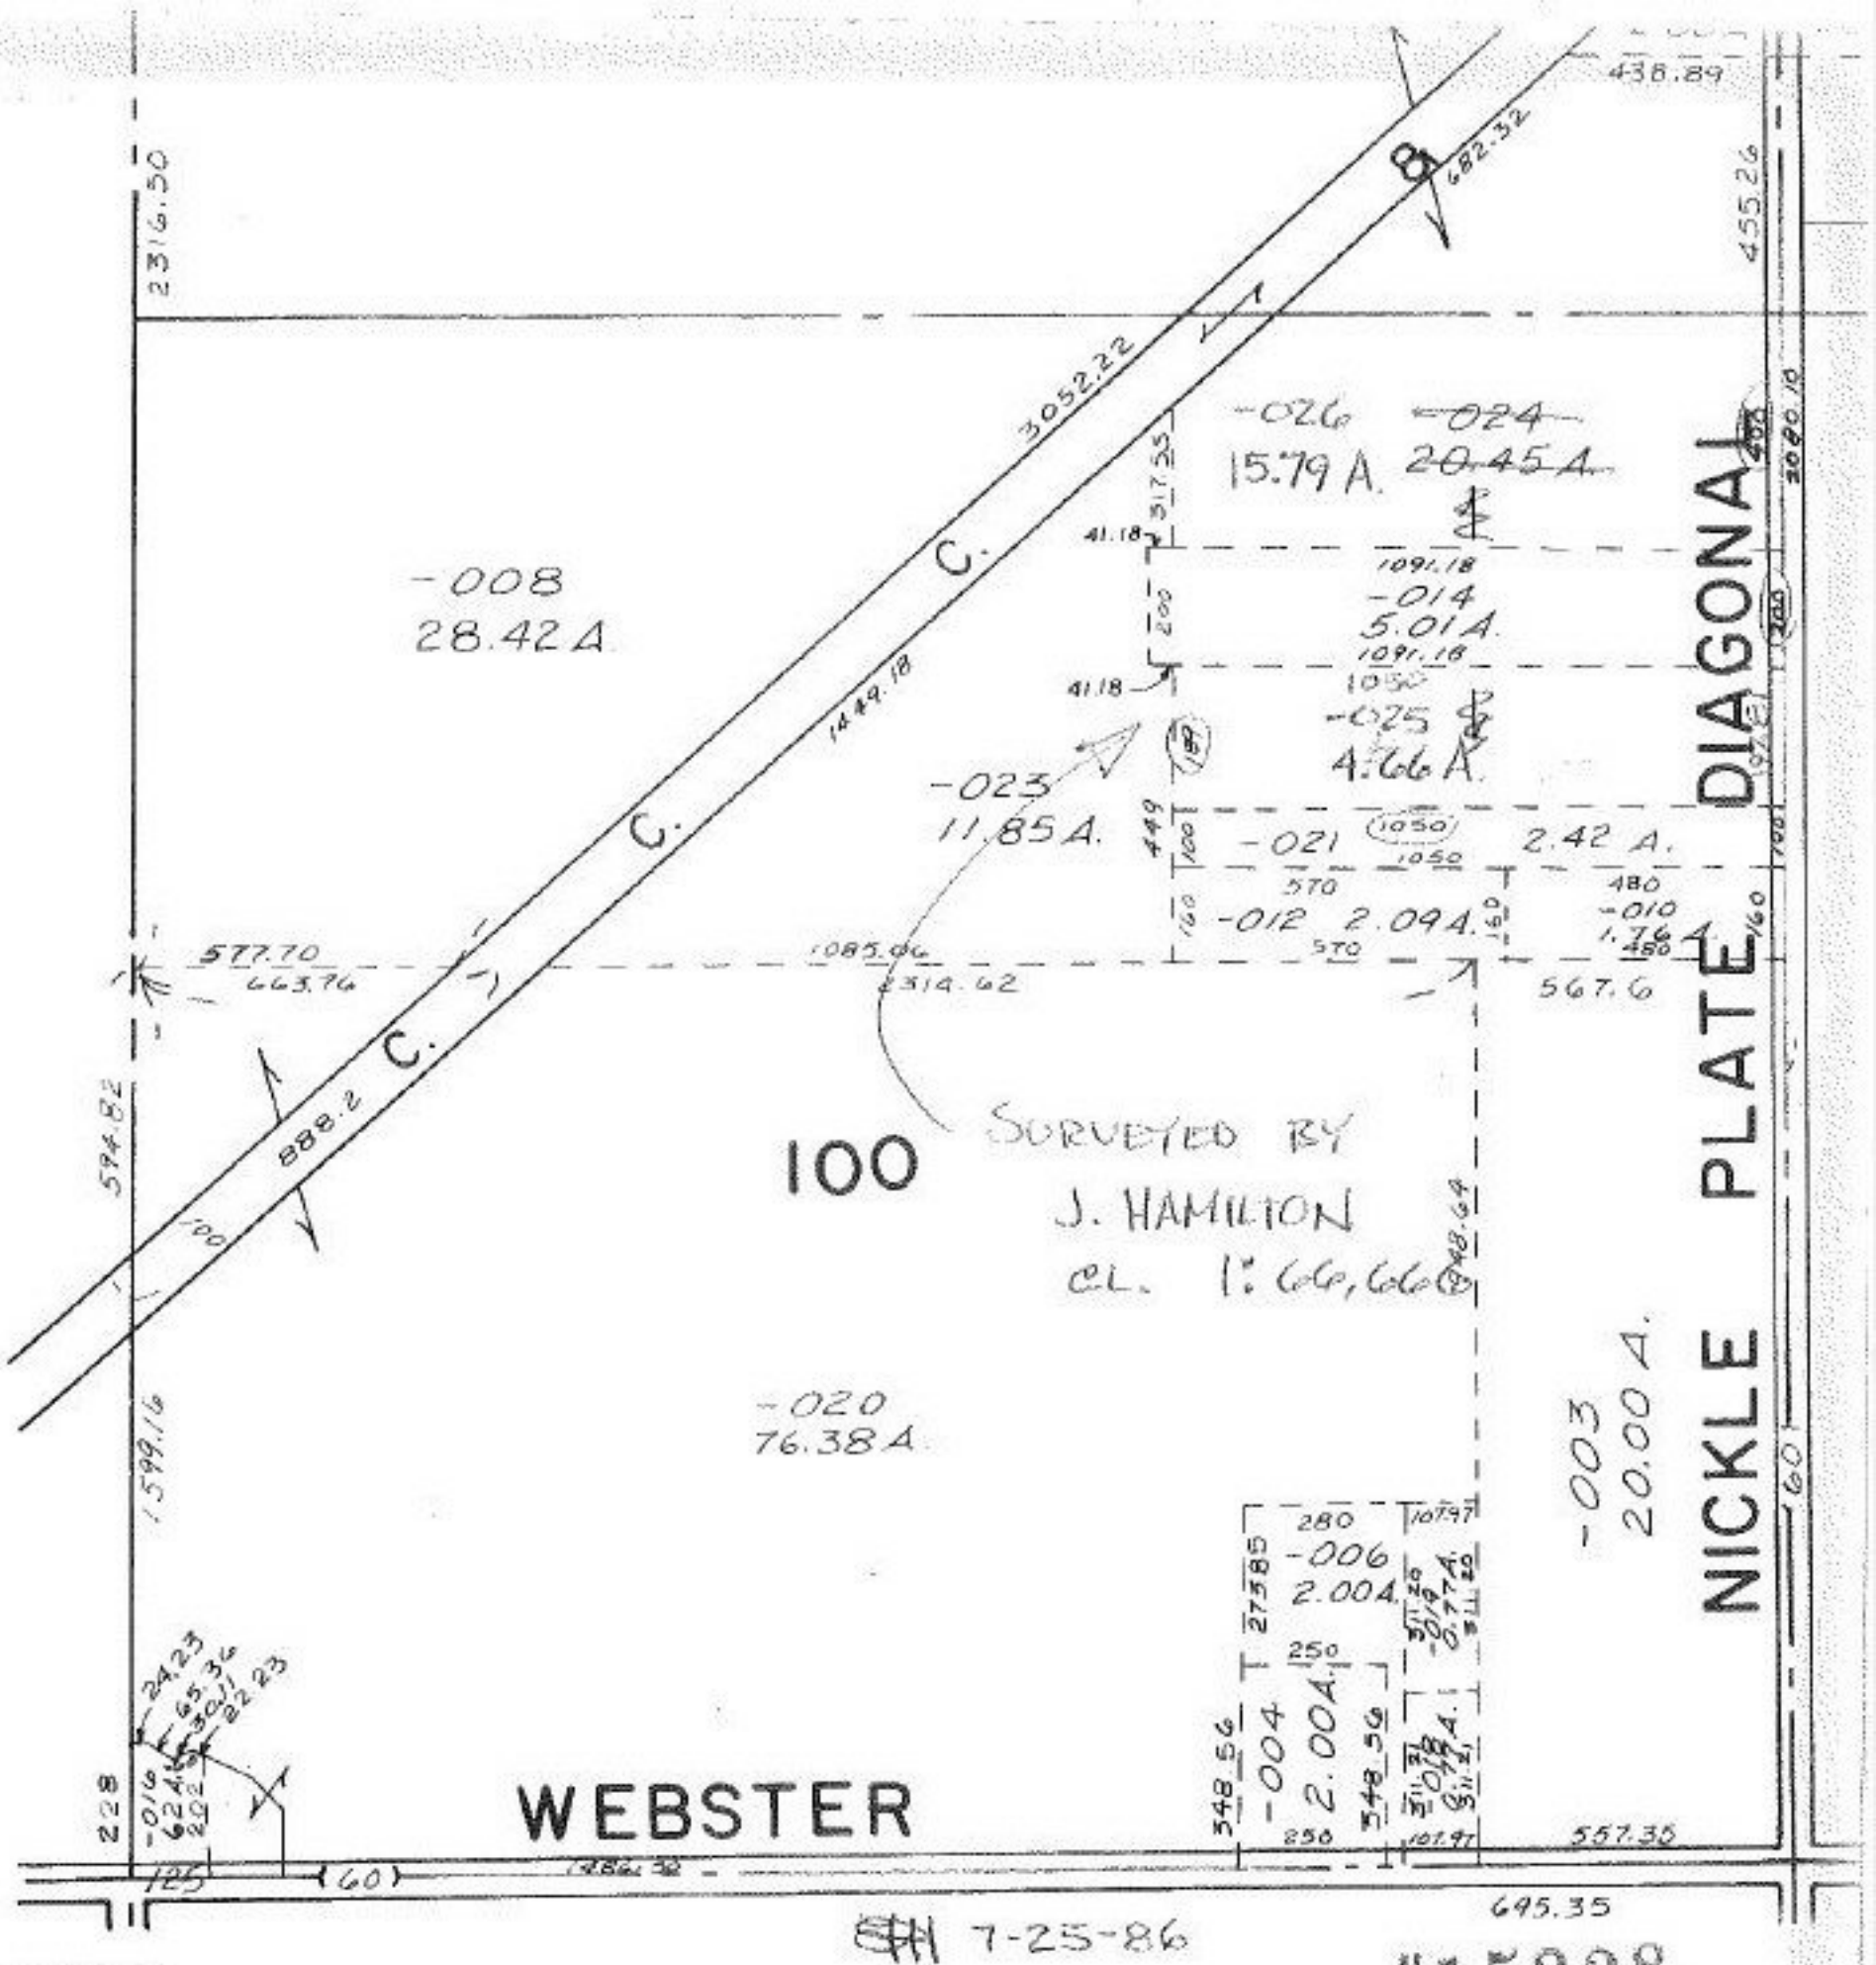

7-25-86

REVISED

15-E

LOTS 58 THRU 63, 78 THR

#15828

APPROVED
LORAIN CO.
MAP DEPT.
DATE 10-3-84
PAGE 15-E
BY T. McNair
VOID