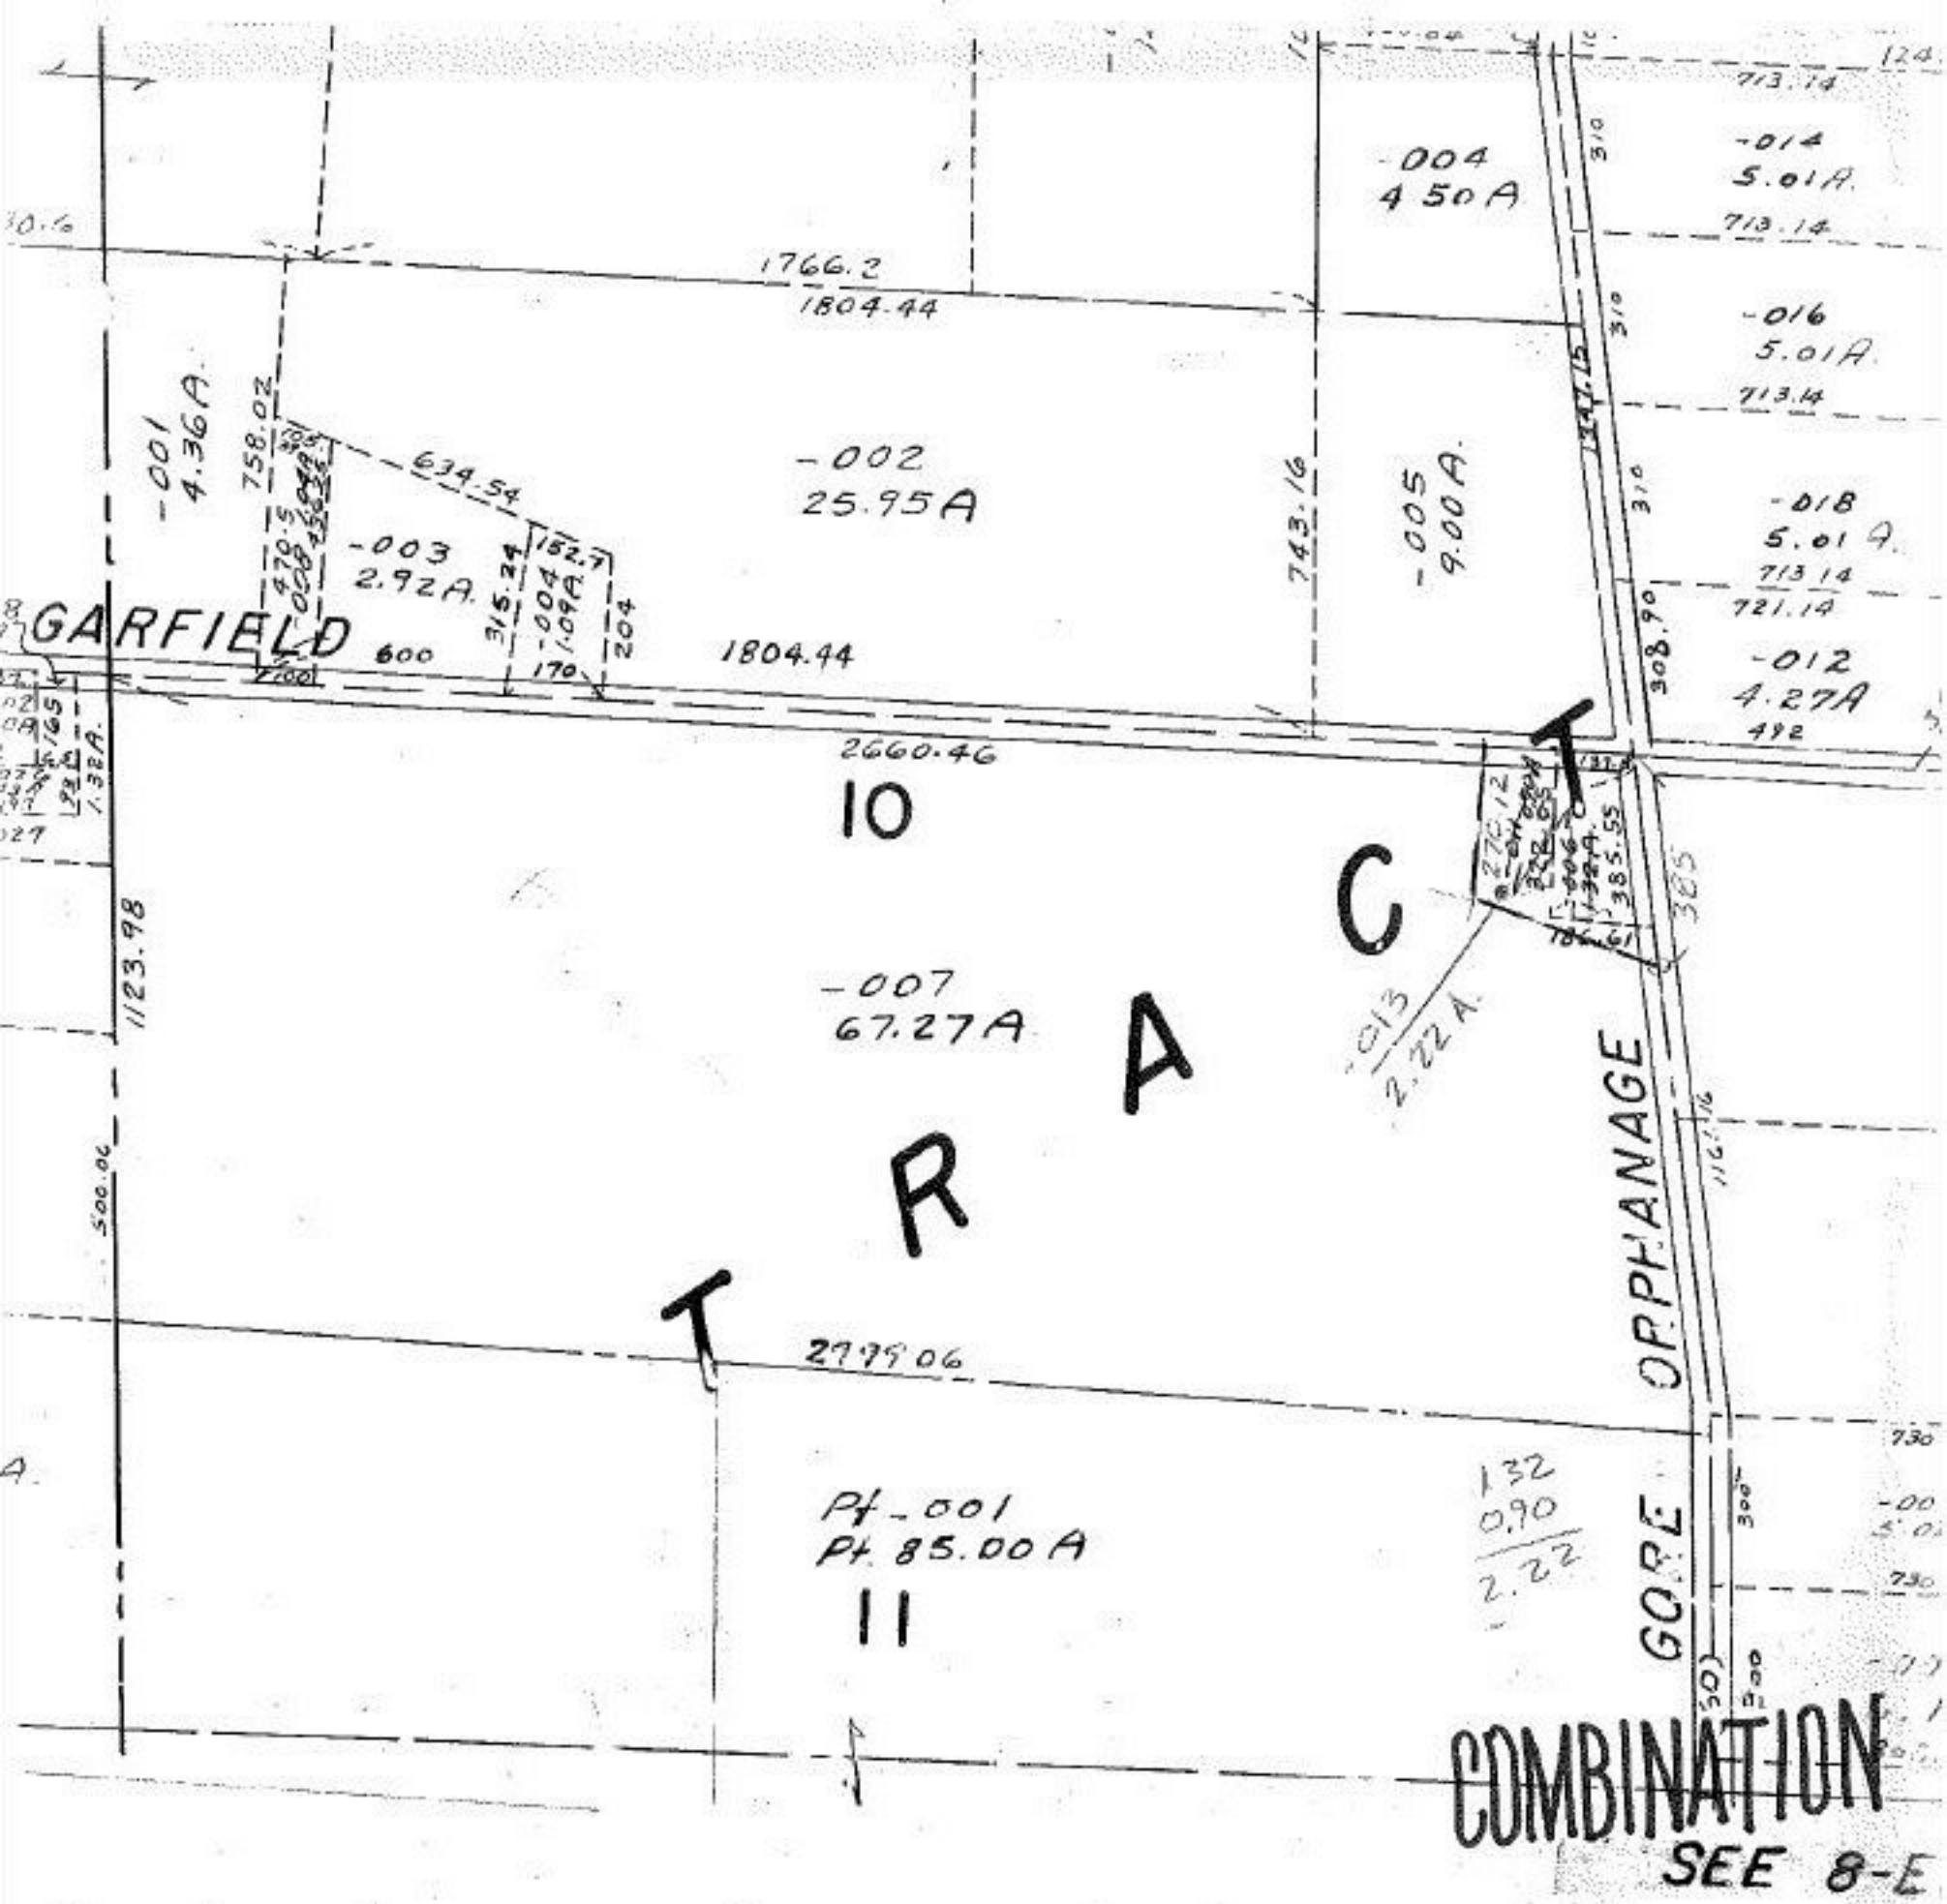

#15830

APPROVED
LORAIN CO.
MAP DEPT.

DATE 10.4.84

PAGE 8-A

BY T. McNair

VOID

9-16-85