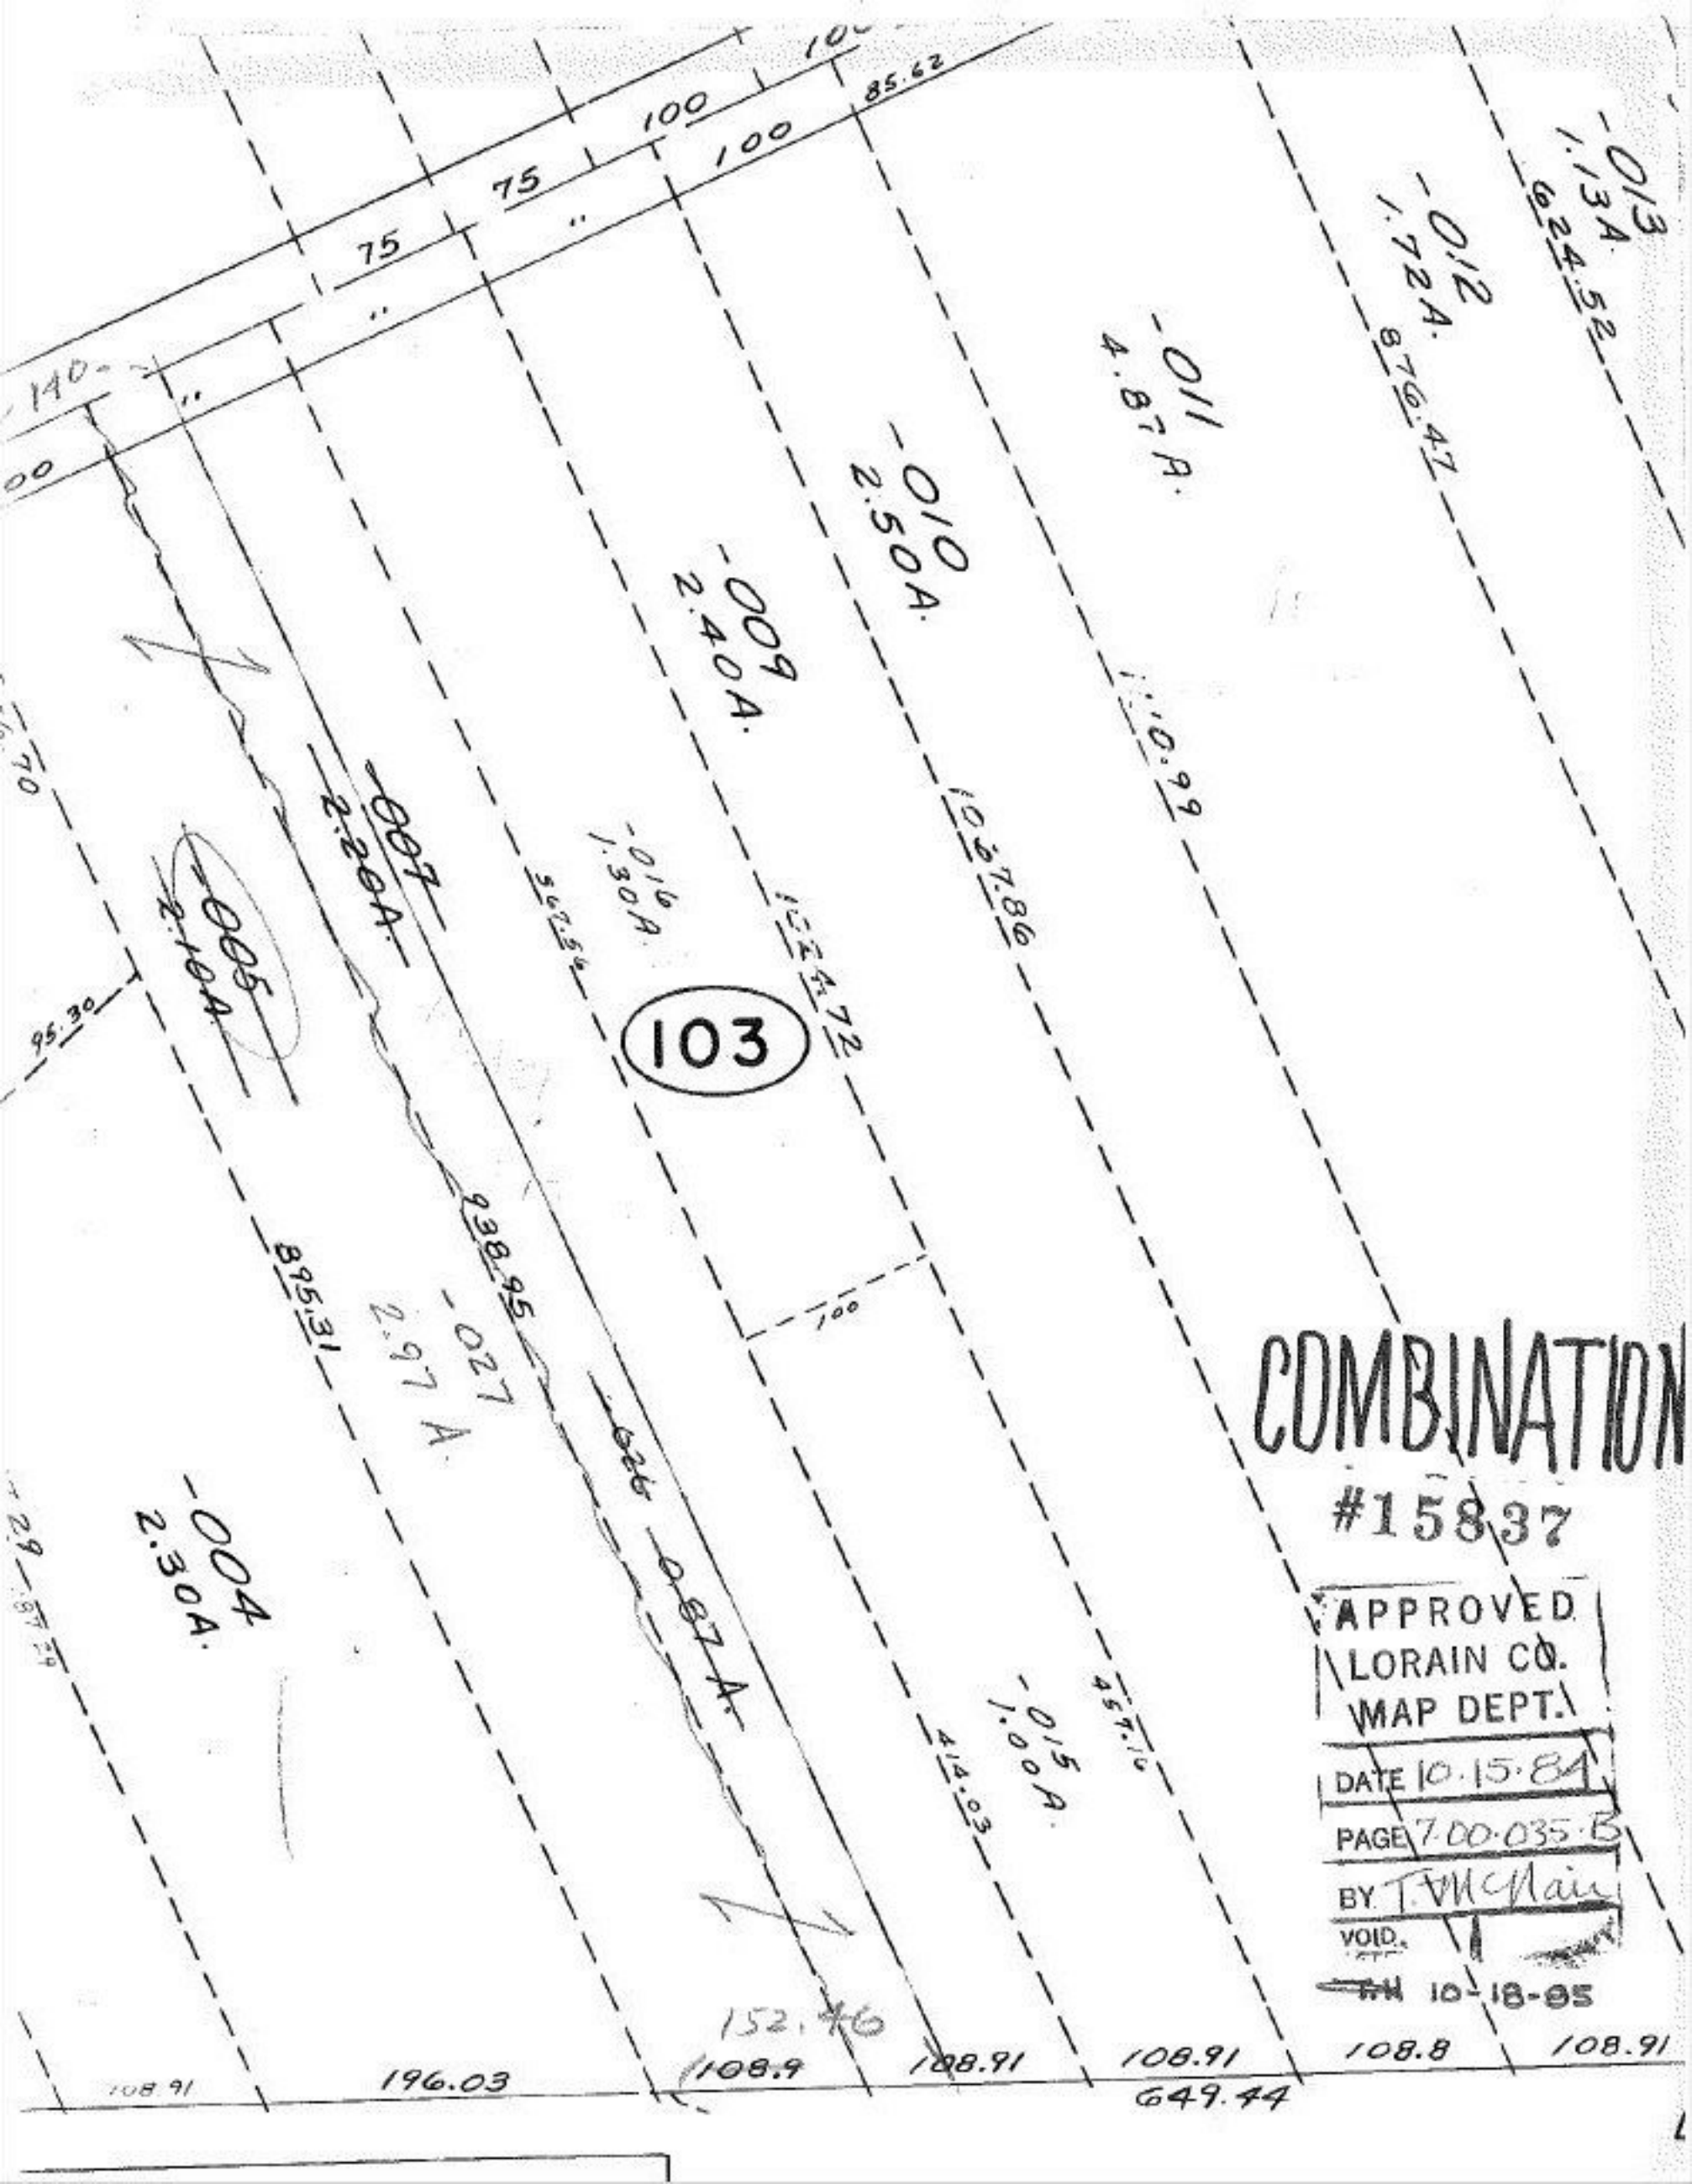

-013
1.13A.
624.52
-012
1.72A.
876.47
-011
4.87A.
-010
2.50A.
-009
2.40A.
1110.99
1067.86
-016
1.30A.
567.56
1024.72
-007
2.20A.
-005
2.10A.
103
95.30
938.95
895.31
-027
2.97 A.
-026
0.87 A.
-004
2.30A.
-015
1.00A.
414.03
457.16
152.46
108.91
196.03
108.9
108.91
108.91
108.8
108.91
649.44
COMBINATION
#15837
APPROVED
LORAIN CO.
MAP DEPT.
DATE 10.15.84
PAGE 7.00.035.B
BY T.McNair
VOID.
10-18-85