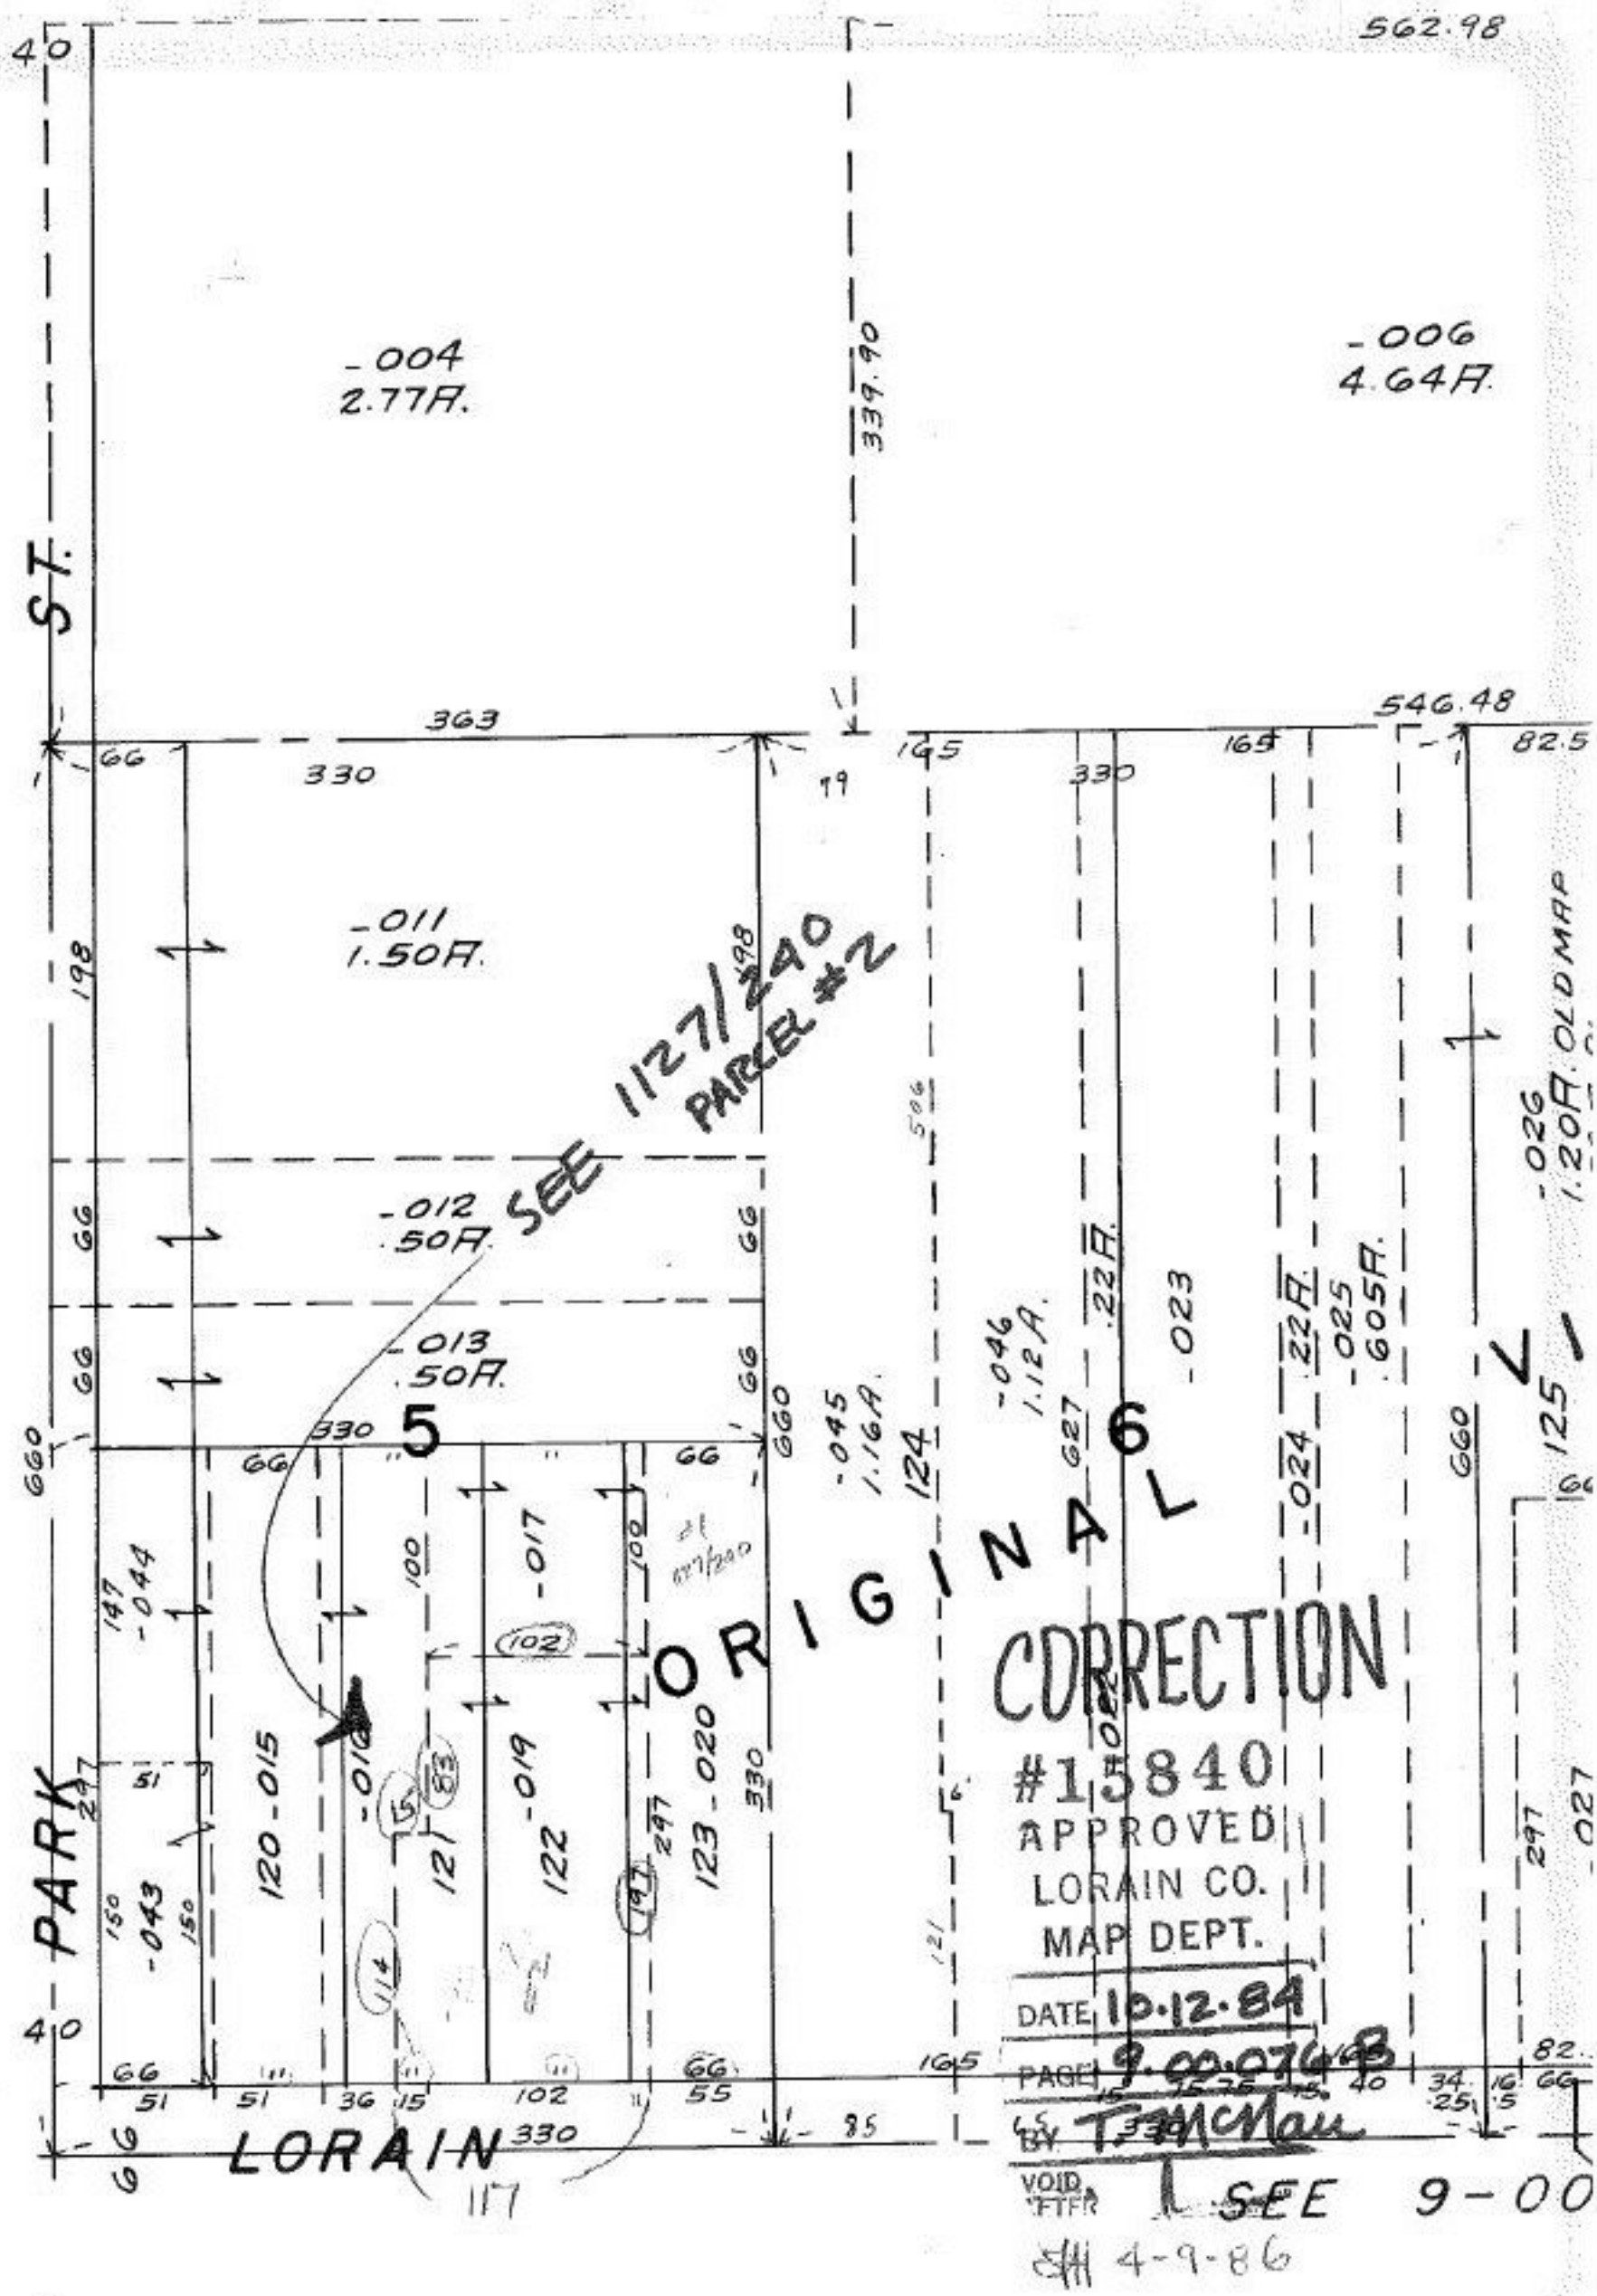

562.98
-004
2.77A.
339.90
-006
4.64A.
ST.
363
546.48
330
165
82.5
-011
1.50A.
SEE 1127/240 PARCEL #2
-012
.50A.
-013
.50A.
-045
1.16A.
-046
1.12A.
-023
-025
.605A.
-026
1.20A. OLD MAP
5
6
ORIGINAL
CORRECTION
#15840
APPROVED
LORAIN CO.
MAP DEPT.
DATE 10.12.84
PAGE 9.00.076B
BY T. McNair
VOID AFTER
SEE 9-00
PARK
LORAIN
120-015
121
122
123-020
-017
-019
-044
-043
117