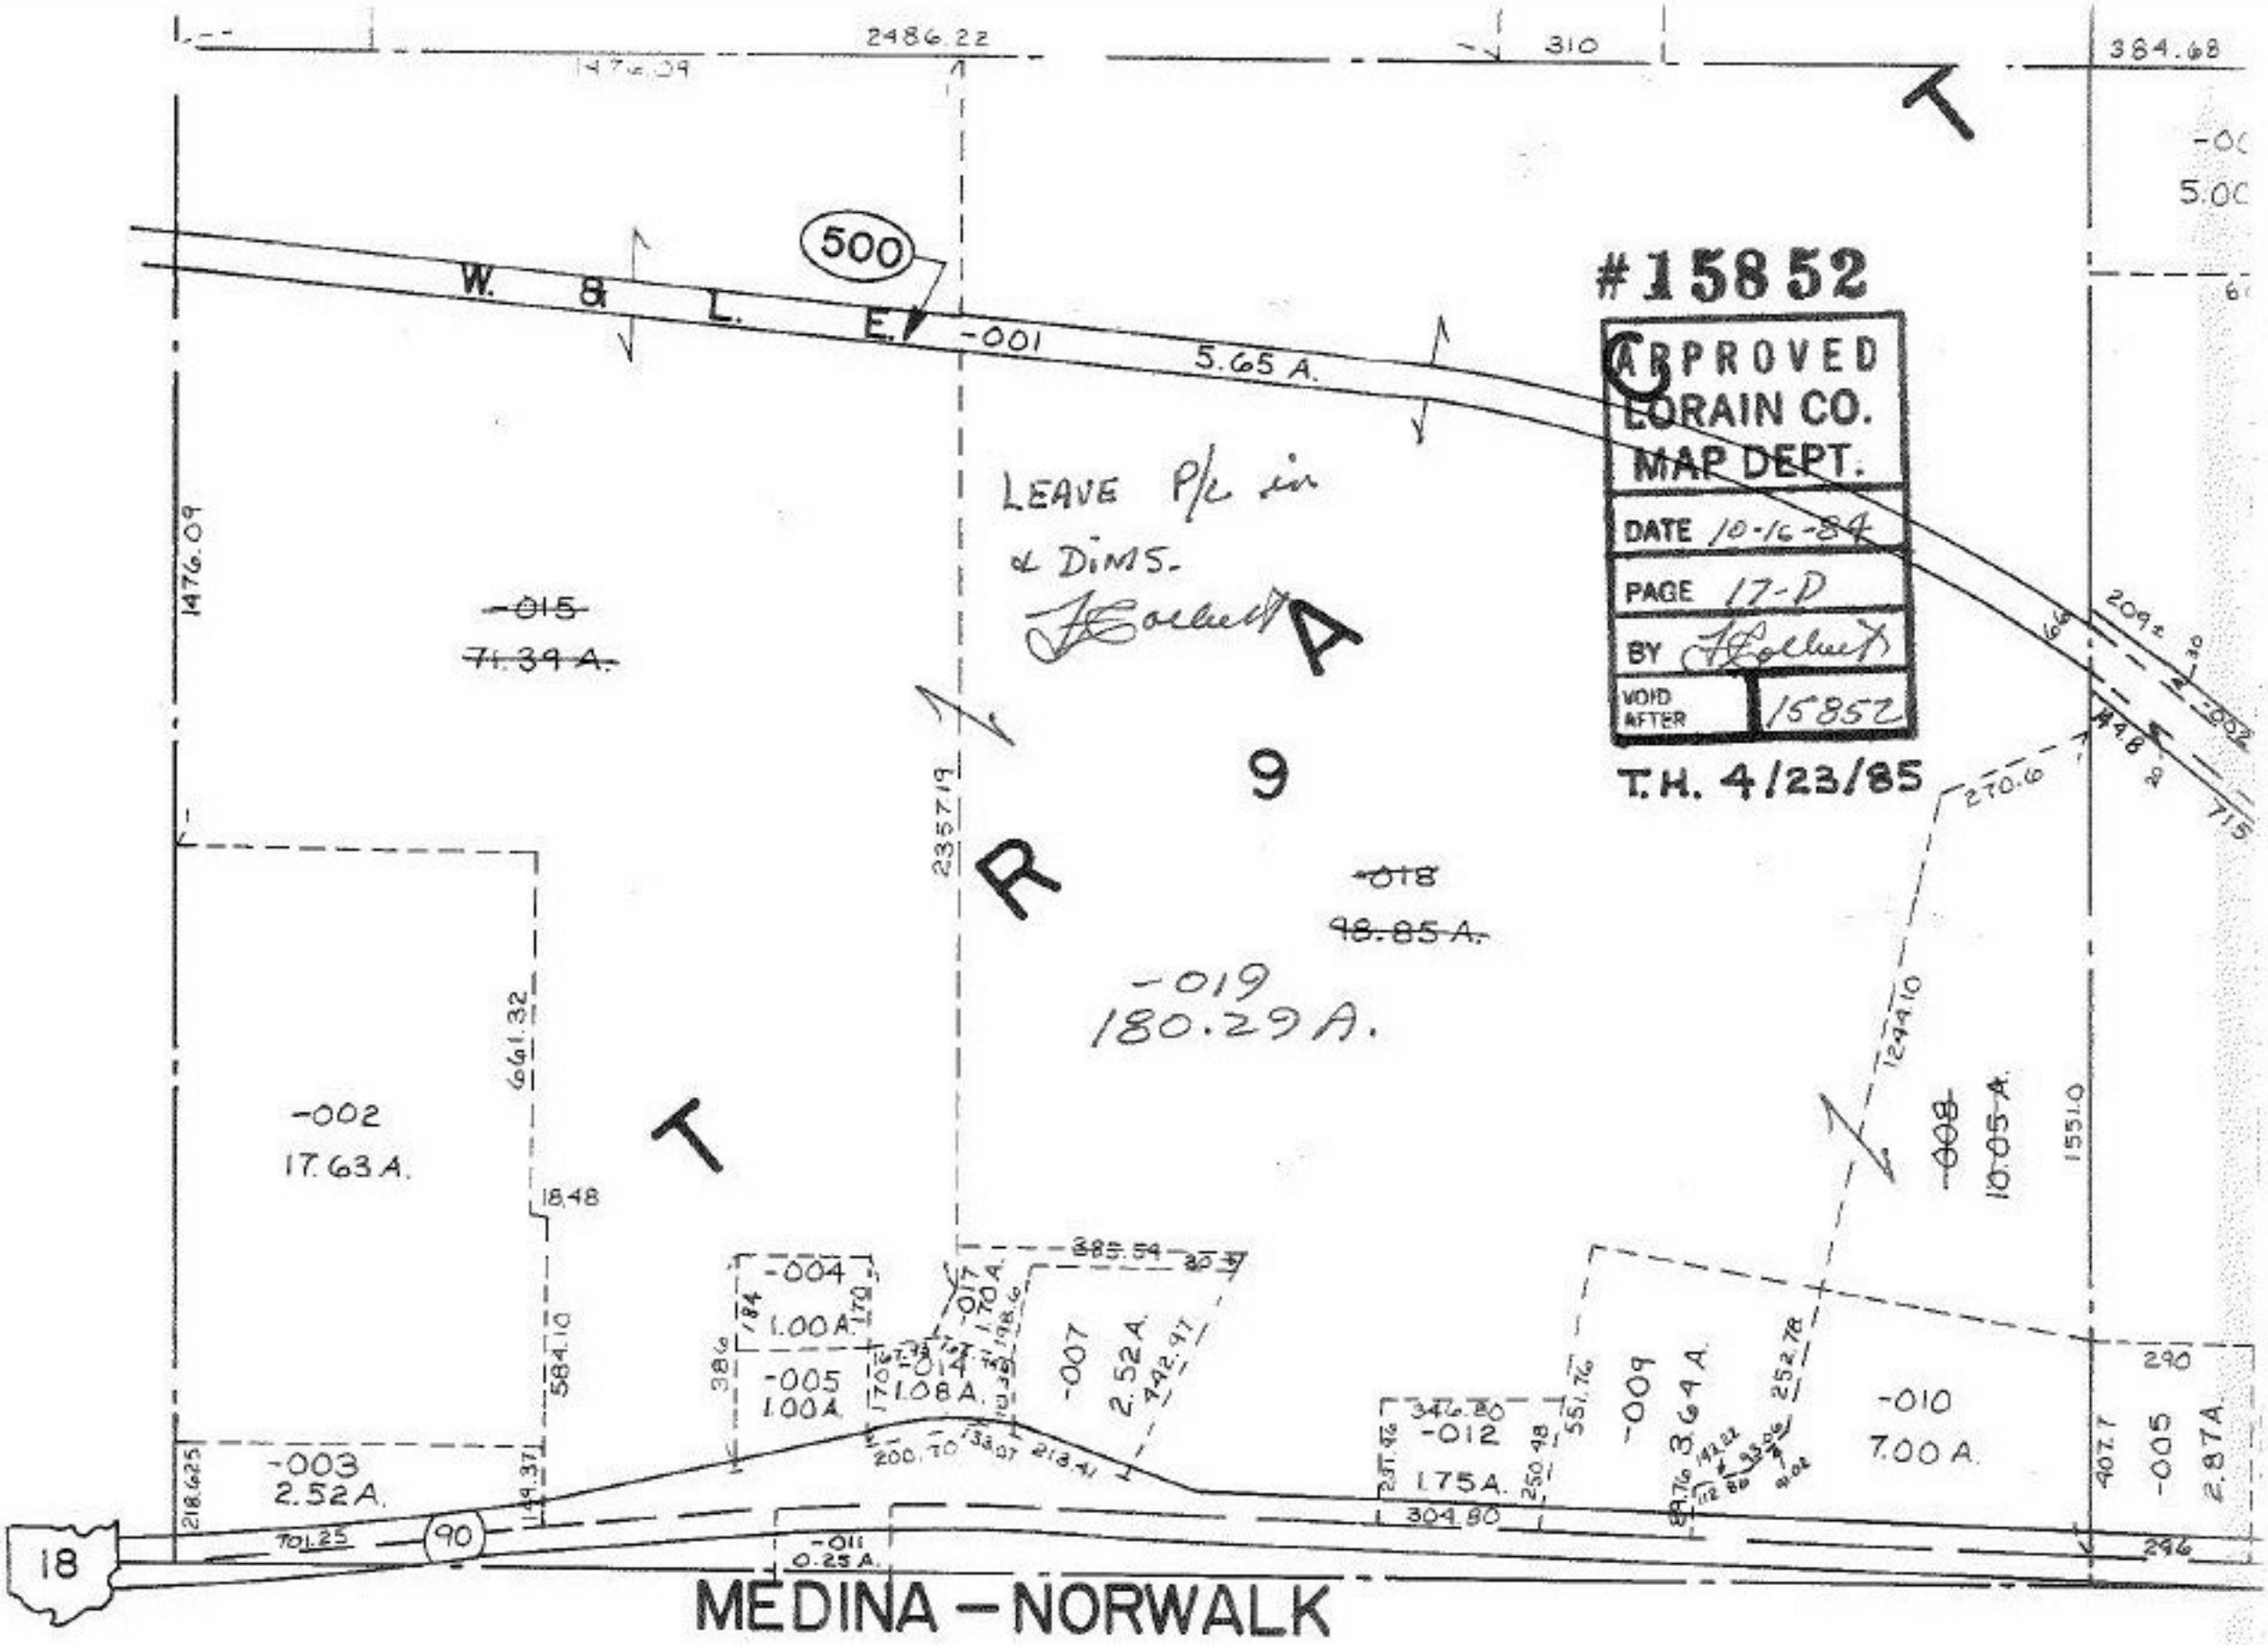

#15852
APPROVED
LORAIN CO.
MAP DEPT.
DATE 10-16-84
PAGE 17-D
BY
VOID AFTER 15852
T.H. 4/23/85
LEAVE P/L in
& DIMS.
W. & L. E.
500
-001
5.65 A.
-015
71.39 A.
-018
98.85 A.
-019
180.29 A.
-002
17.63 A.
-003
2.52 A.
-004
1.00 A.
-005
1.00 A.
-014
1.08 A.
-007
2.52 A.
-012
1.75 A.
-009
3.64 A.
-010
7.00 A.
-008
10.05 A.
-005
2.87 A.
-011
0.25 A.
18
90
MEDINA – NORWALK