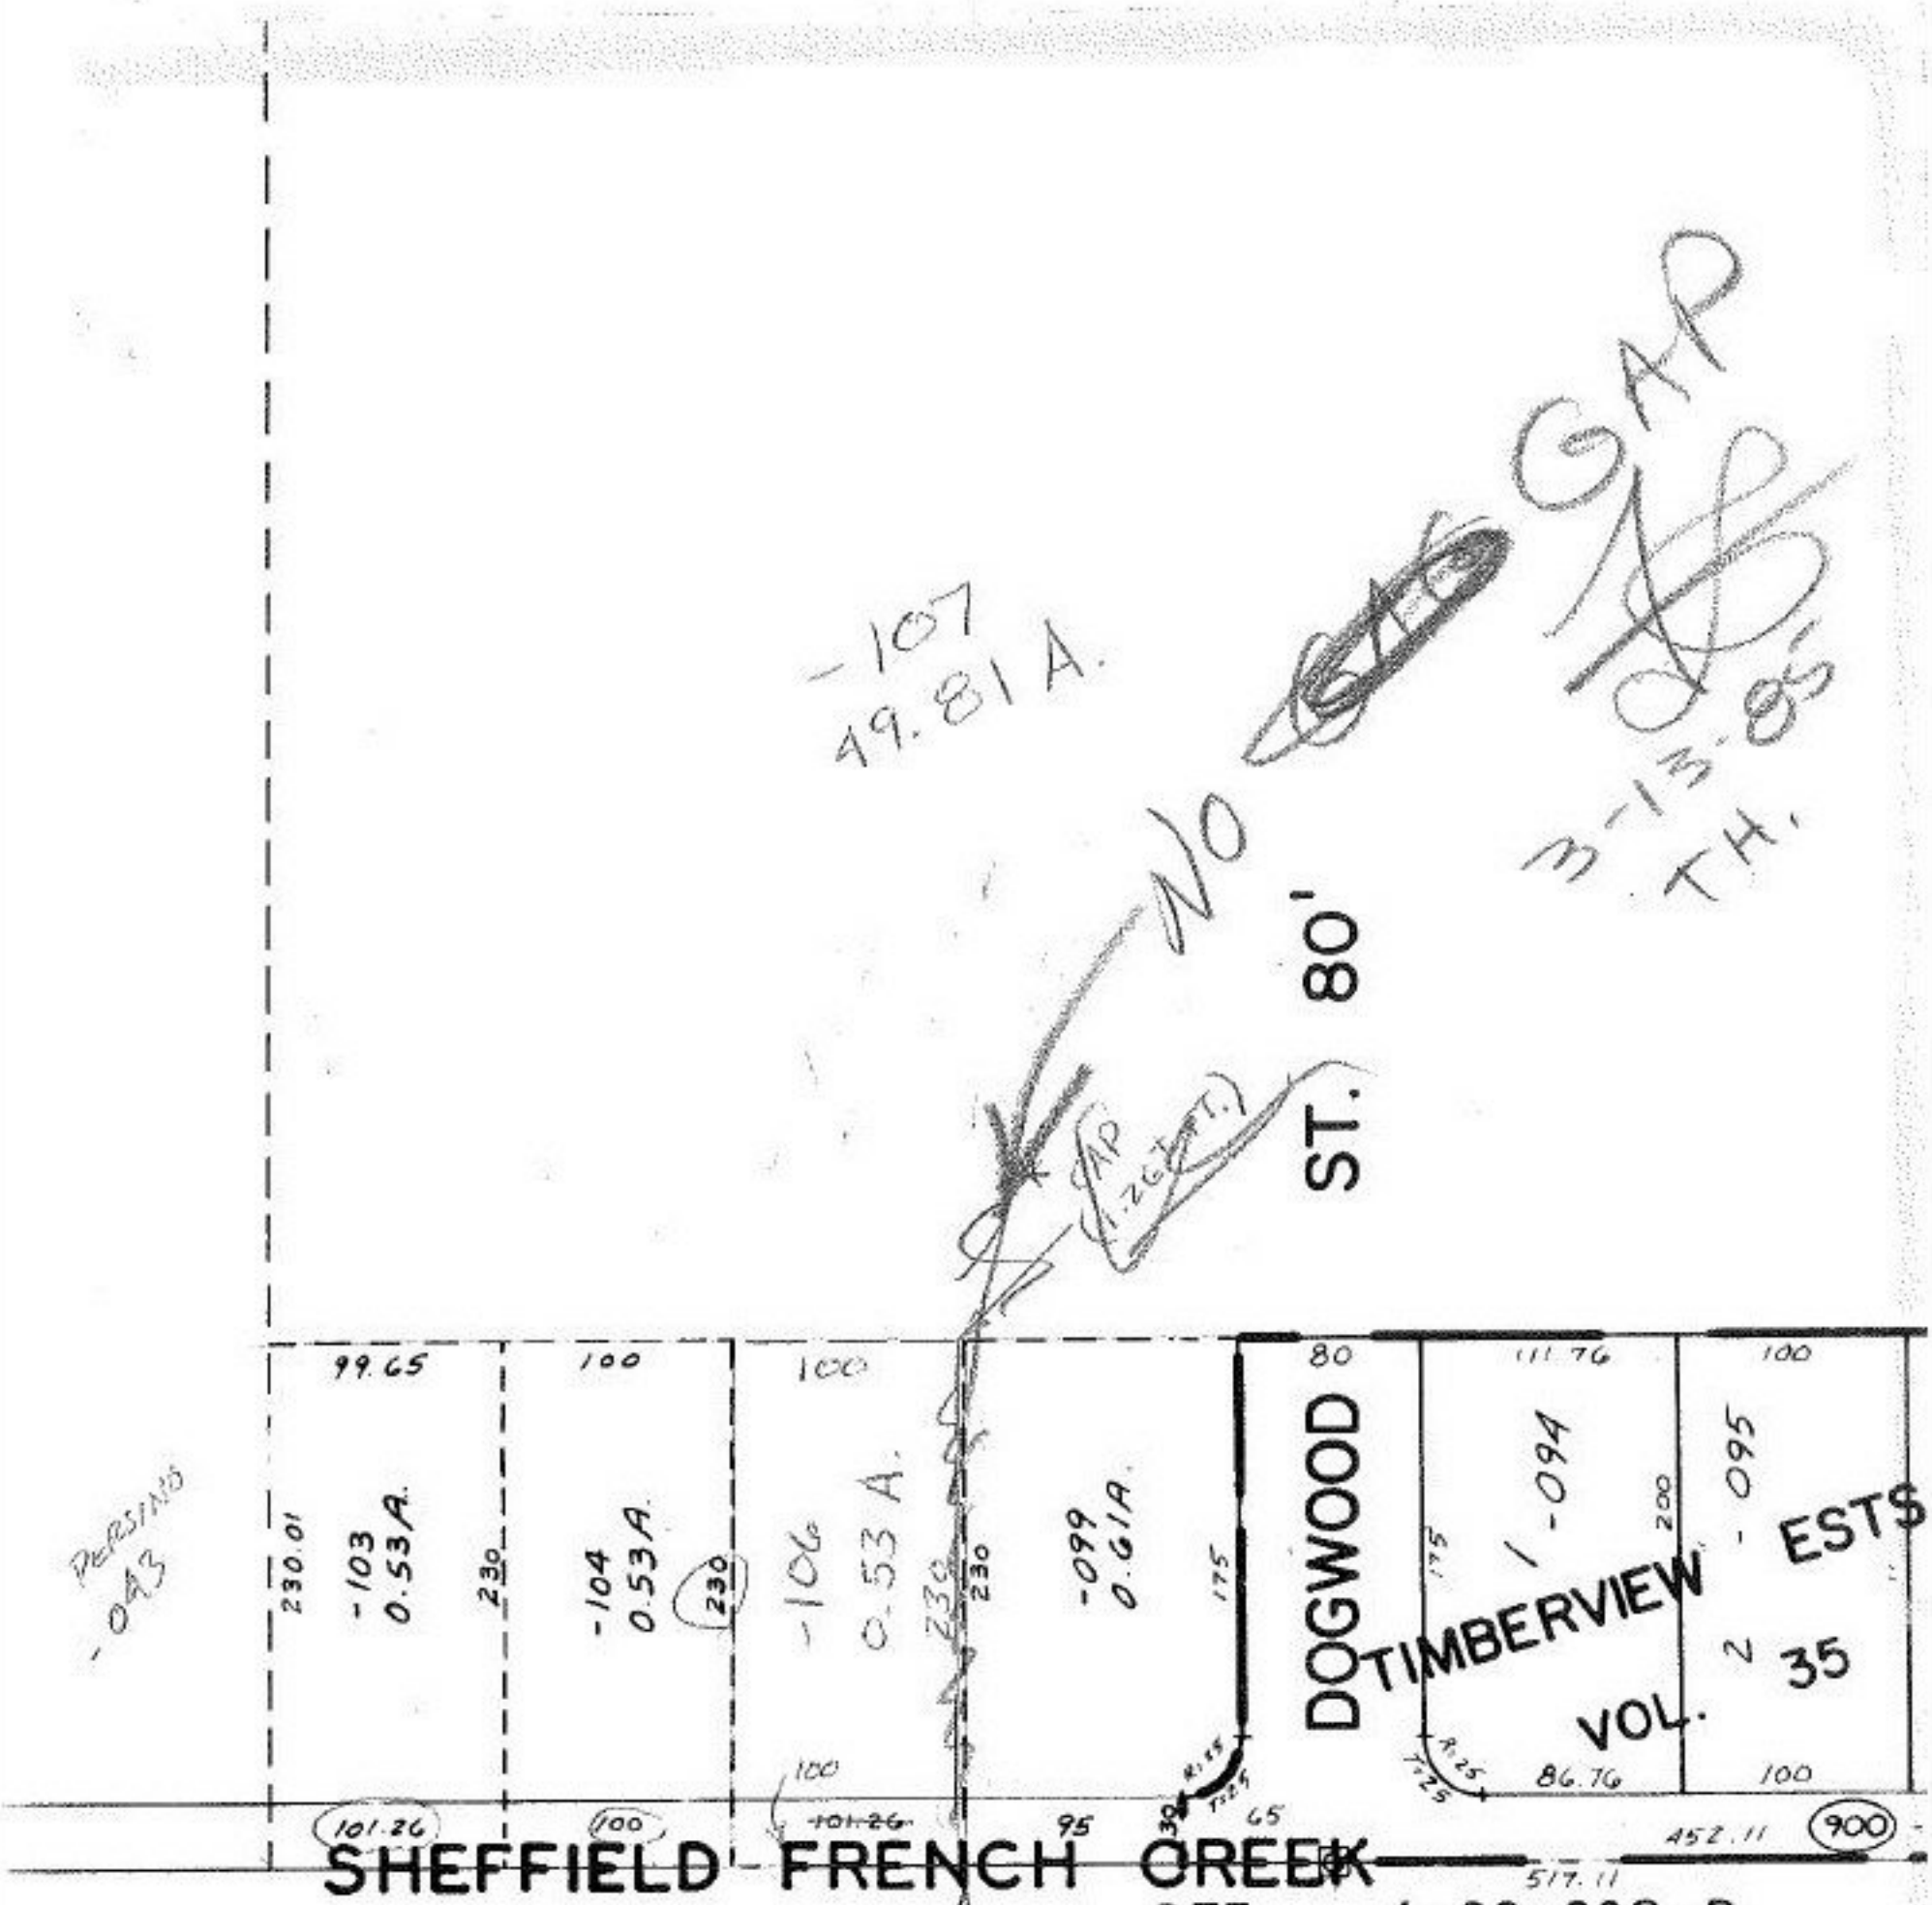

#15859

APPROVED
LORAIN CO.
MAP DEPT.

DATE 10.22.84
PAGE 4.00.003.F
BY T. McNair
VOID.

CLOSURE
1:00

AVON CITY

T.H. 3/13/85