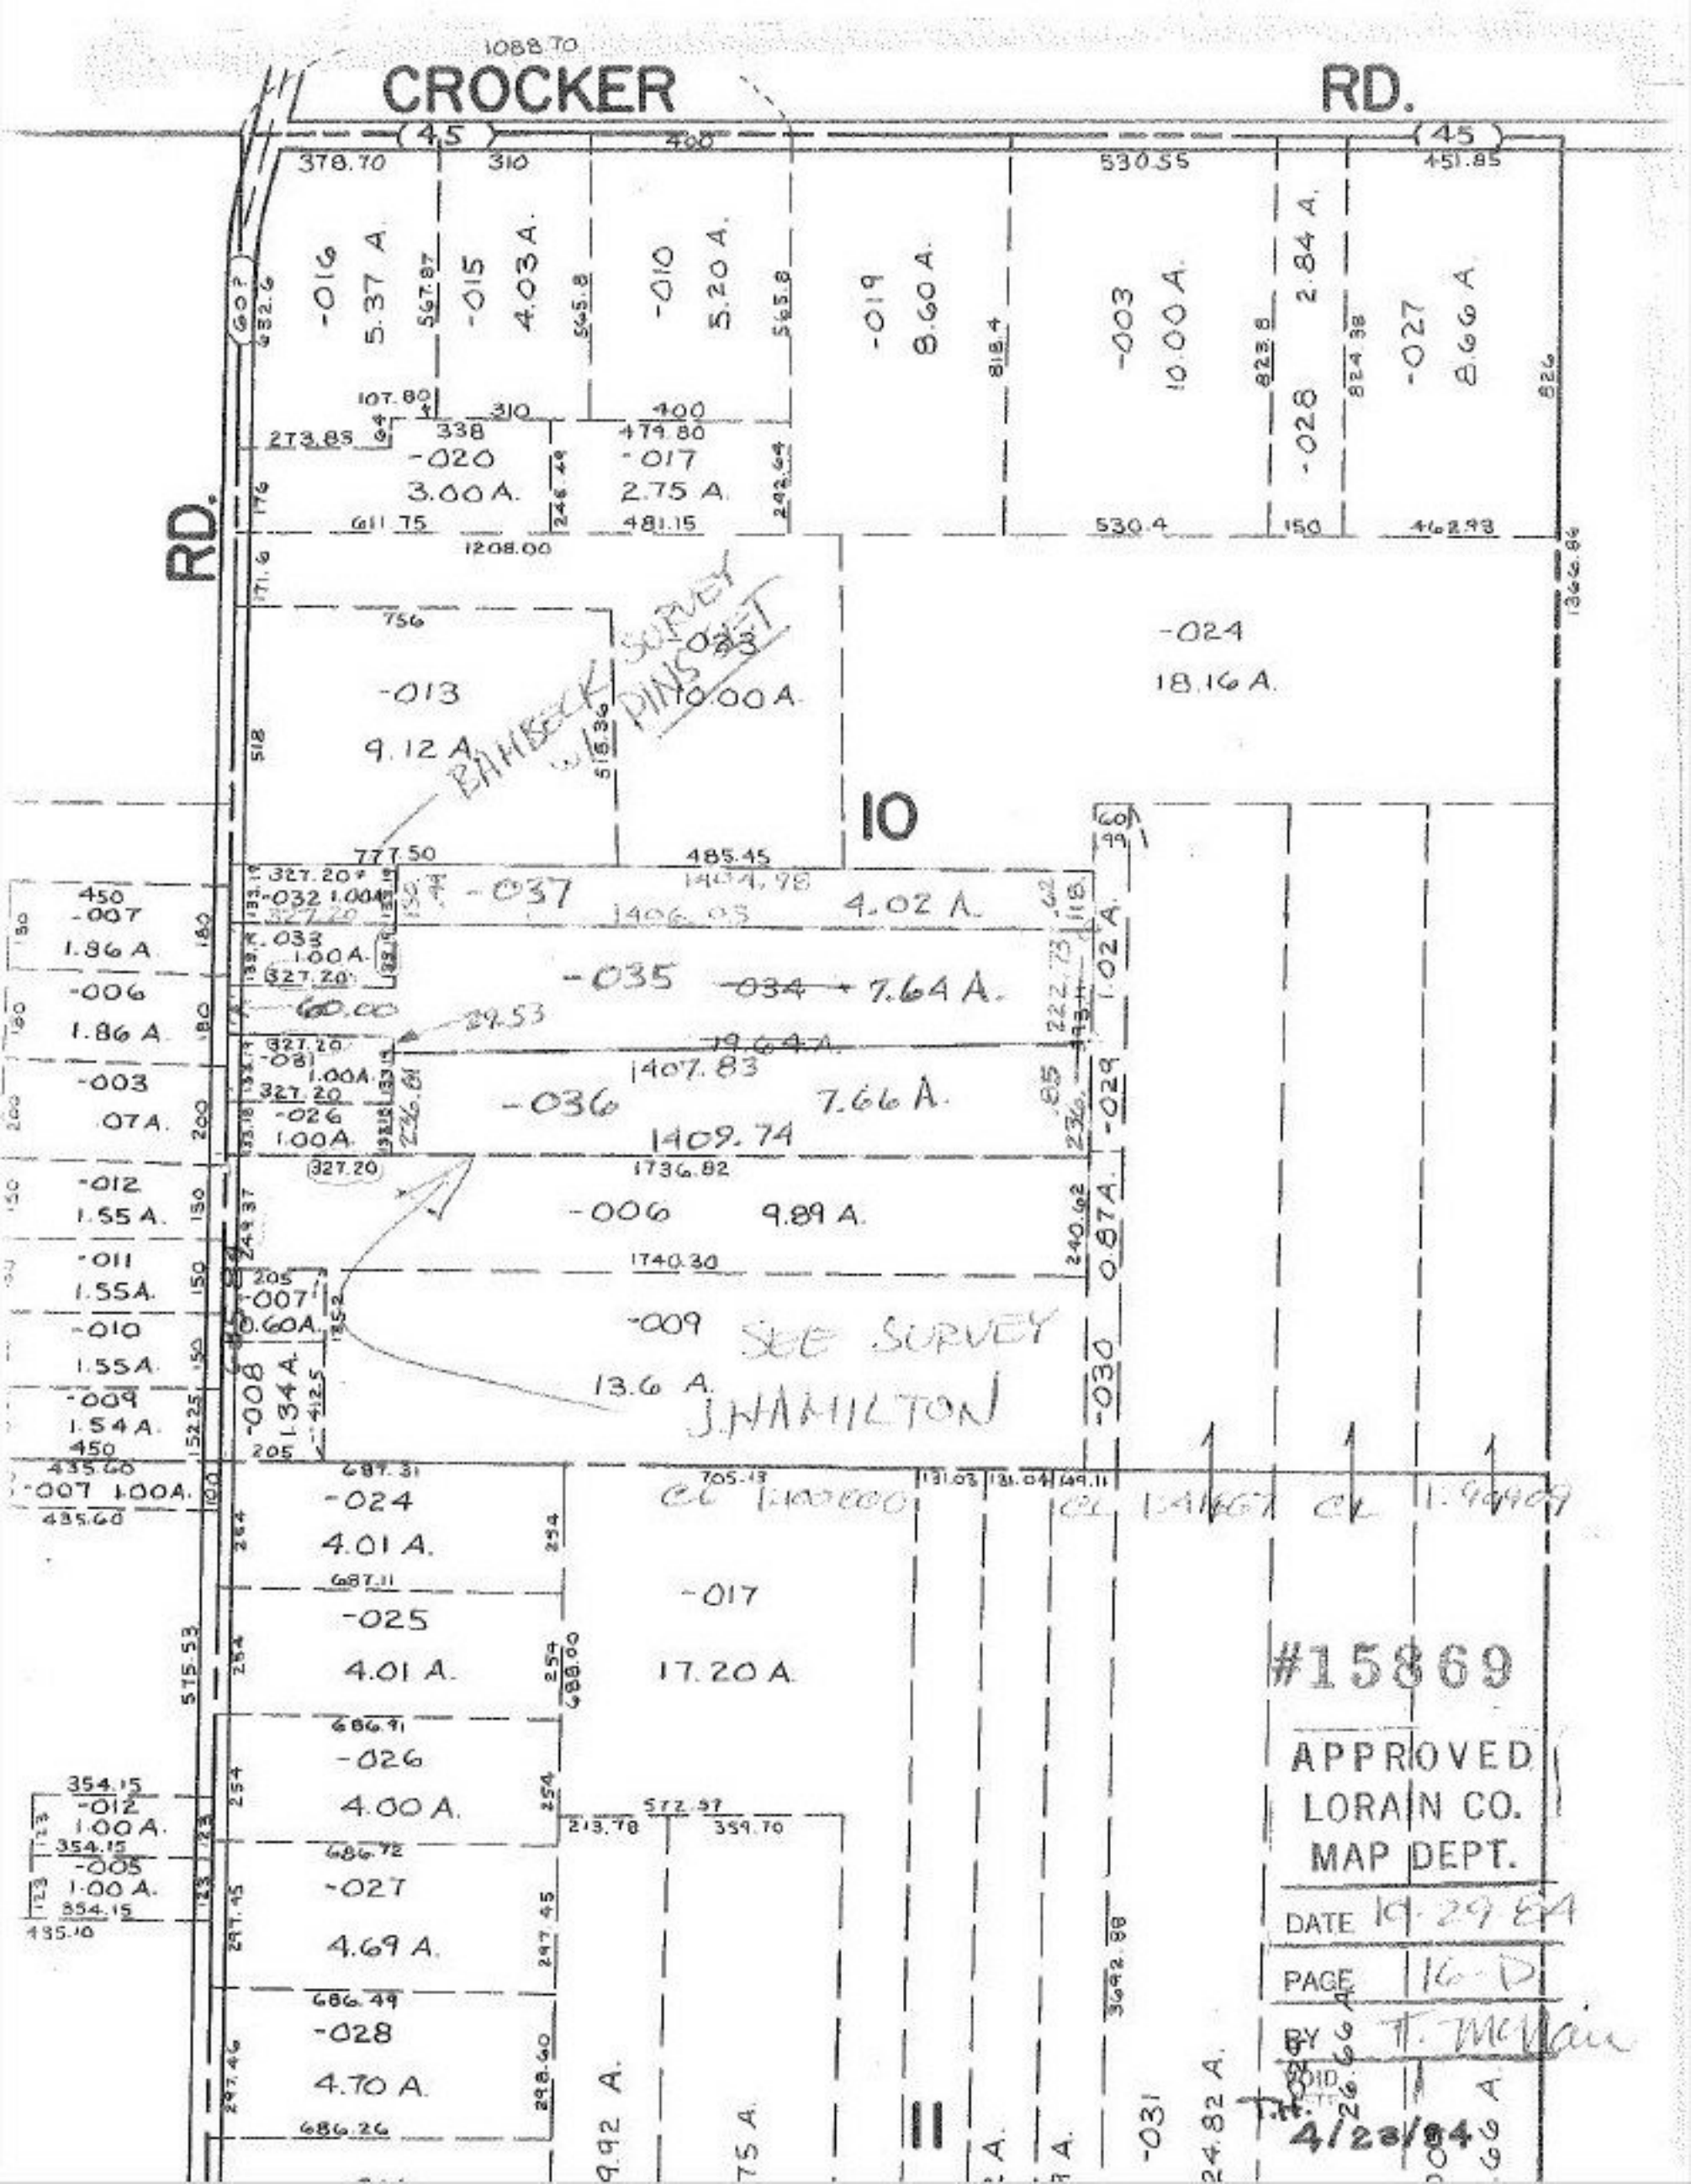
CROCKER
RD.
RD.
-016
5.37 A.
-015
4.03 A.
-010
5.20 A.
-019
8.60 A.
-003
10.00 A.
-028
2.84 A.
-027
8.66 A.
-020
3.00 A.
-017
2.75 A.
-013
9.12 A.
-023
10.00 A.
-024
18.16 A.
BAMBECK SURVEY W/ PINS SET
10
-037
4.02 A.
-035
7.64 A.
-036
7.66 A.
-006
9.89 A.
-009
13.6 A.
SEE SURVEY
J. HAMILTON
-024
4.01 A.
-025
4.01 A.
-017
17.20 A.
-026
4.00 A.
-027
4.69 A.
-028
4.70 A.
-007
1.86 A.
-006
1.86 A.
-003
.07 A.
-012
1.55 A.
-011
1.55 A.
-010
1.55 A.
-009
1.54 A.
-007
1.00 A.
-012
1.00 A.
-005
1.00 A.
-031
24.82 A.
-030
0.87 A.
-029
1.02 A.
#15869
APPROVED
LORAIN CO.
MAP DEPT.
DATE 10-29-84
PAGE 16-D
BY T. McNair
VOID
4/23/84