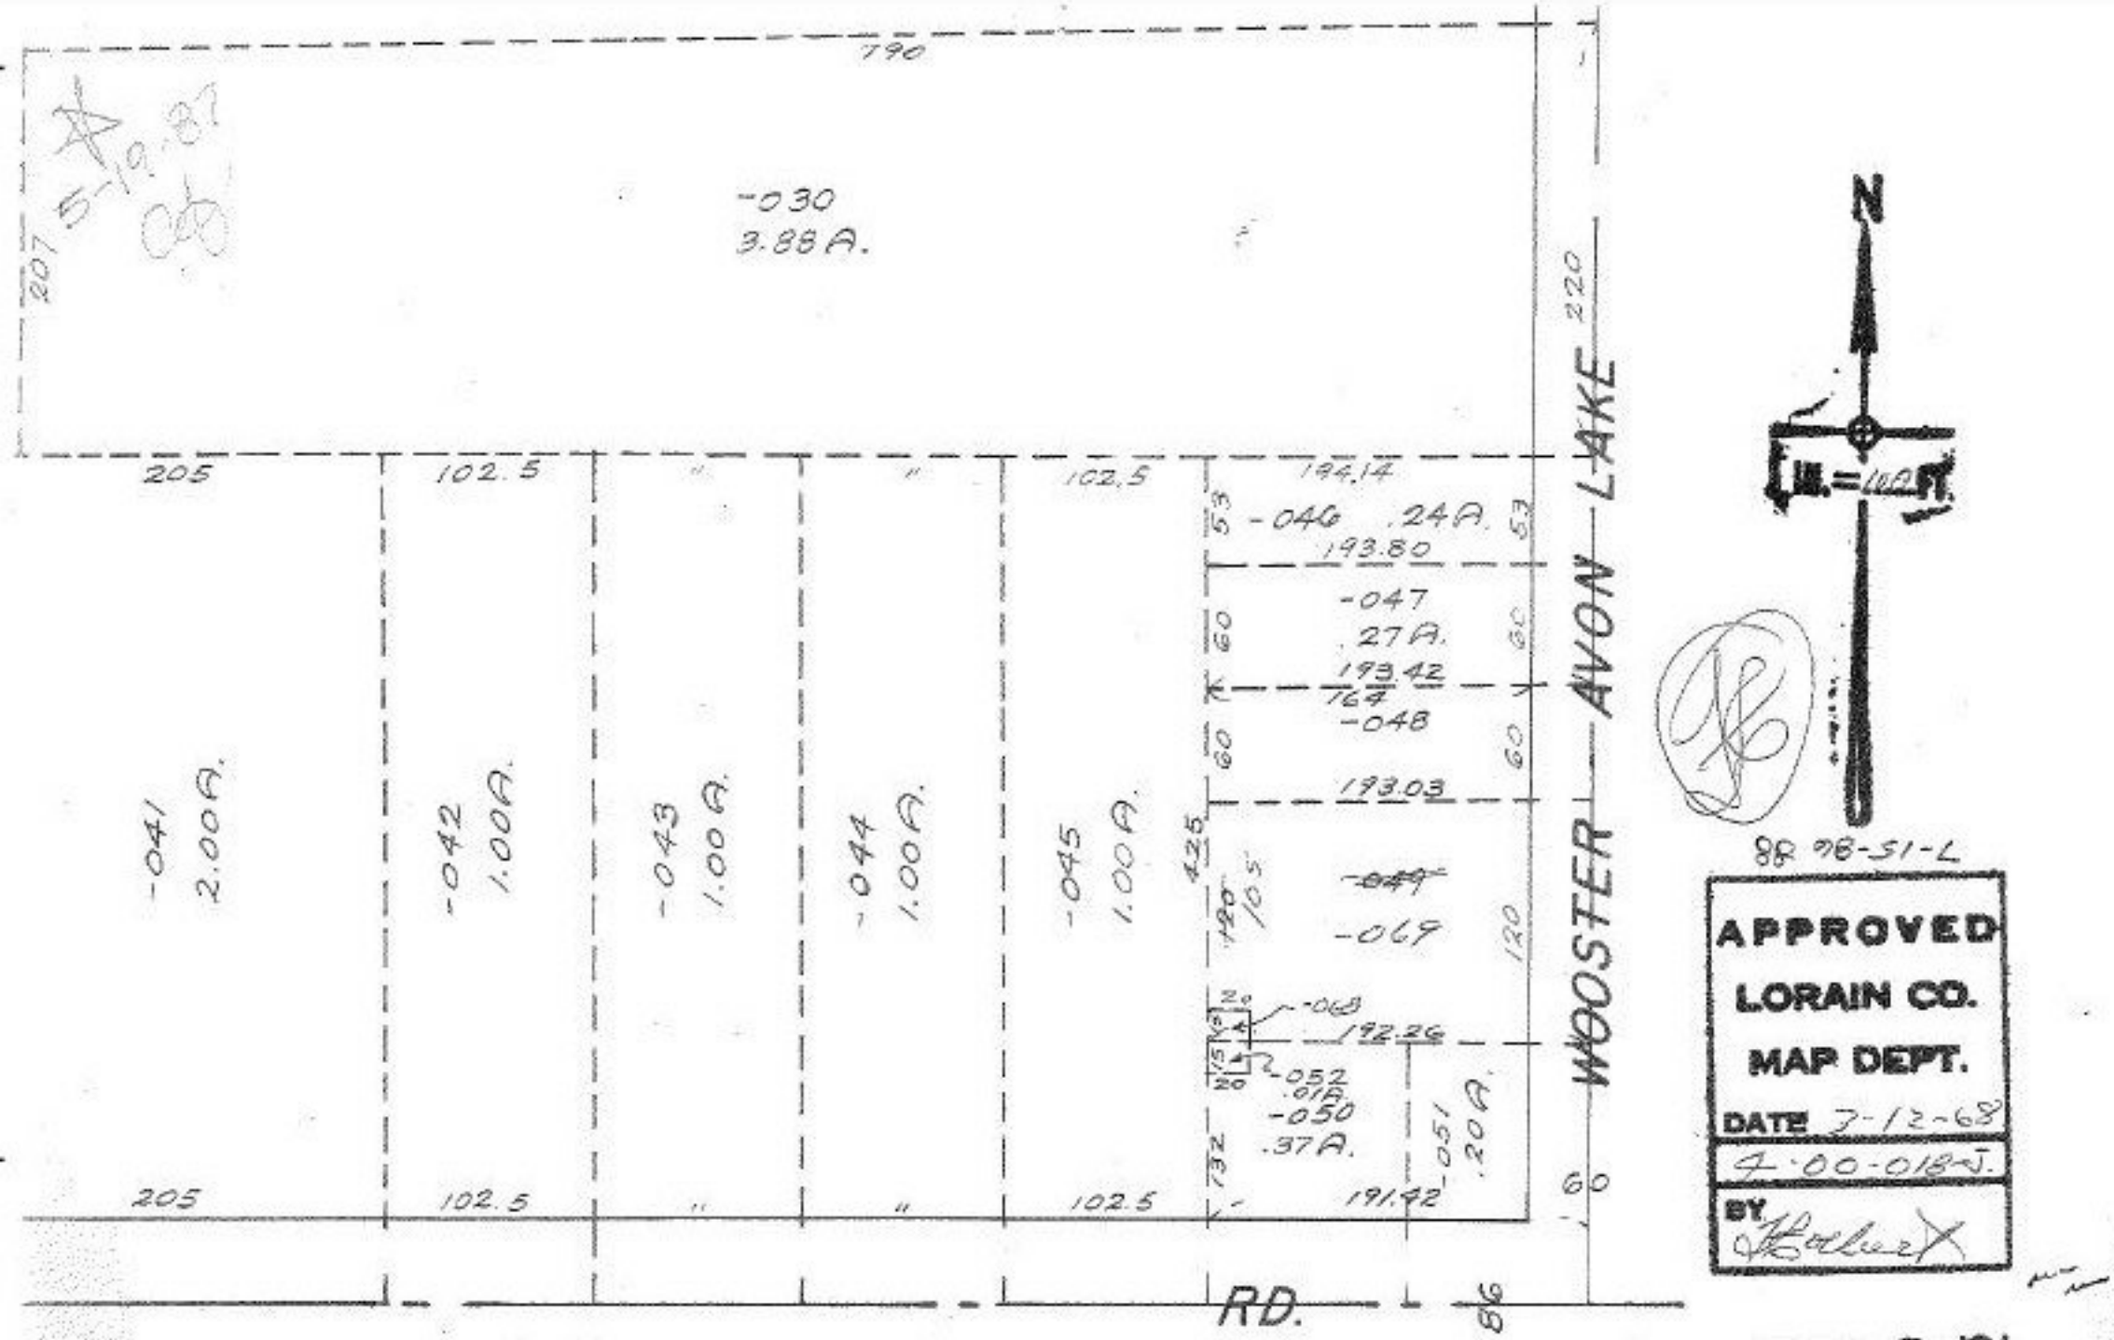

SEE 4-00-017-B

1587

DONE 5-9-68
FRANK COLBERT.
4-00-018-J

VILLAGE

E 1/2 W 1/2 S ty 1/3 SEC. 18