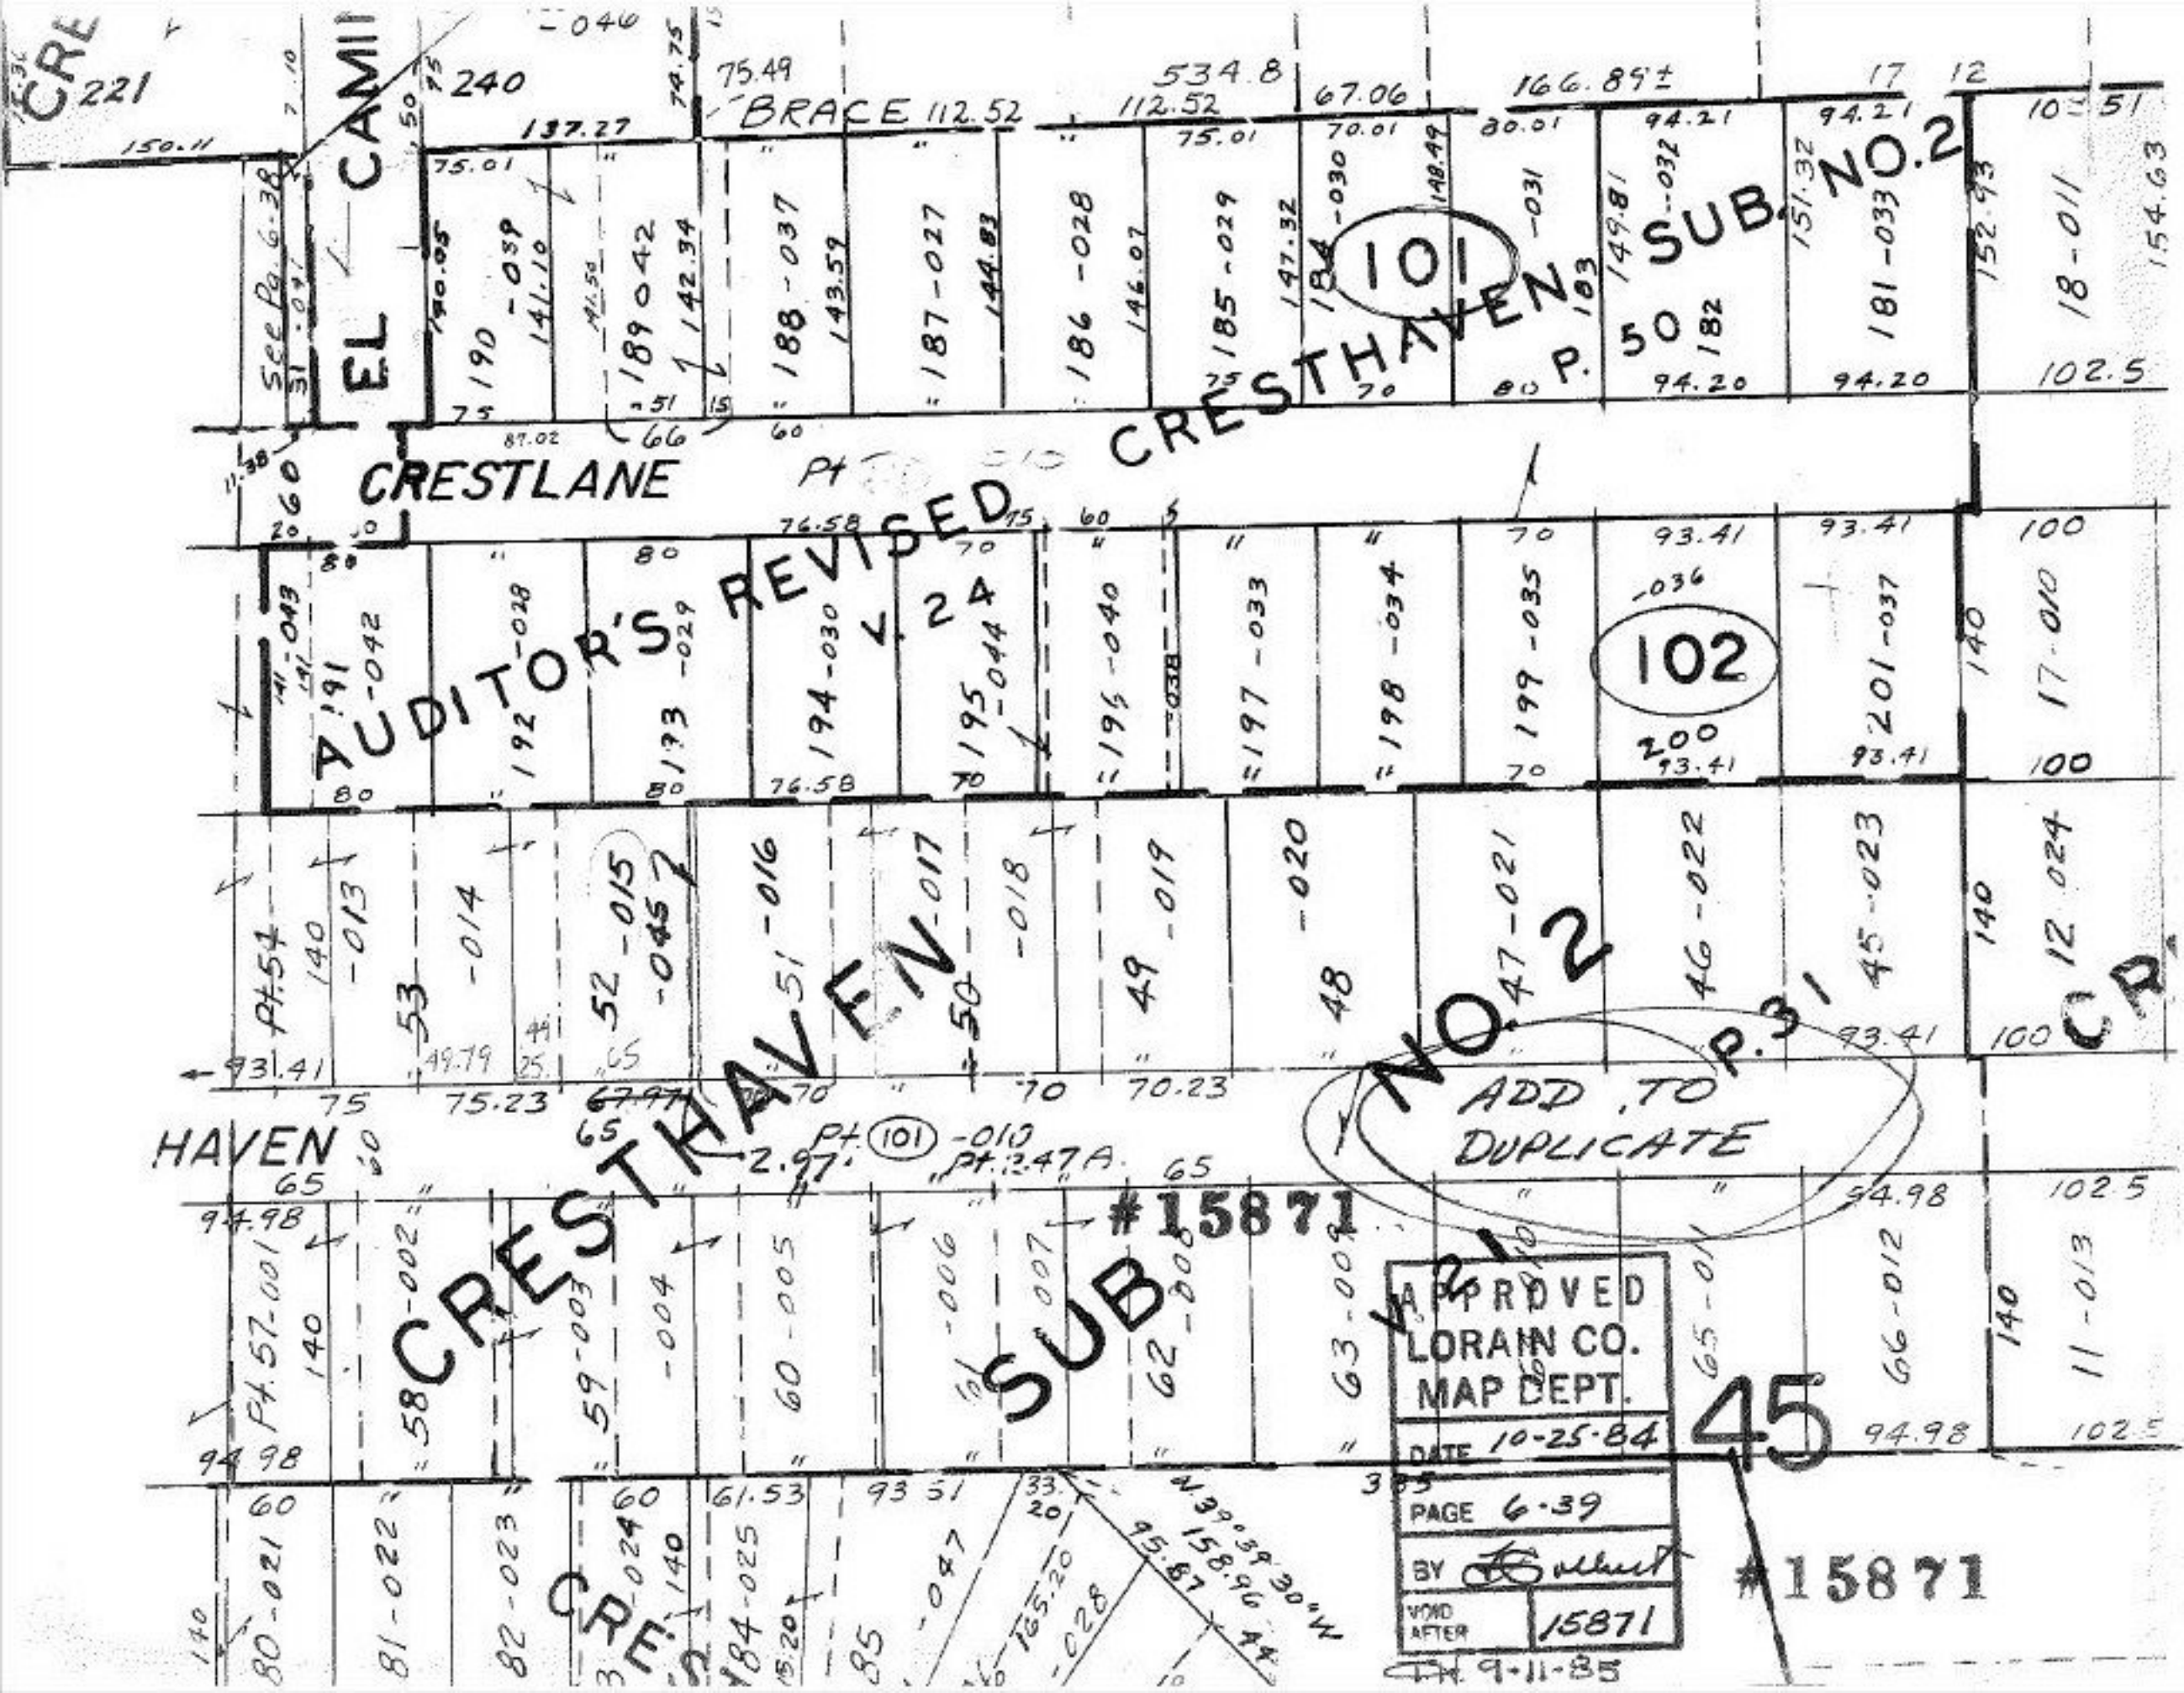

CRESTHAVEN SUB. NO.2
P. 50
101
AUDITOR'S REVISED CRESTHAVEN
V. 24
102
CRESTLANE
CRESTHAVEN SUB NO. 2
P. 31
ADD TO DUPLICATE
HAVEN
#15871
V. 21
45
APPROVED
LORAIN CO.
MAP DEPT.
DATE 10-25-84
PAGE 6-39
BY
VOID AFTER 15871
#15871
9-11-85