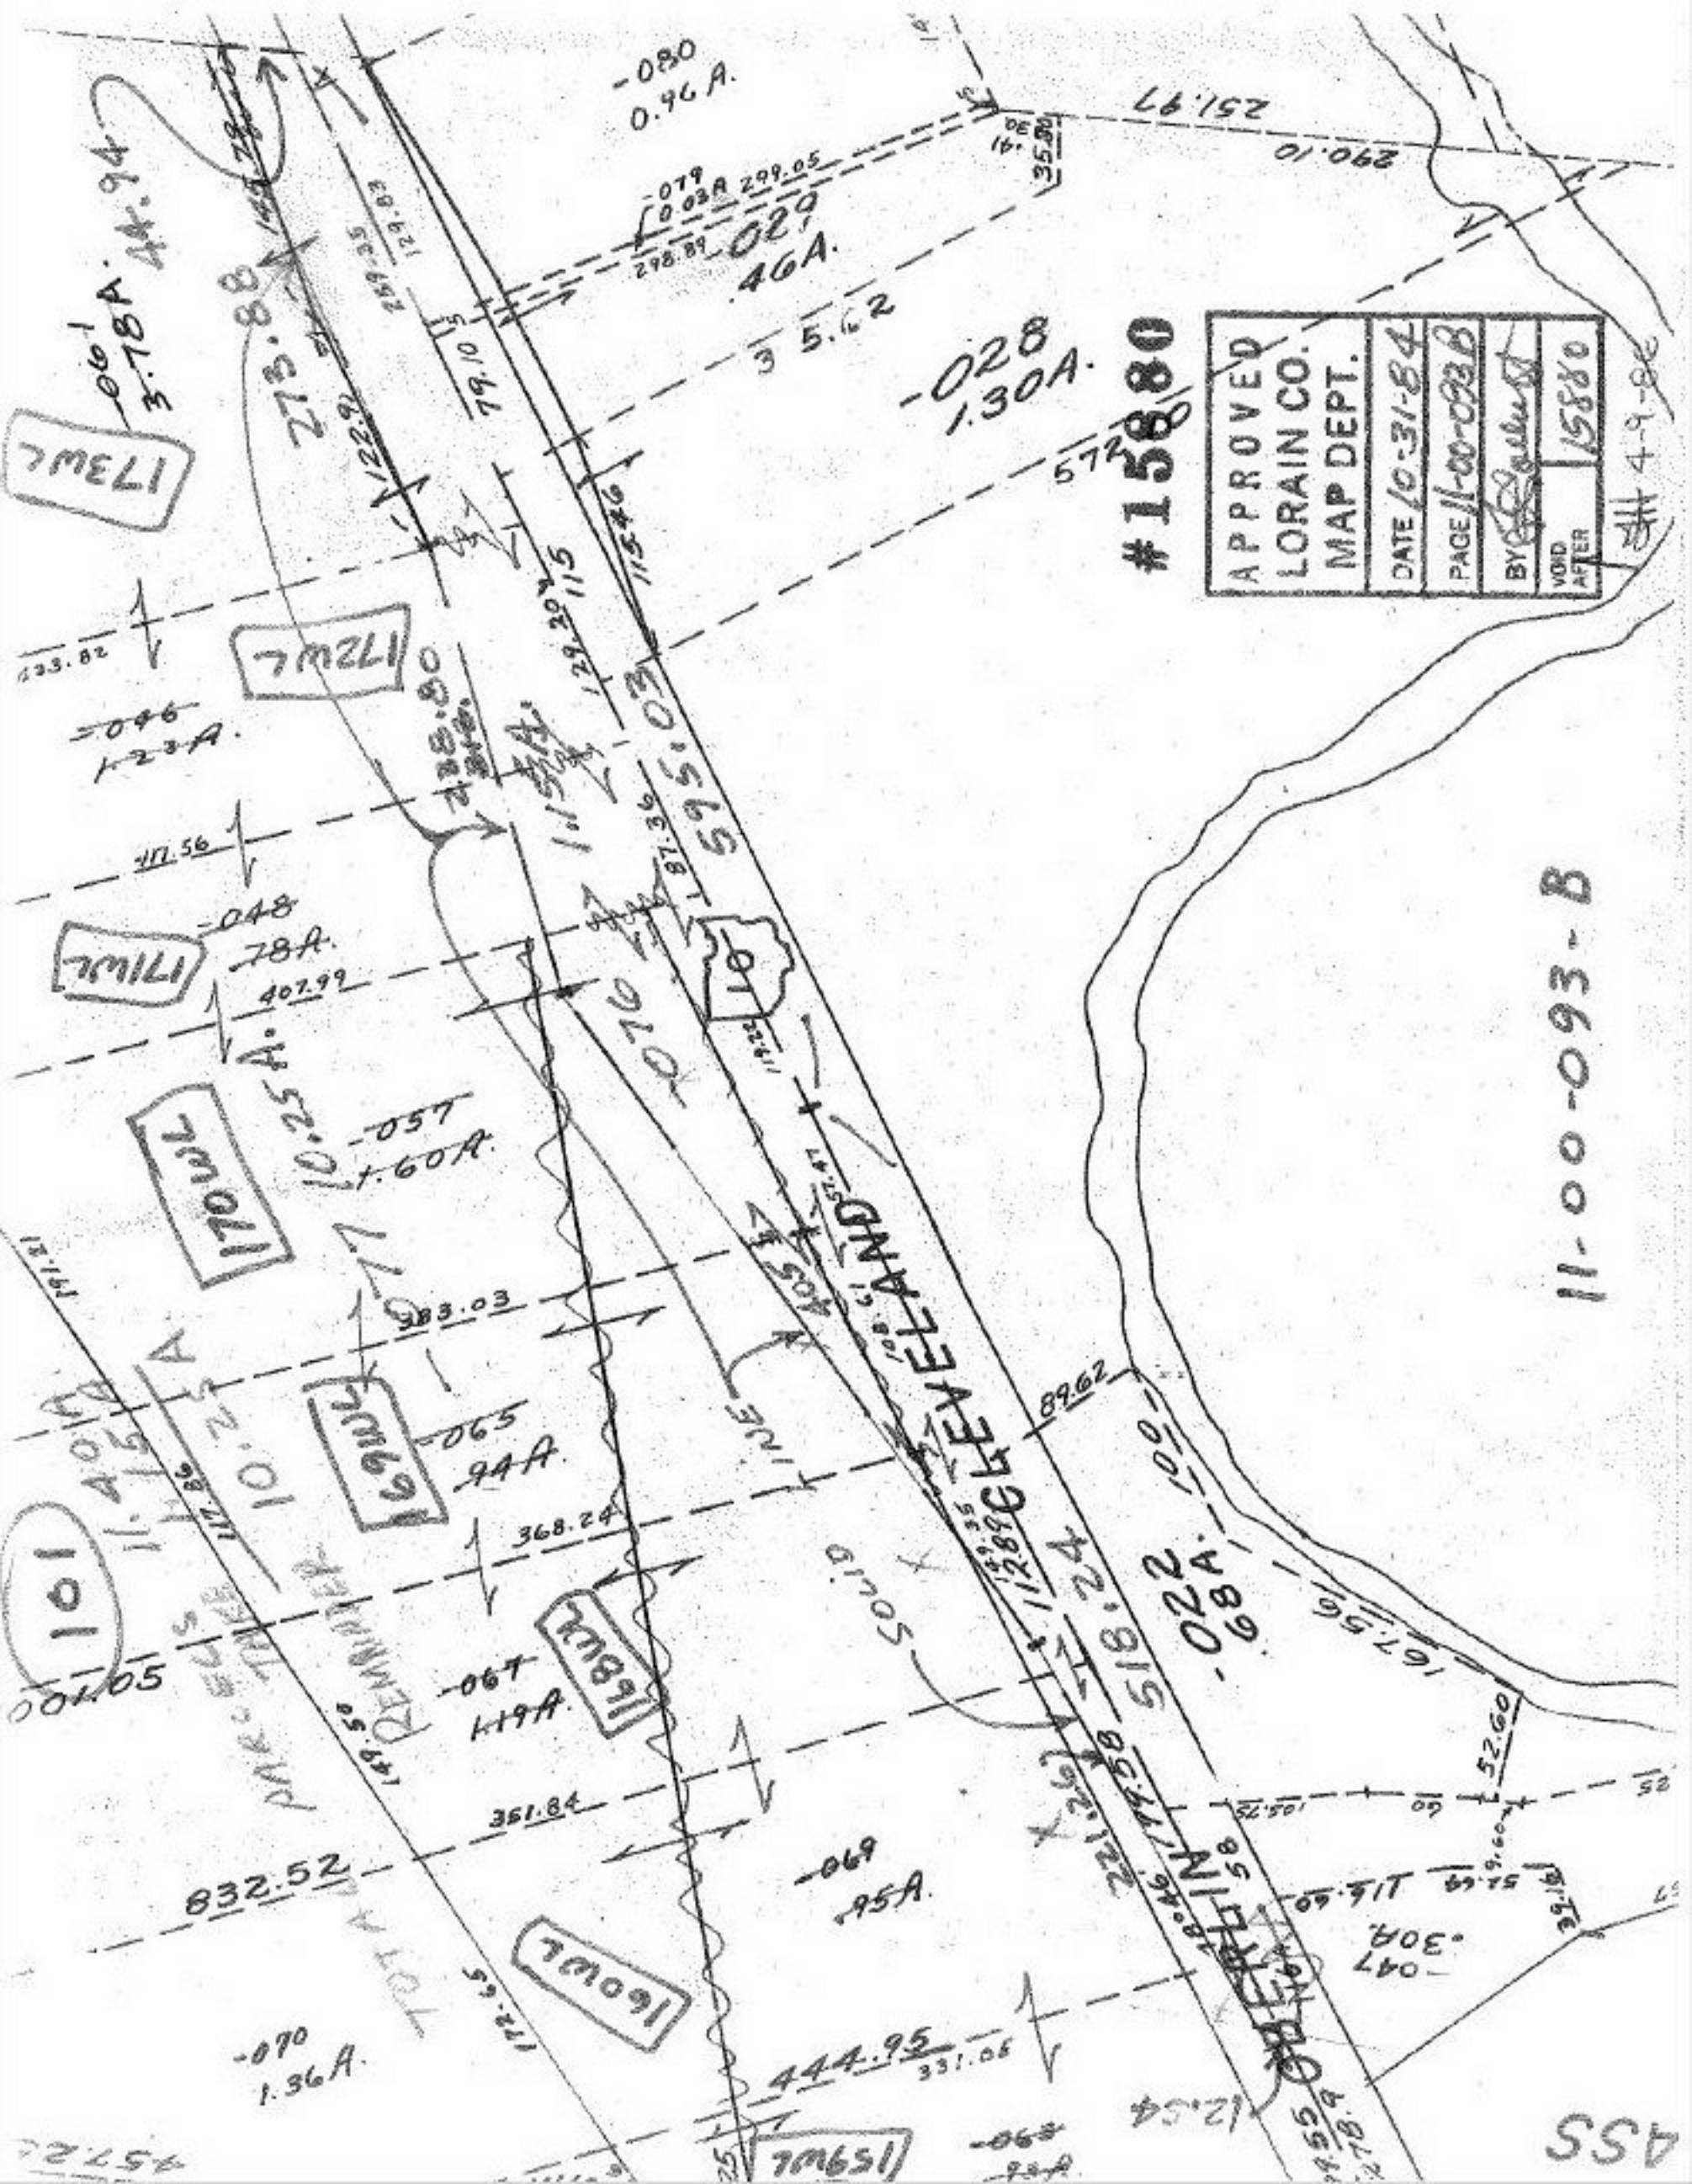

APPROVED
LORAIN CO.
MAP DEPT.
DATE 10-31-84
PAGE 11-00-093B
BY
VOID AFTER 15880
#15880
11-00-093-B
CLEVELAND
OBERLIN
-080
0.96 A.
-029
.46A.
-028
1.30A.
-022
.68A.
-046
1.23A.
-048
.78A.
-057
1.60A.
-065
.94A.
-067
1.19A.
-069
.95A.
-070
1.36A.
-047
.30A.
273.88
595.03
518.24
101
170WL
169WL
168WL
160WL
159WL