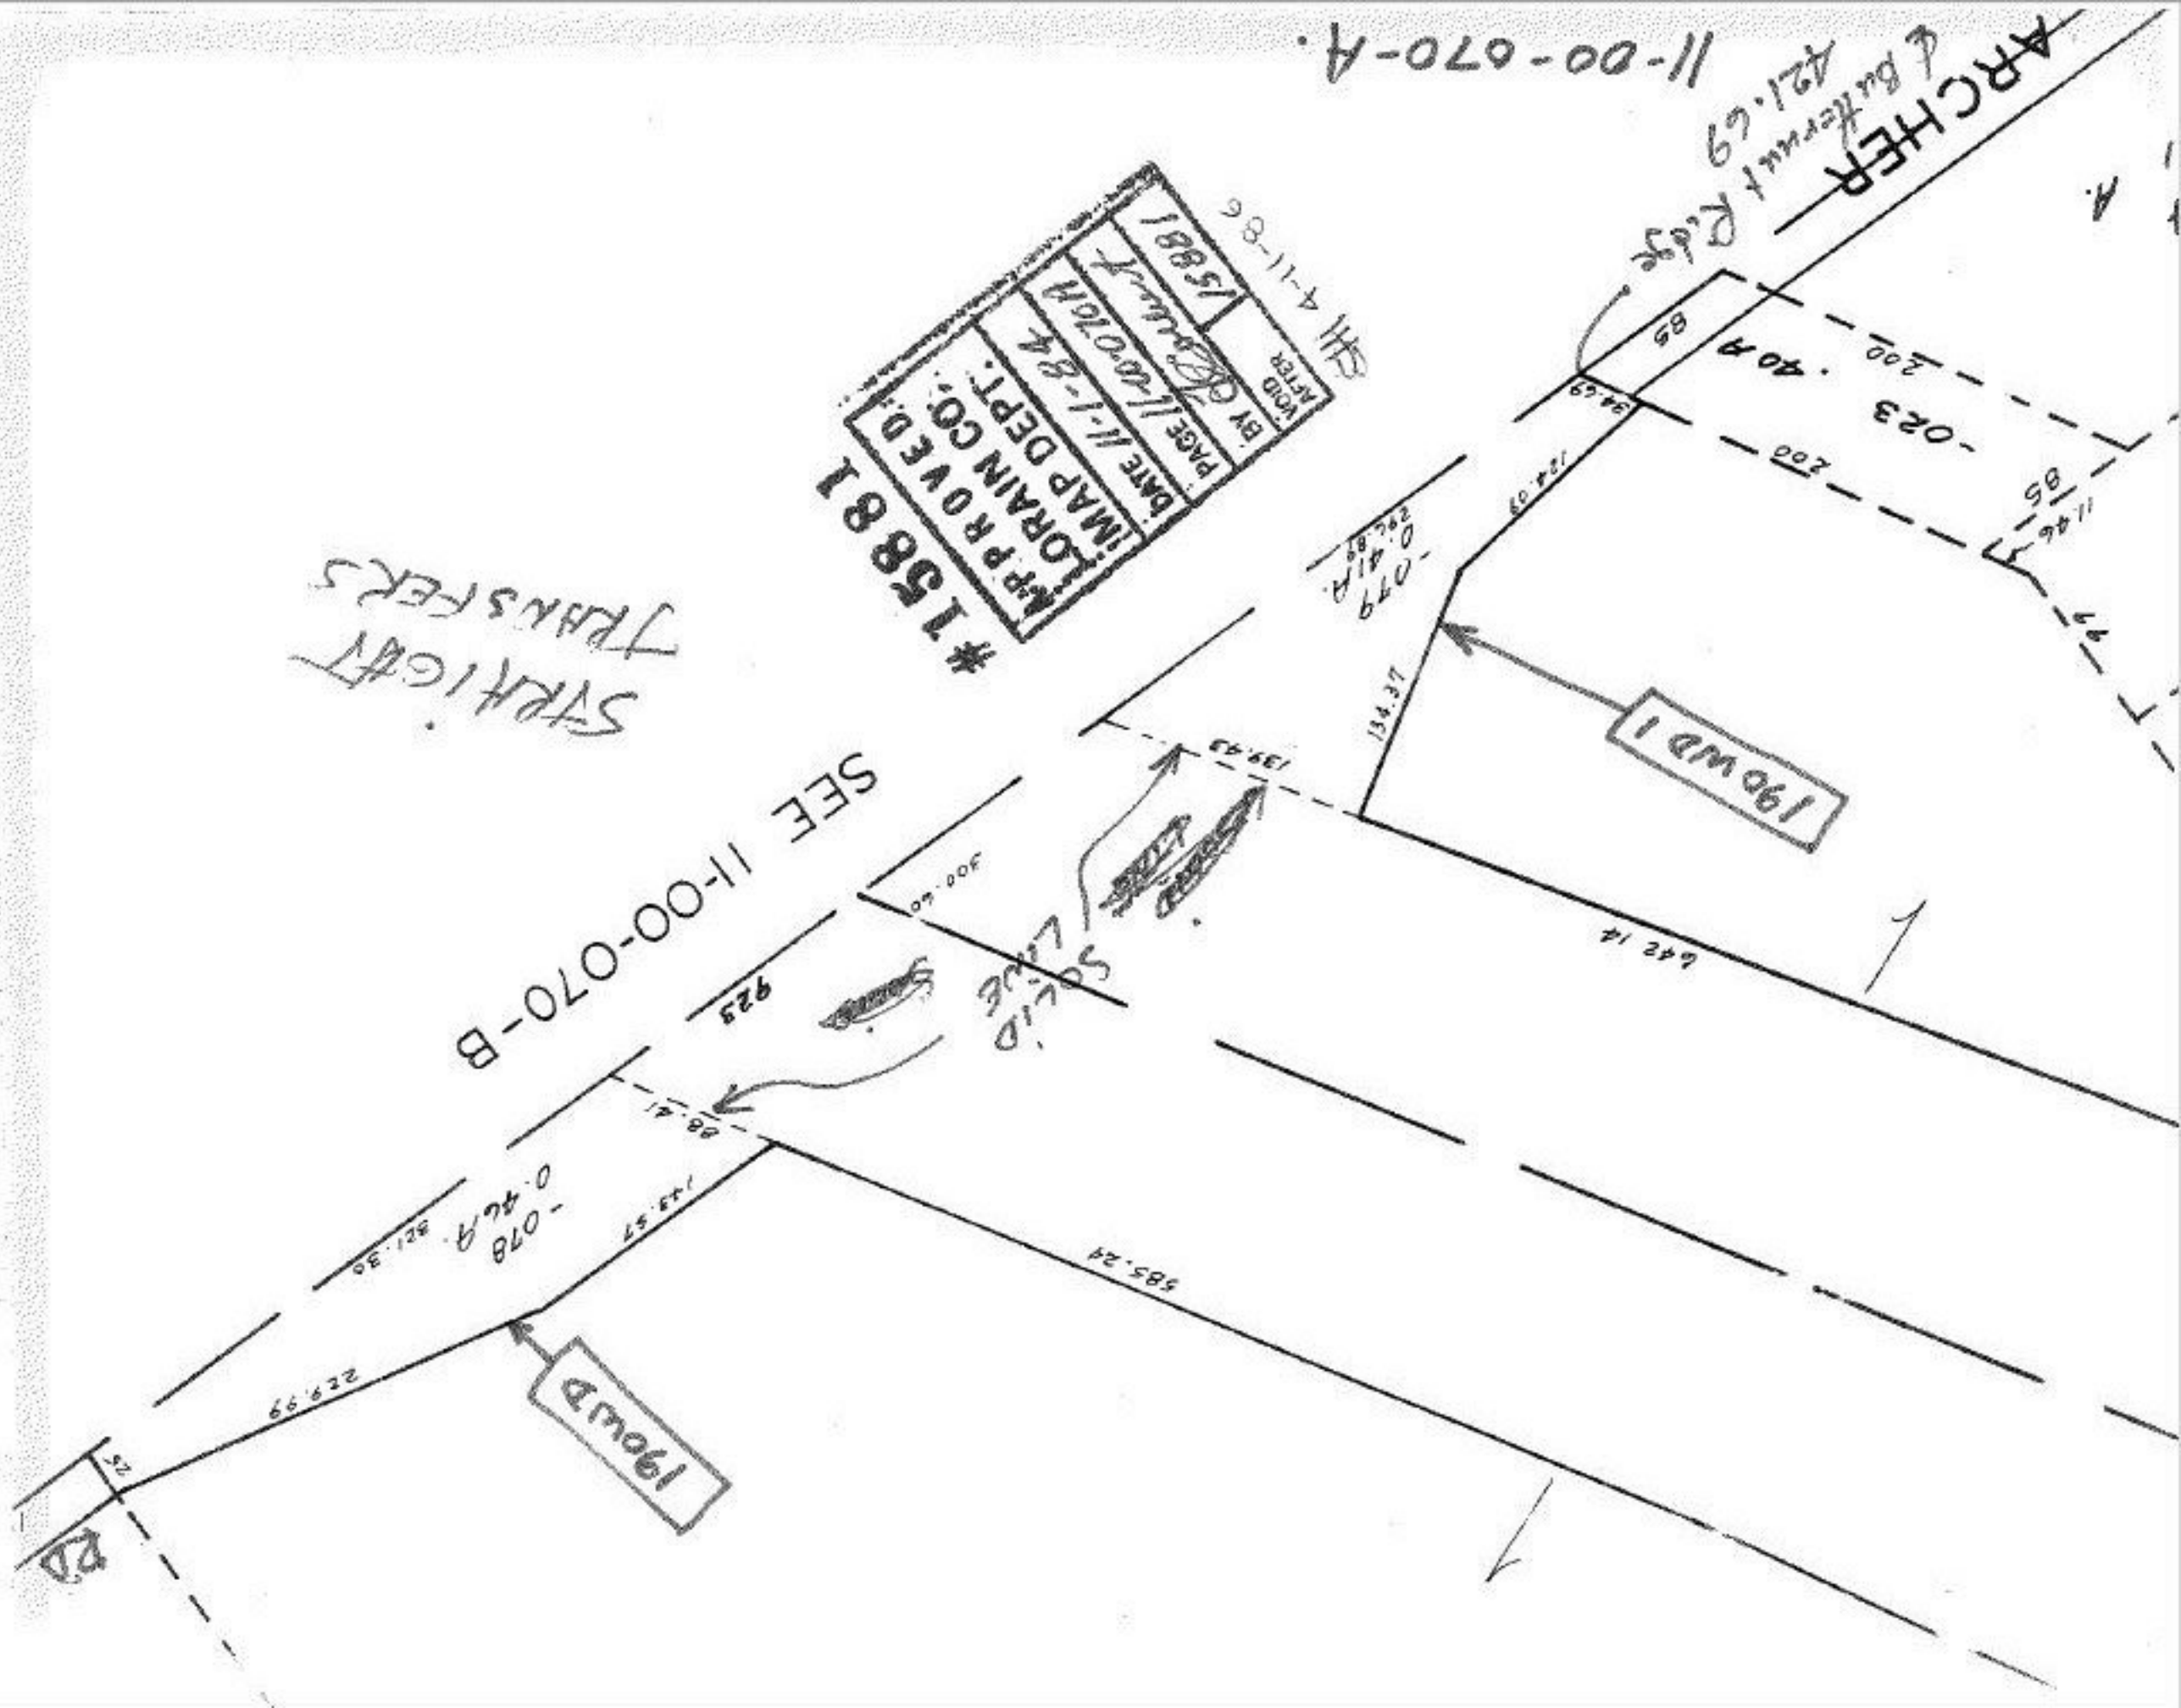

11-00-070-A.
ARCHER
℄ Butternut Ridge
421.69
#15881
APPROVED
LORAIN CO.
MAP DEPT.
DATE 11-1-84
PAGE 11-00-070A
BY
VOID AFTER 15881
4-11-86
STRAIGHT TRANSFERS
SEE 11-00-070-B
190WD1
190WD
SOLID LINE
-023
-079
0.41A
-078
0.46A
134.37
139.43
642.14
585.24
143.57
229.99
321.30
88.41
300.40
923