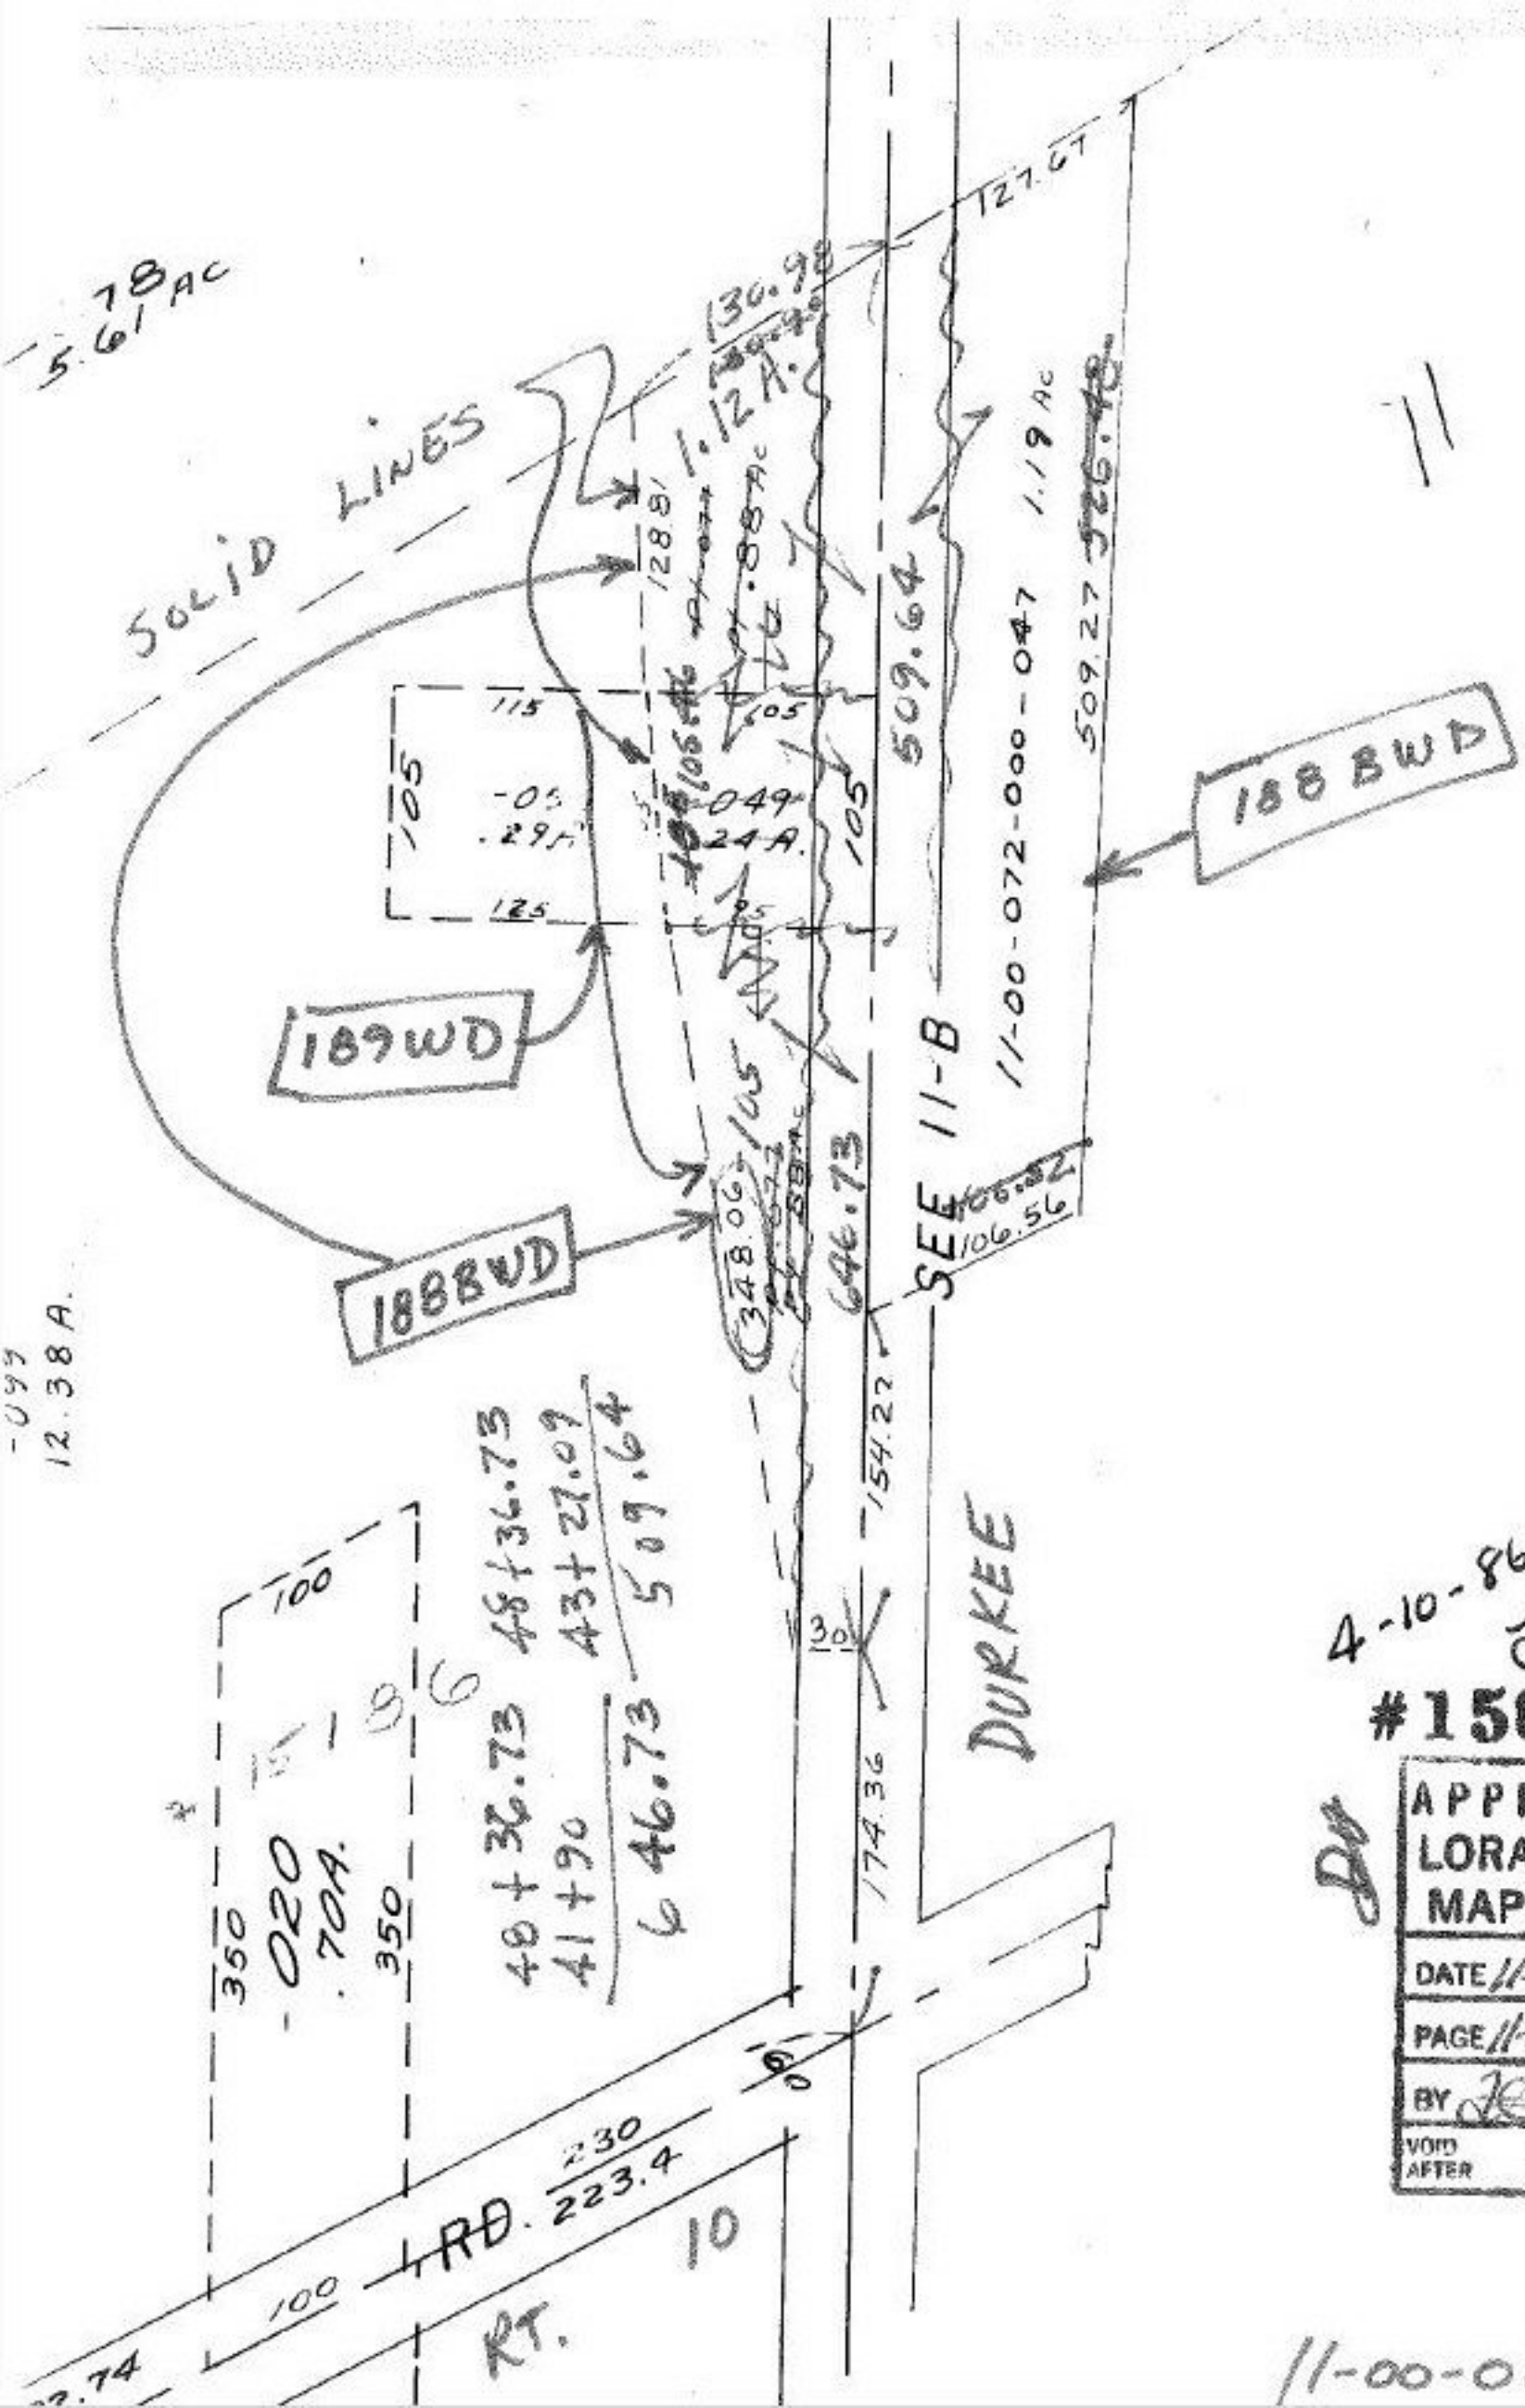

4-10-86

#15881

APPROVED
LORAIN CO.
MAP DEPT.

DATE 11-1-84

PAGE 11-00-089B

BY [signature]

VOID AFTER 15881

11-00-089-B