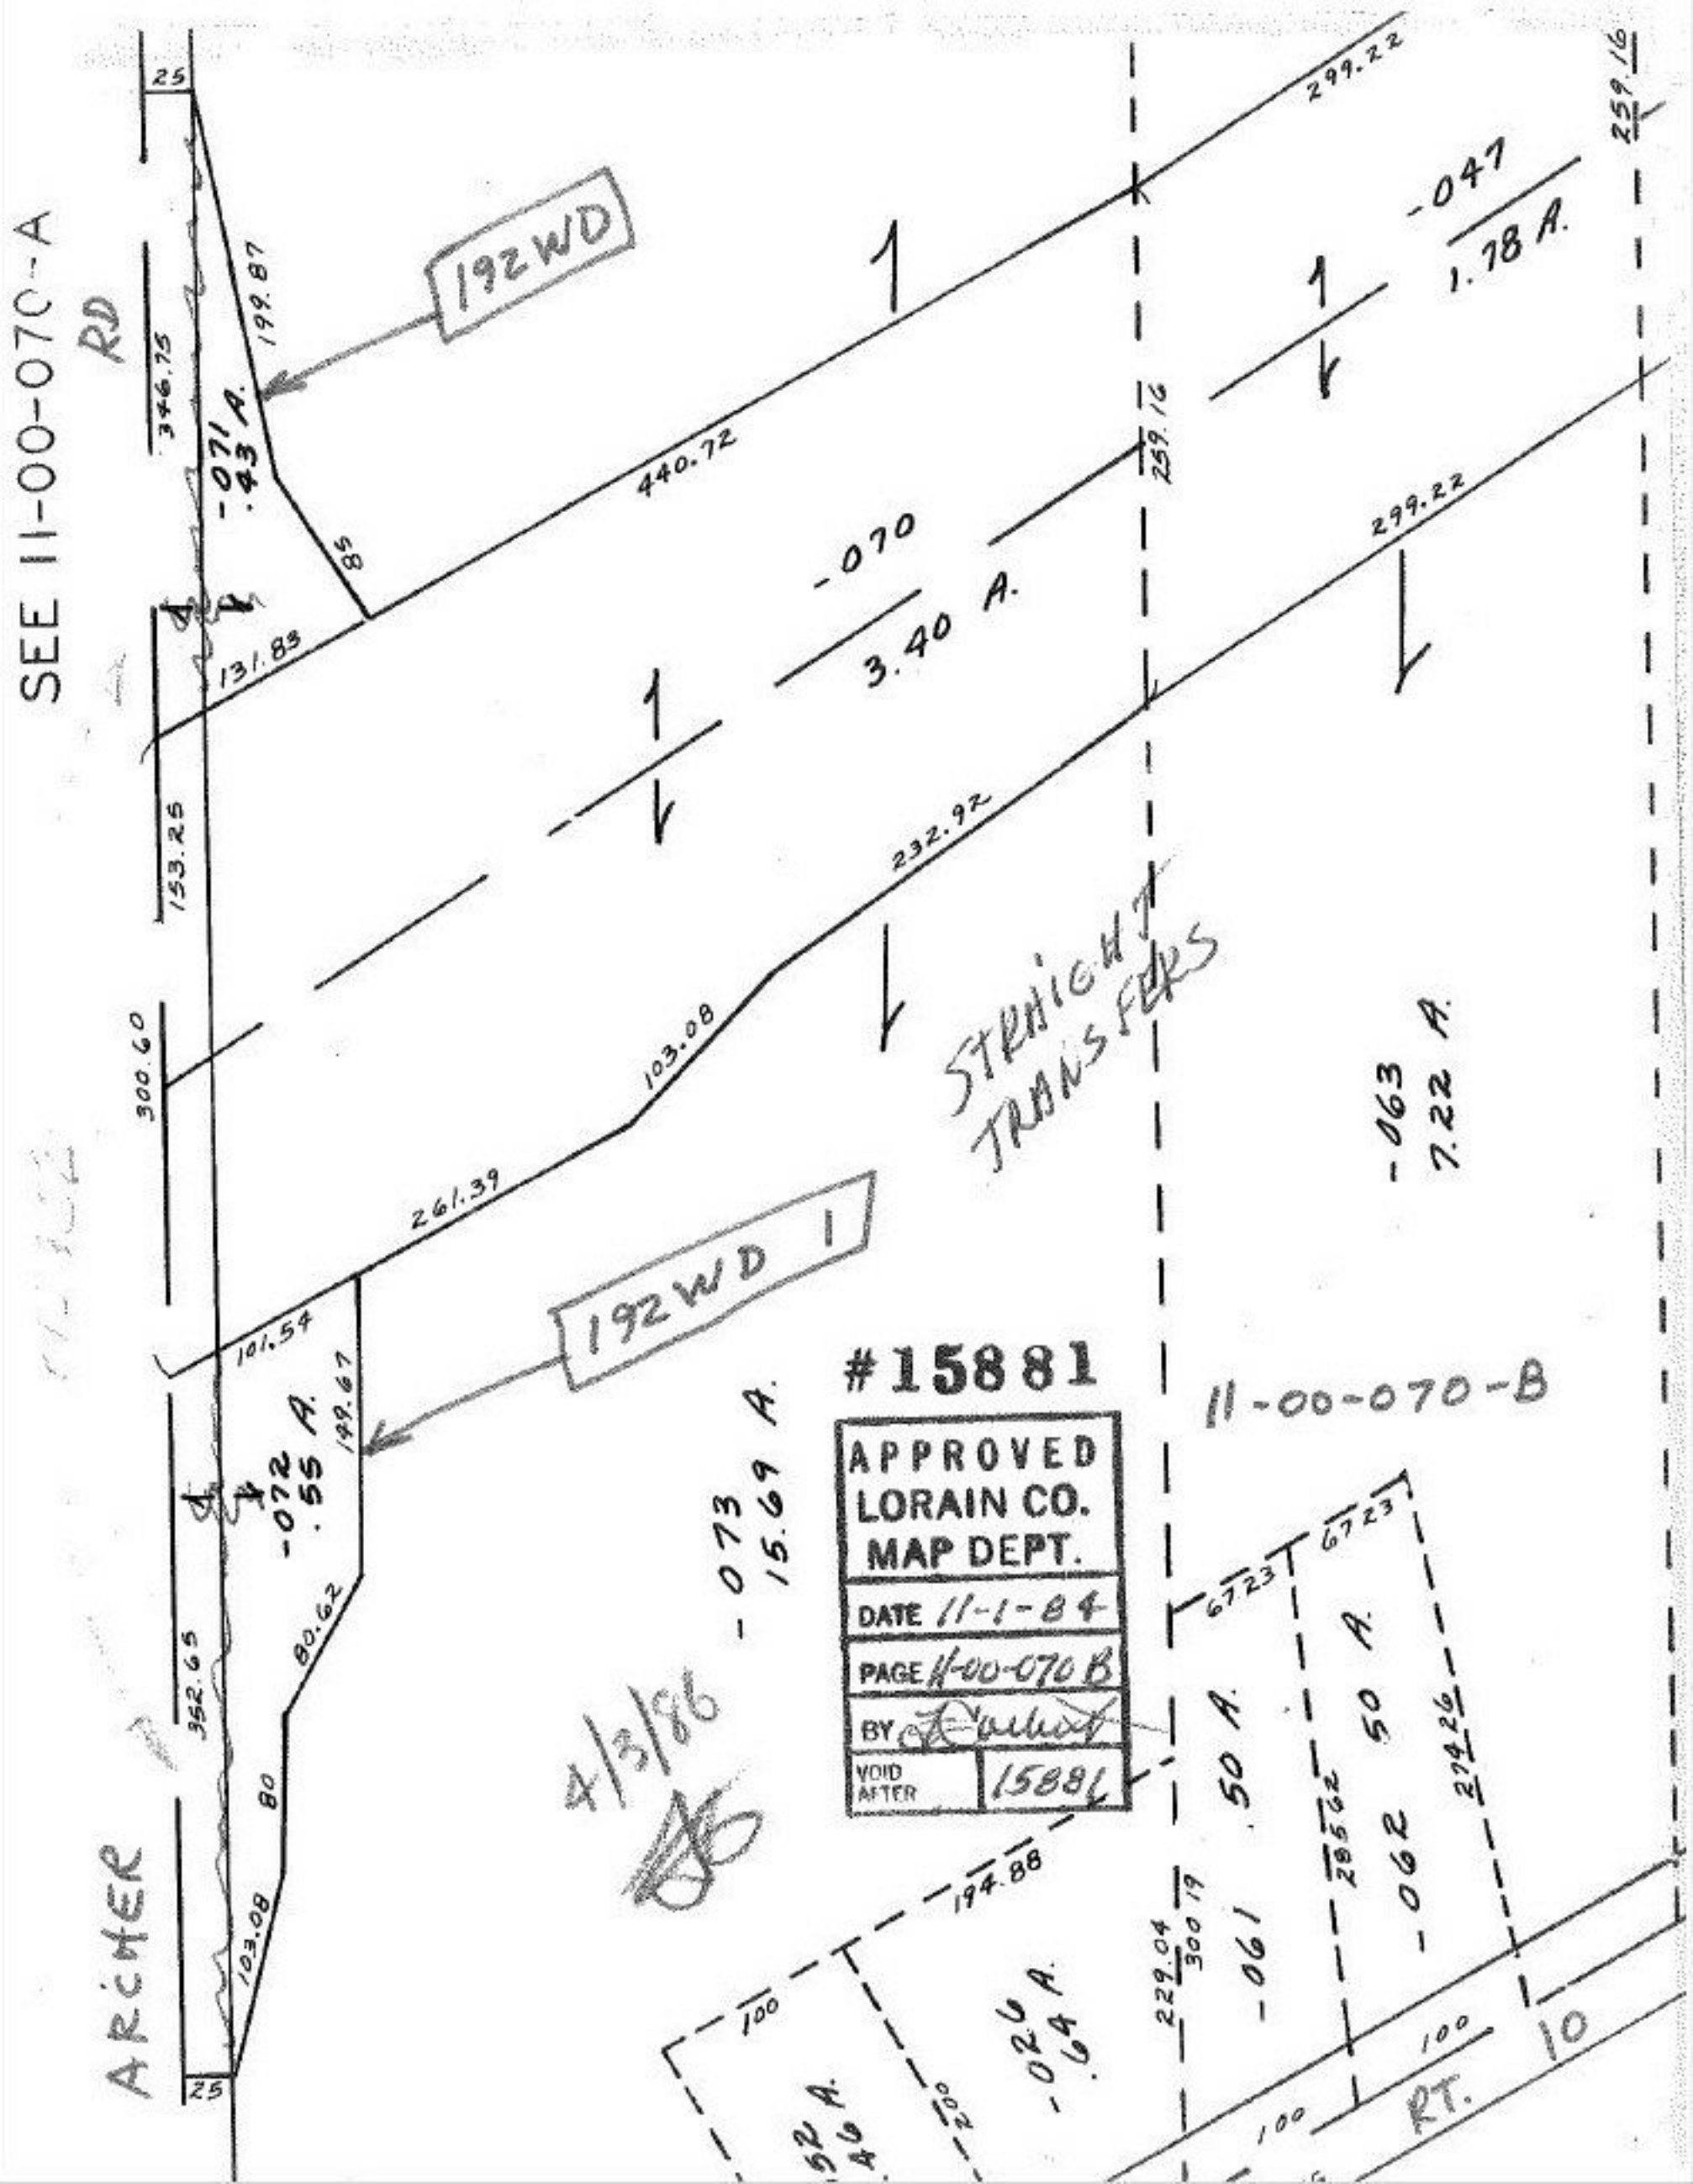
SEE 11-00-070-A
RD
ARCHER
192WD
192WD 1
-071
.43 A.
-070
3.40 A.
-047
1.78 A.
-063
7.22 A.
-072
.55 A.
-073
15.69 A.
-026
.64 A.
-061
.50 A.
-062
.50 A.
STRAIGHT TRANSFERS
11-00-070-B
RT. 10
25
346.75
199.87
85
440.72
131.83
153.25
300.60
261.39
103.08
232.92
299.22
259.16
101.54
149.67
80.62
352.65
80
103.08
25
67.23
67.23
194.88
100
200
229.04
300.19
285.62
274.26
100
100
#15881
APPROVED
LORAIN CO.
MAP DEPT.
DATE 11-1-84
PAGE 11-00-070 B
BY
VOID AFTER 15881
4/3/86