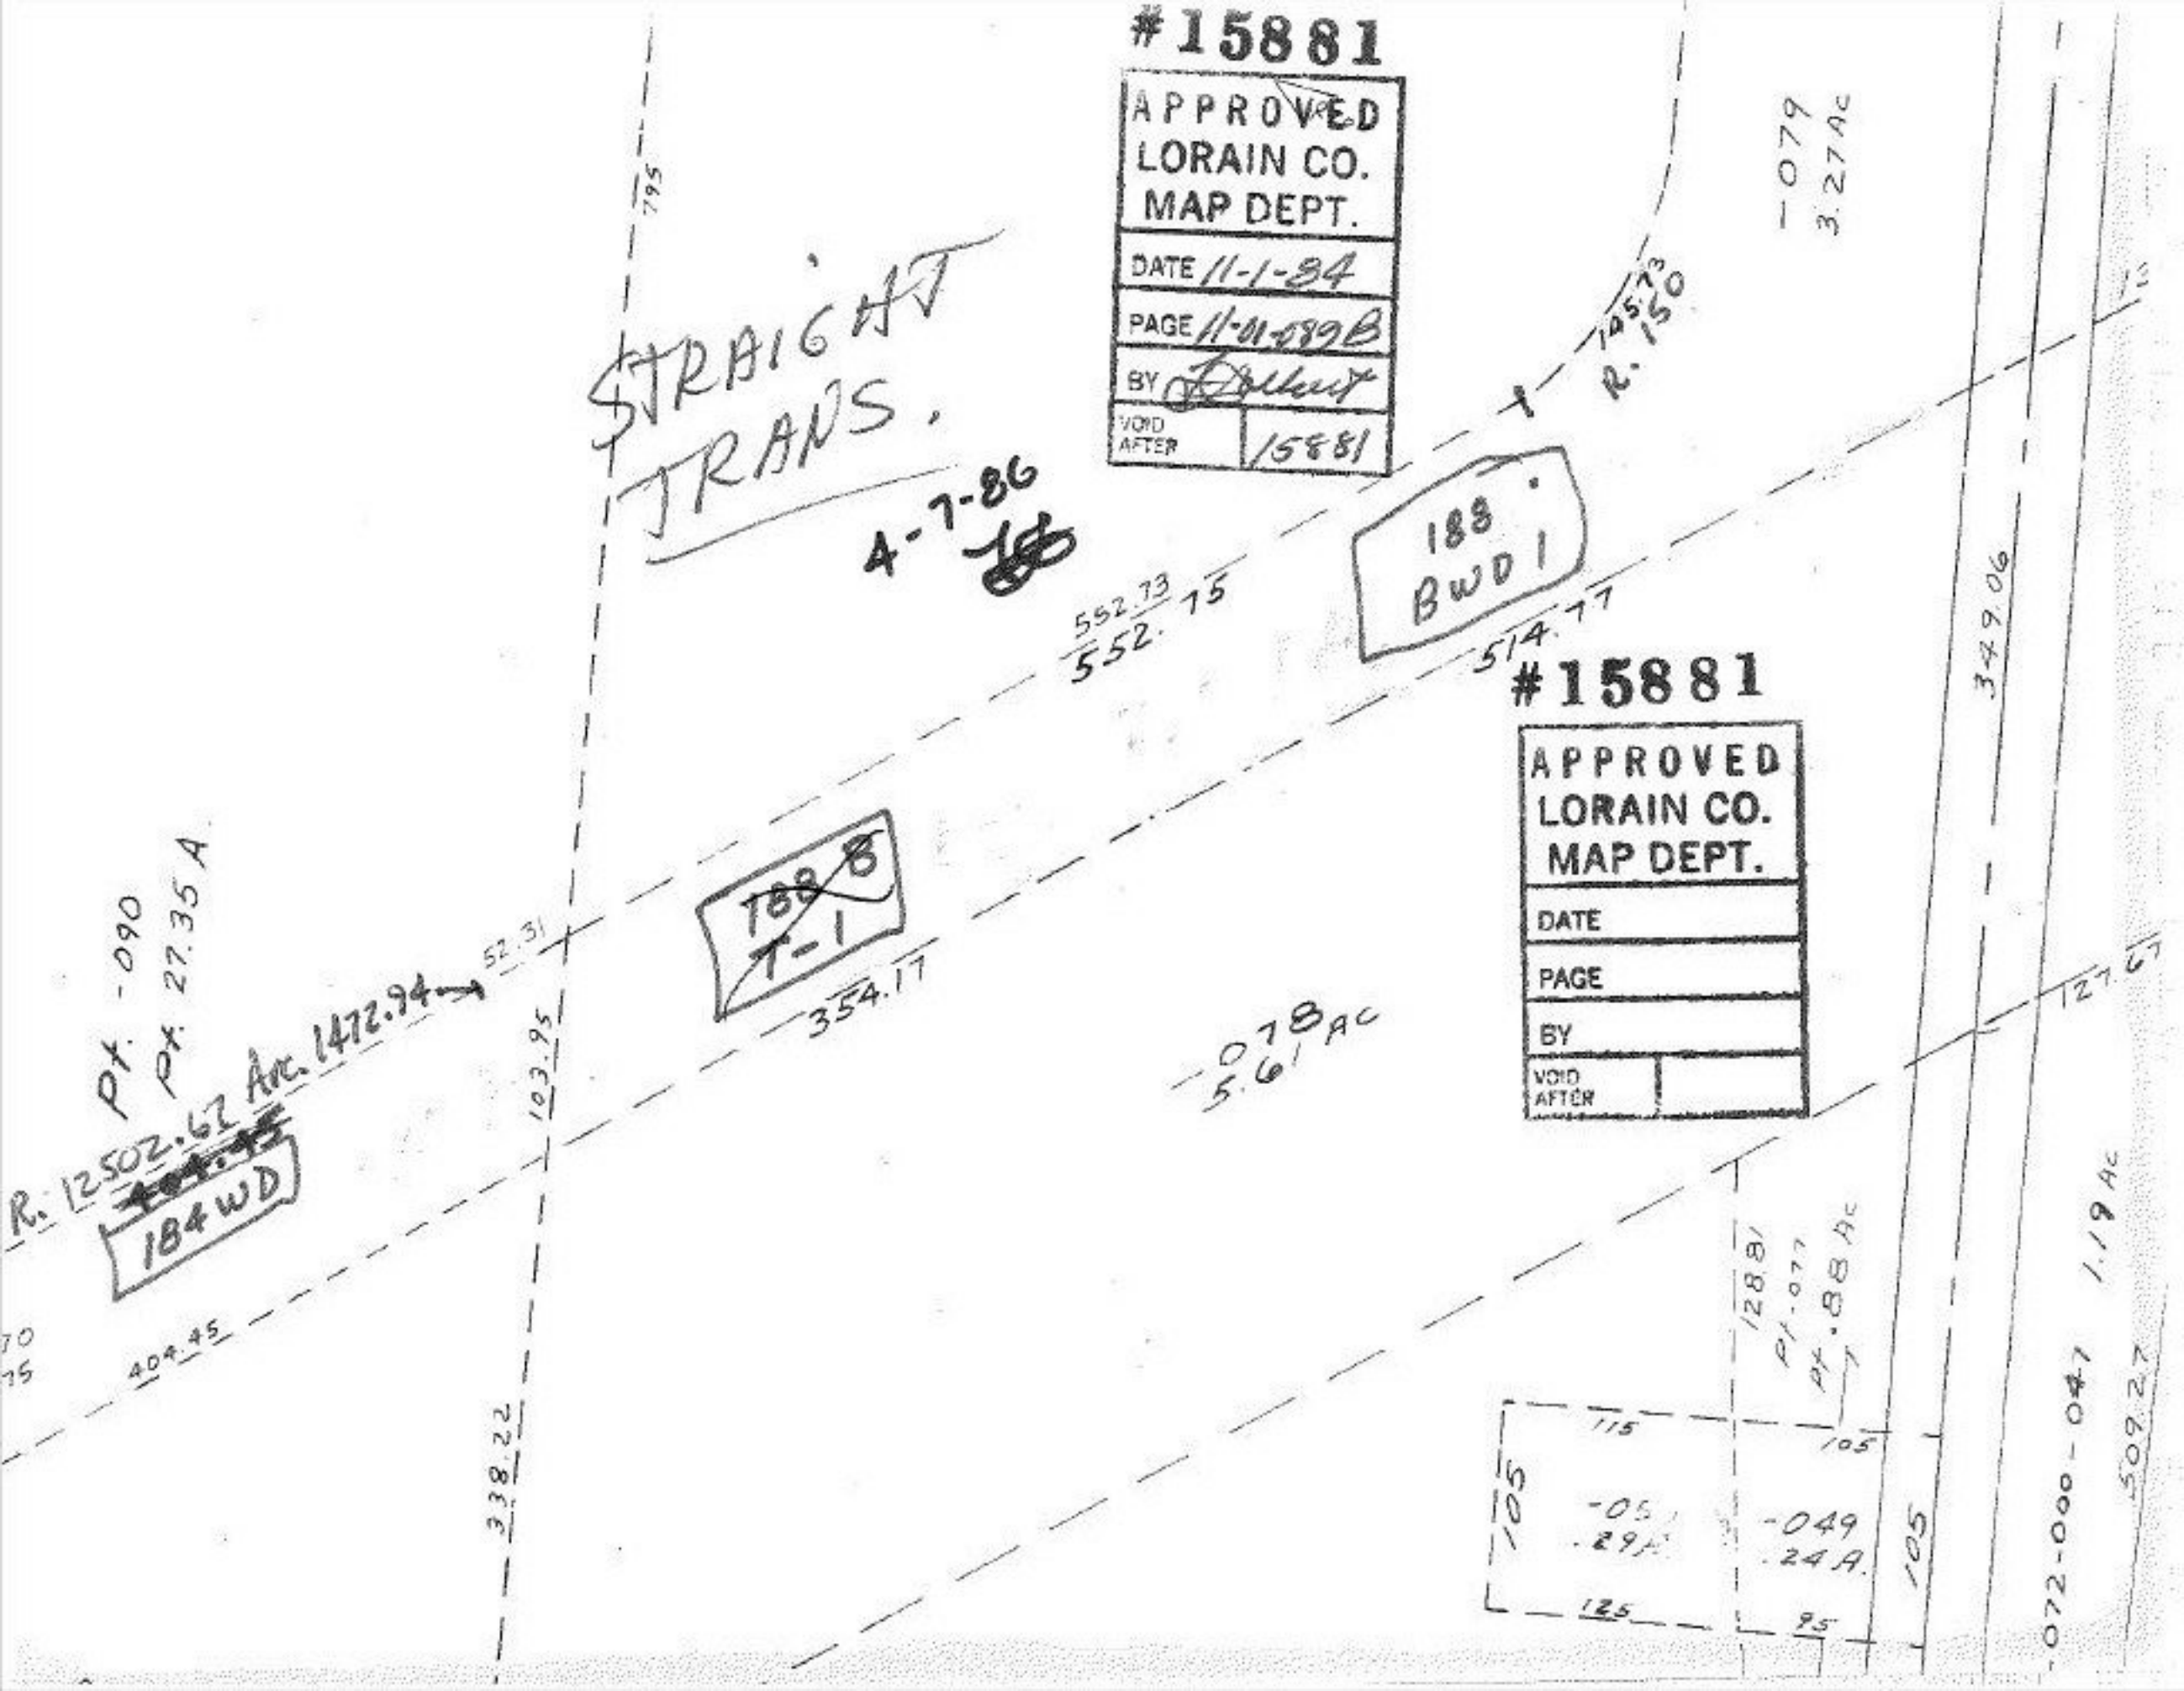

#15881
APPROVED
LORAIN CO.
MAP DEPT.
DATE 11-1-84
PAGE 11-01-089B
BY
VOID AFTER 15881
STRAIGHT TRANS.
4-7-86
188 BWD 1
#15881
APPROVED
LORAIN CO.
MAP DEPT.
DATE
PAGE
BY
VOID AFTER
188 B T-1
184 WD
R. 12502.67 Arc. 1472.94
Pt. -090
Pt. 27.35 A
-079
3.27 Ac
145.73
R. 150
552.73
552.75
514.77
354.17
52.31
103.95
404.45
338.22
-078
5.61 AC
349.06
127.67
128.81
Pt. -077
Pt. .88 Ac
1.19 Ac
-072-000-047
509.27
115
105
-05
.29 A
-049
.24 A
125
95