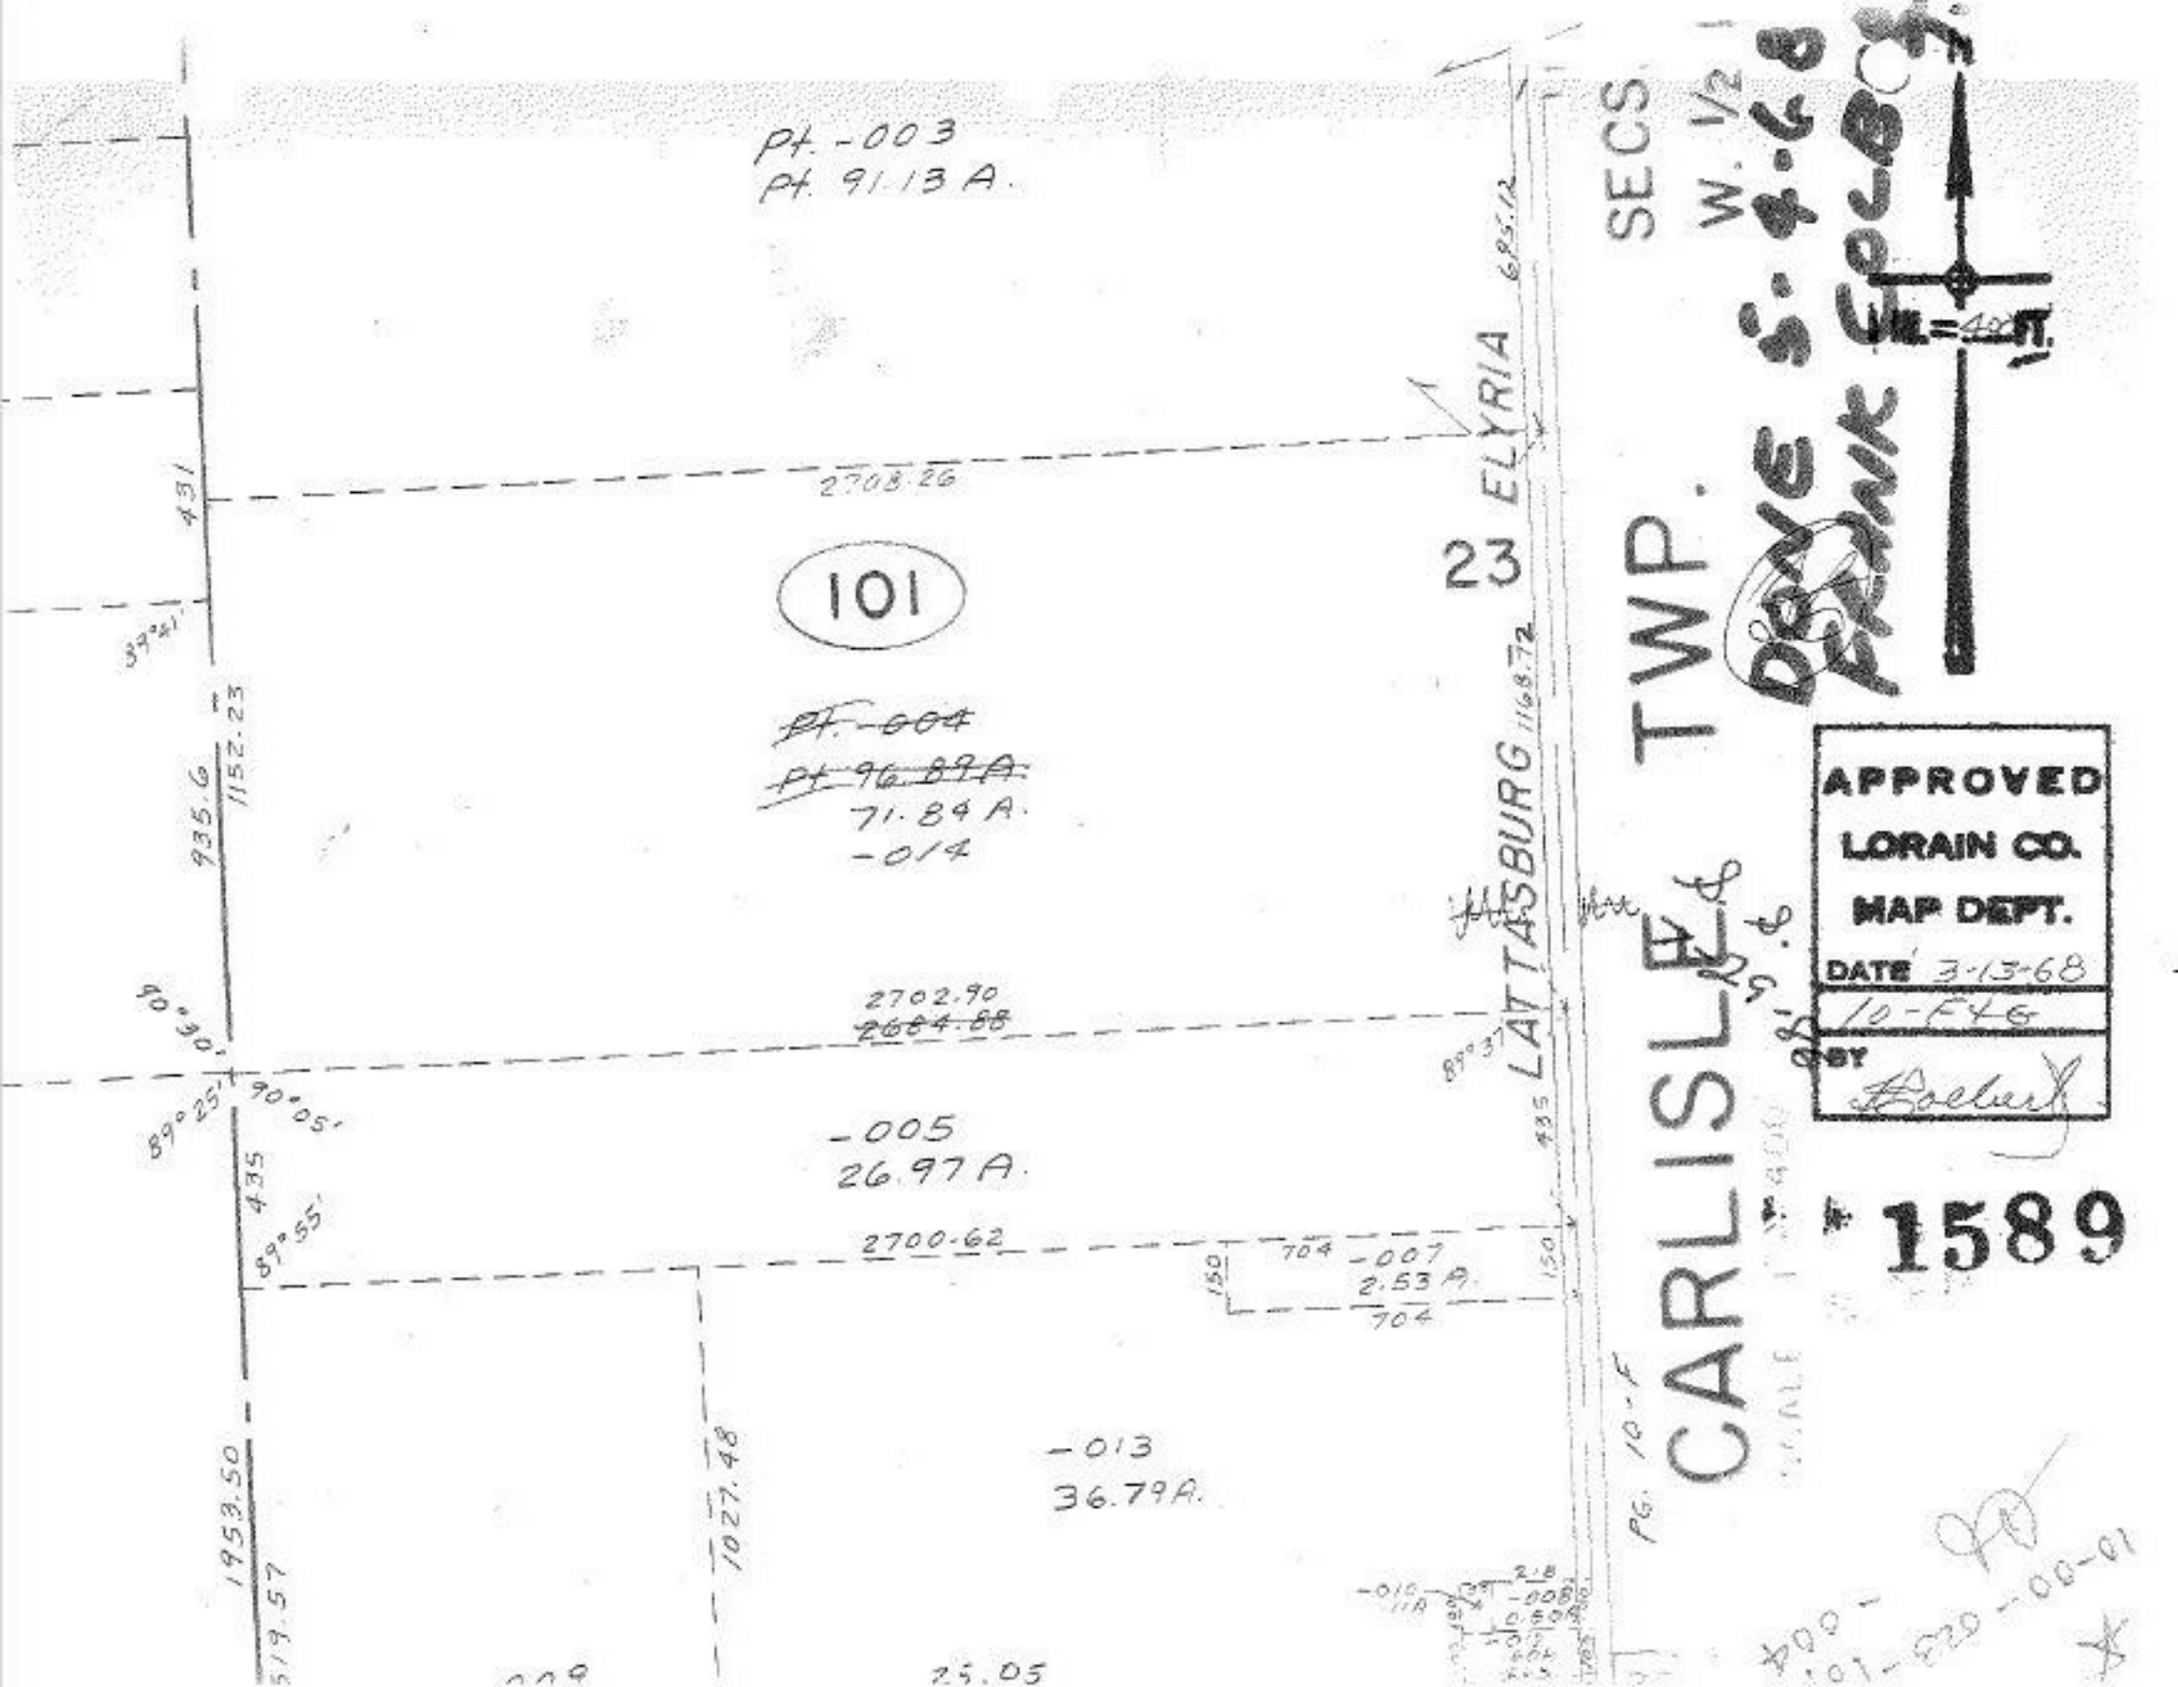
Pt. -003
Pt. 91.13 A.
2708.26
101
Pt. -004
Pt. 96.89 A.
71.84 A.
-014
935.6
1152.23
431
39°41'
40°0'
2702.90
2684.68
89°25'
90°05'
89°55'
435
-005
26.97 A.
2700.62
704
-007
2.53 A.
704
150
150
-013
36.79A.
1953.50
519.57
1027.48
25.05
SECS
W. 1/2
23
ELYRIA
LATTASBURG
1168.72
685.12
435
89°3
CARLISLE TWP.
PG. 10-F
DRIVE
PARK
1" = 400 FT.
APPROVED
LORAIN CO.
MAP DEPT.
DATE 3-13-68
10-F46
BY
1589